
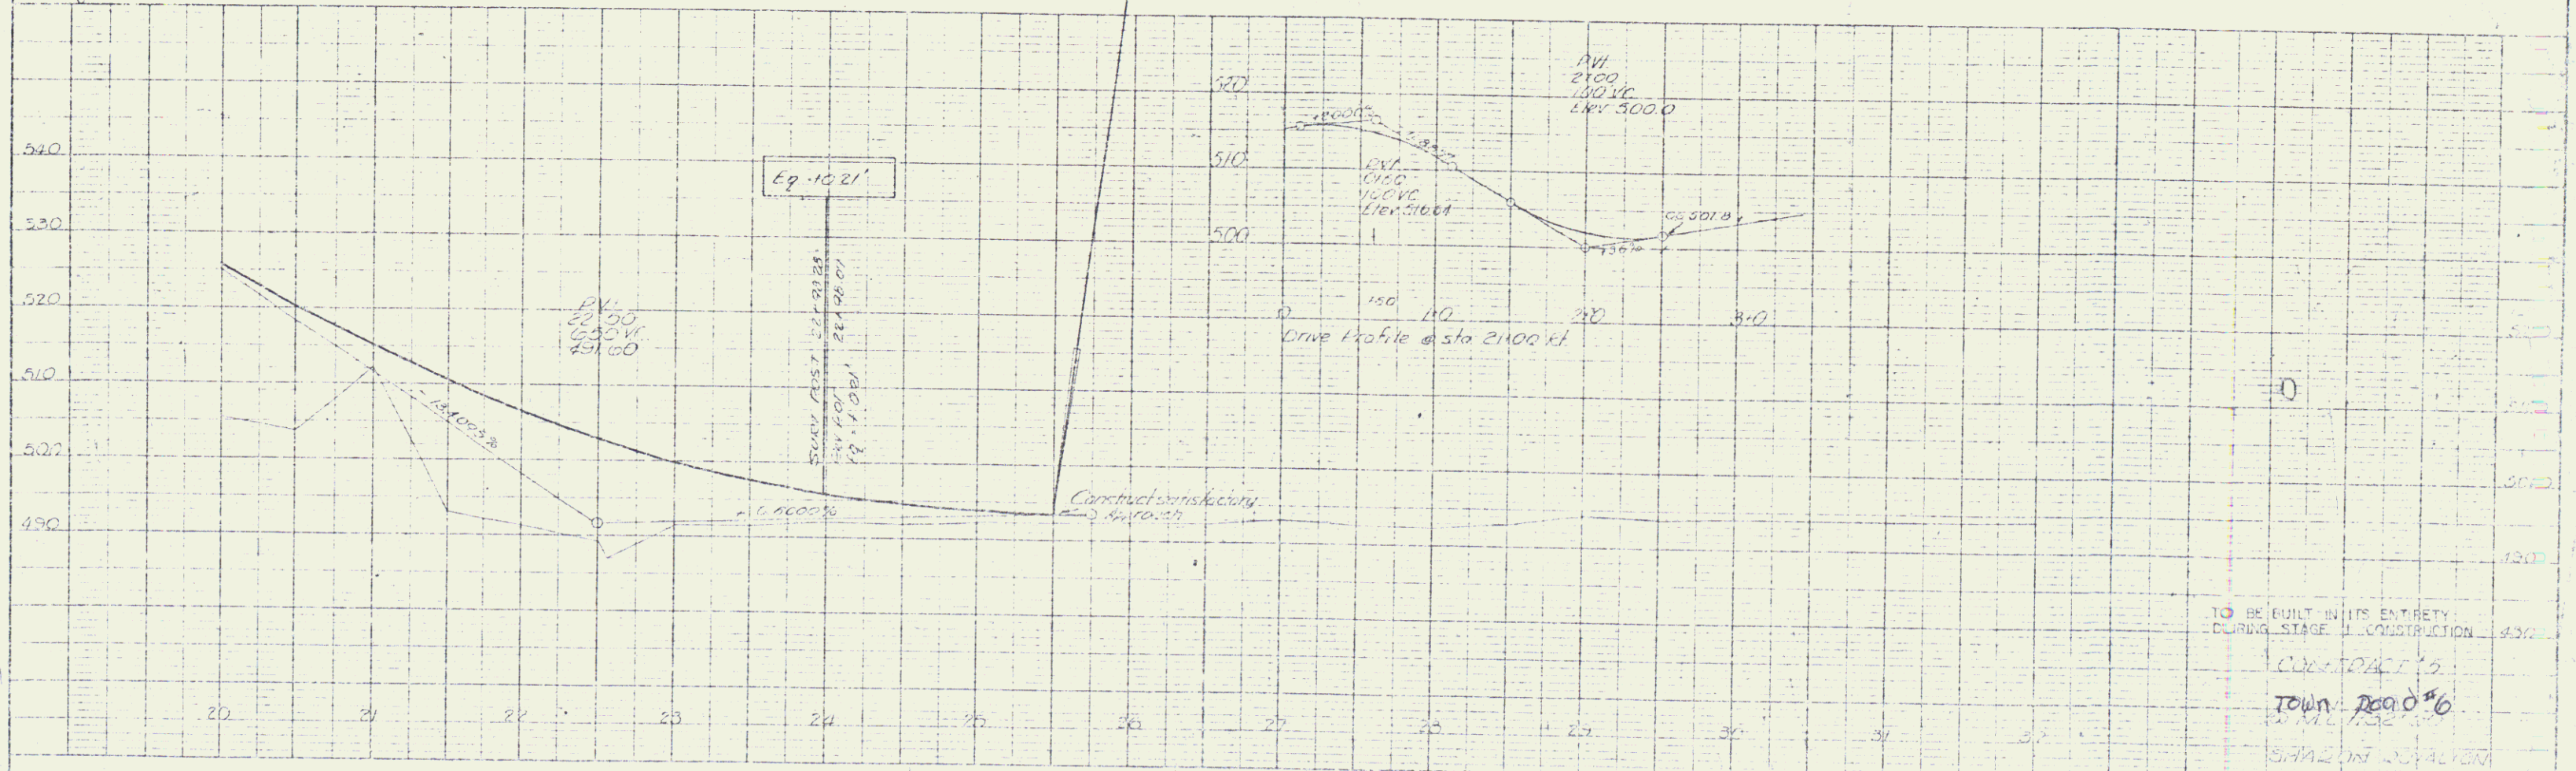


TWO CABLE GUARD RAIL
ITEM 571
20+00 - 20+72 CL
21+07 - 23+04 CL
SPECIAL DITCH
ITEM 106A
21+75 - 22+00 CL

Rev Curve Data
Δ 43° 21' 22" Lt
L 517.10'
T 227.75'
L 433.50'
E 43.61'
Ch. 2, 1A

CONSTRUCT DRIVE
21+00 Rt

WOOD GUIDE POSTS ITEM 547A
0+35 - 1+15 dr - Lt

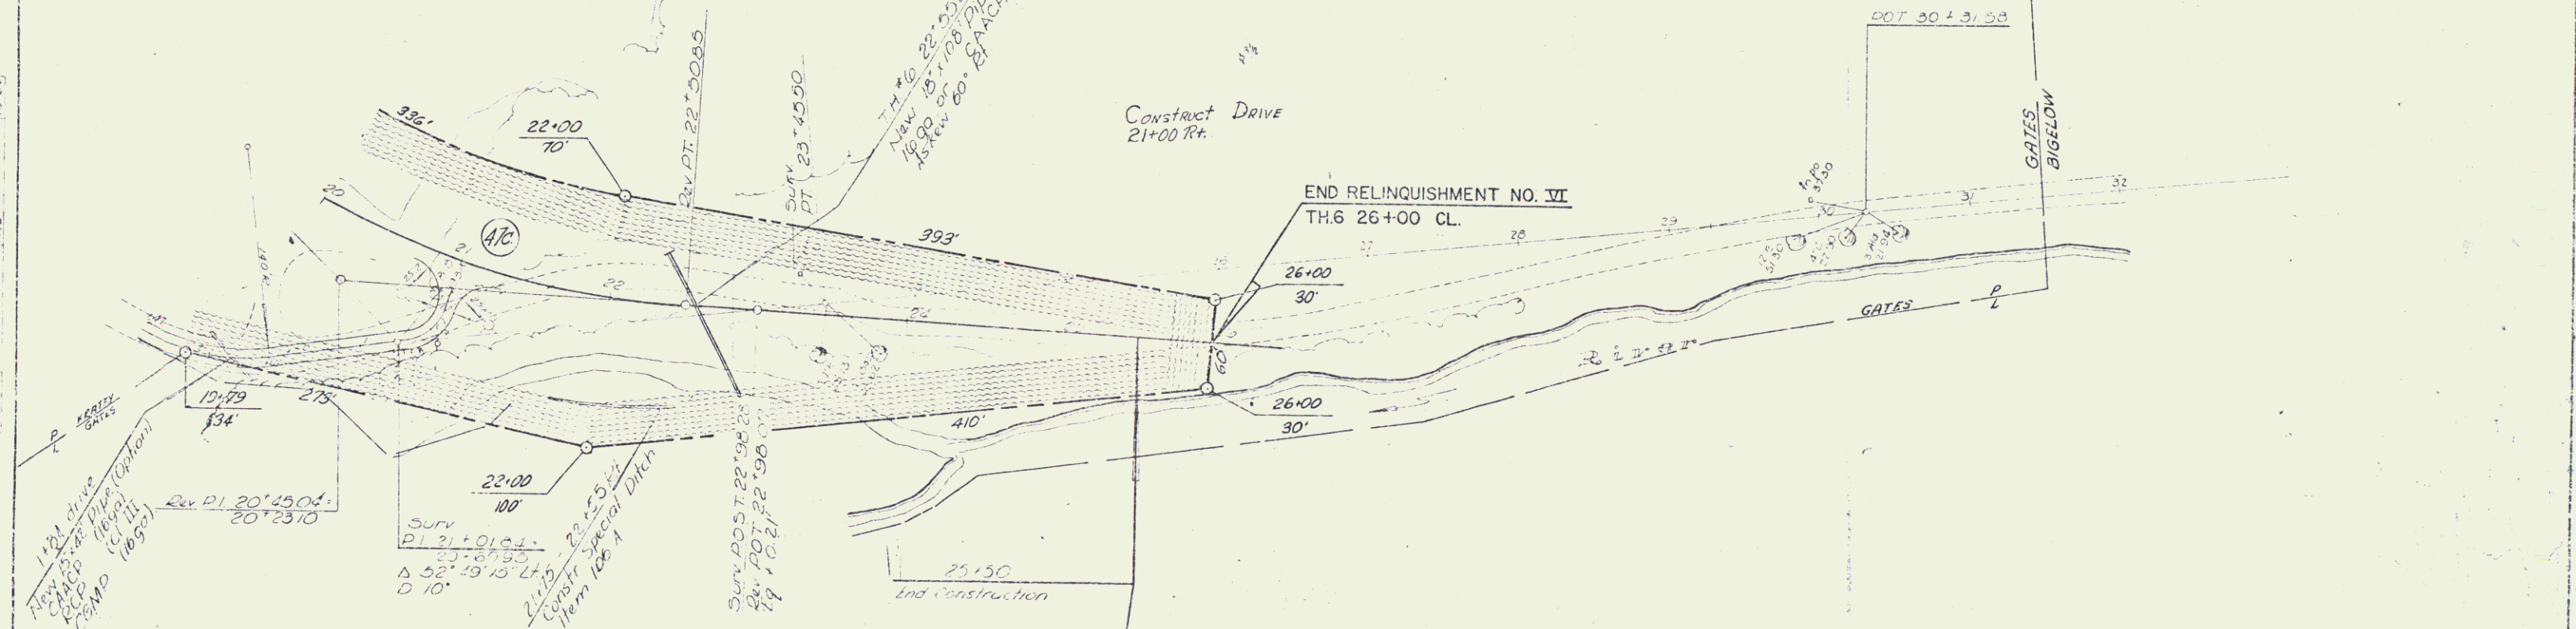

TO BE BUILT IN ITS ENTIRETY
DURING STAGE II CONSTRUCTION
CURE TO 140'S
TOWN ROAD #6
SHALL NOT BE AFFECTED
37