


1193+00 CB L - 1193+90 SB L  
 Three Chain Guards 20' in. Steel Posts, Item 542  
 1193+00 CB L - 1193+20 CB L  
 Stone for Road Protection, Item 543  
 1193+44.17 - 1193+55.14 SB L  
 Bit Conc. Pavement, Item 544  
 1193+50.14 - 1194+20 SB L

Property Line Fence with Steel Posts, Item 543-II  
 1194+70 SB L - 1193+00 SB L  
 1193+00 NB L - 1193+00 NB L

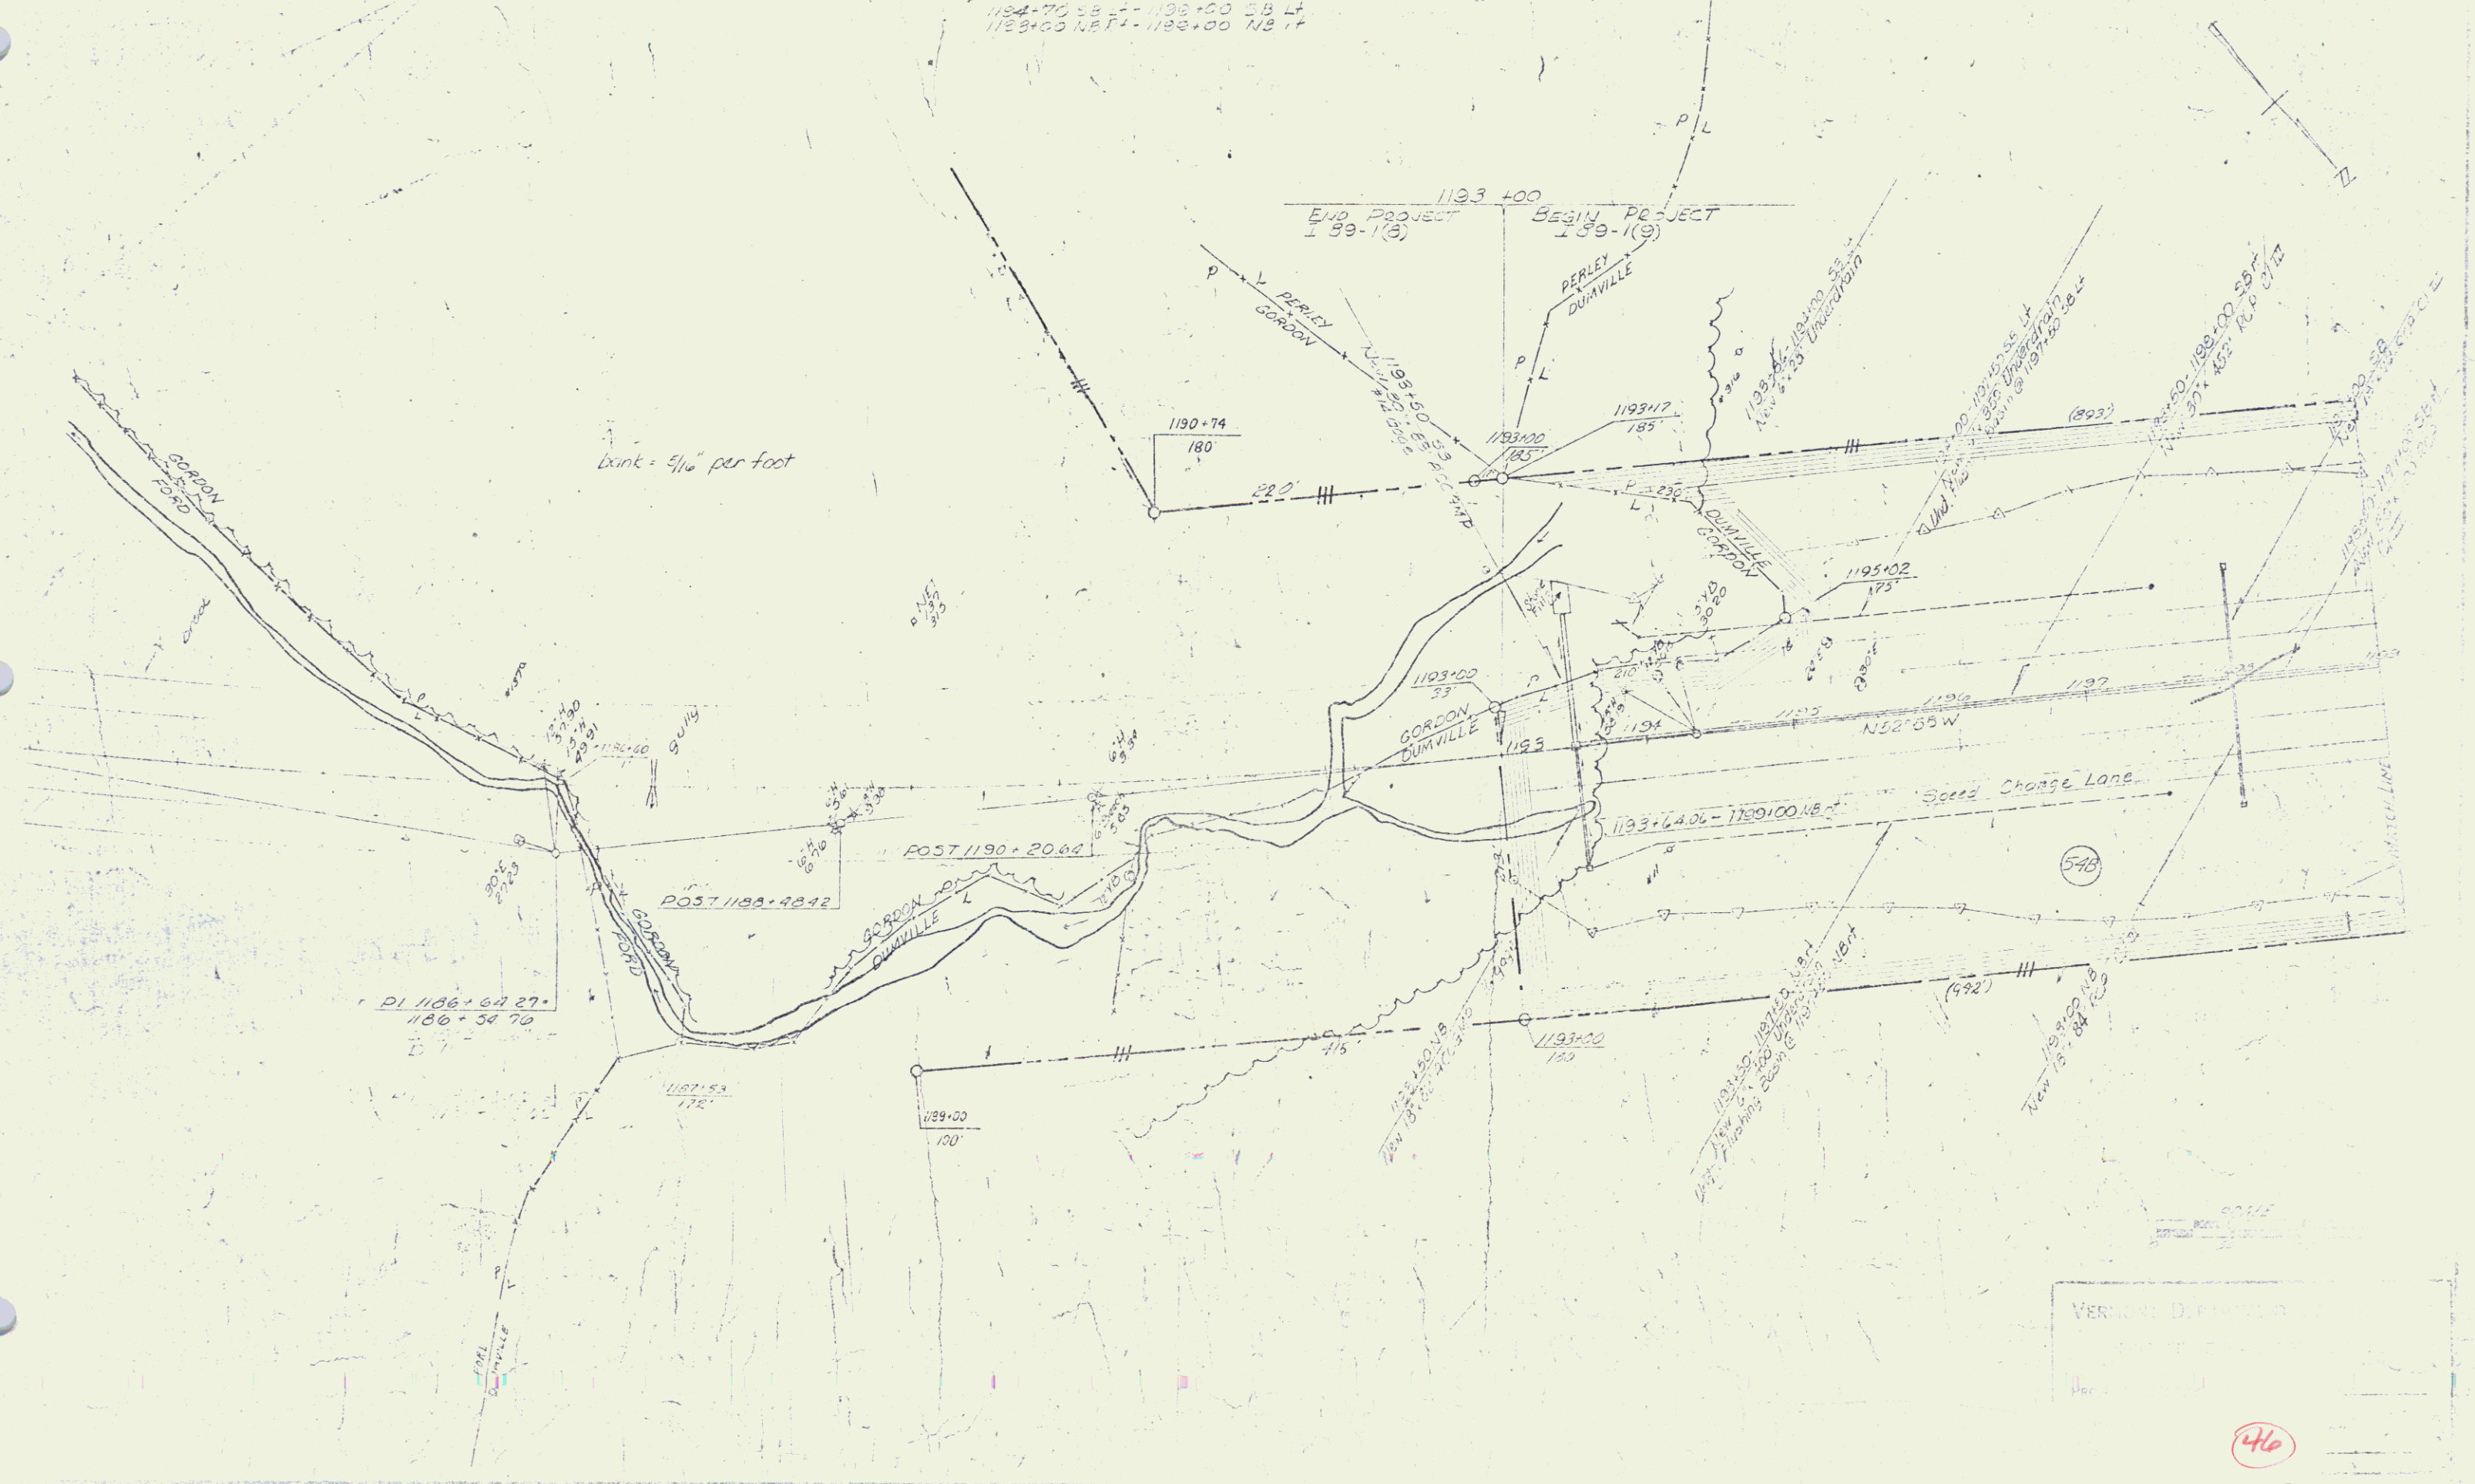

Slope = 5/16 per foot

DI 1186+64 27'  
 1186+58 70'  
 D 1

POST 1190+20.62

POST 1189+48.42

VERIFICATION  
 SHEET NO. 46  
 SHEET 46