
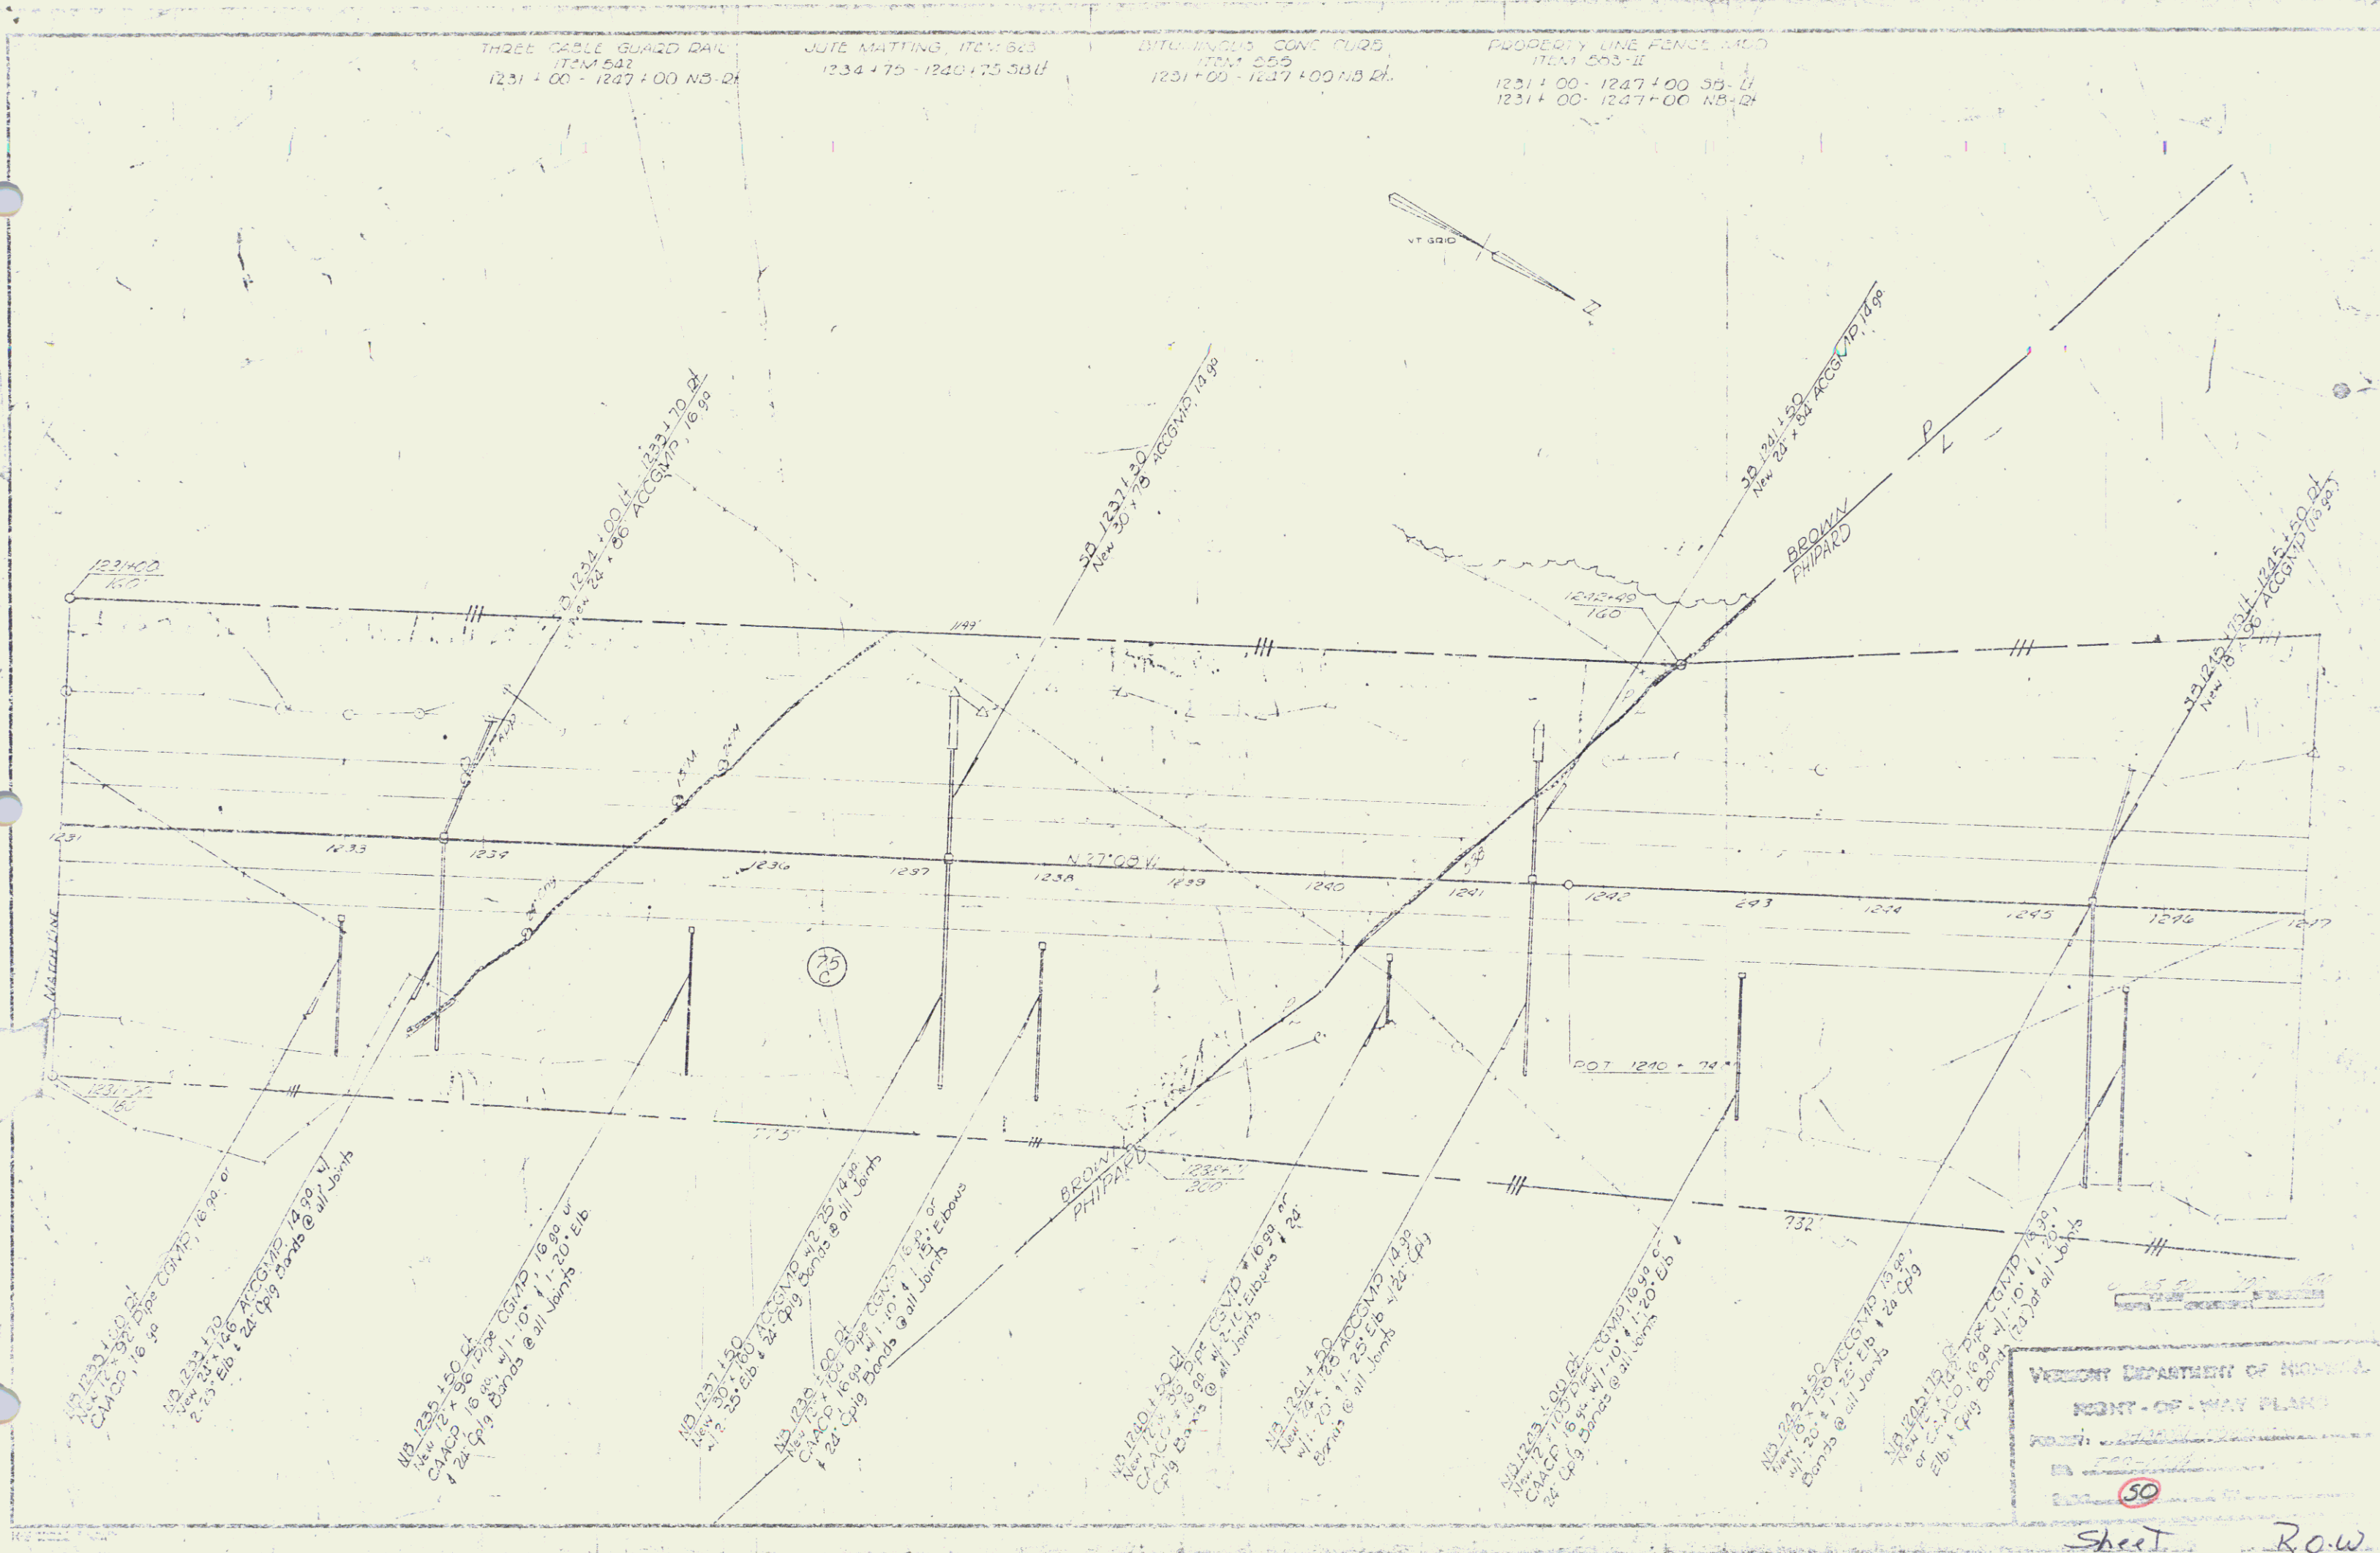


THREE CABLE GUARD RAIL
ITEM 582
1231+00 - 1247+00 NB-24

JUTE MATTING, ITEM 625
1234+75 - 1240+75 SB-1

BITUMINOUS CONC CURB
ITEM 555
1231+00 - 1237+00 NB-24

PROPERTY LINE FENCE AND
ITEM 583-11
1231+00 - 1247+00 SB-1
1231+00 - 1247+00 NB-24

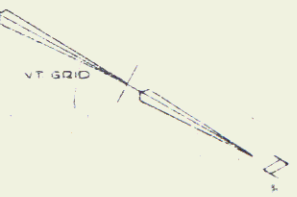

VERMONT DEPARTMENT OF HIGHWAYS
RIGHT-OF-WAY PLAN
Scale: 1" = 40'
Sheet 50
ROW 64