


SUB-BASE OF SAND, ITEM 202
SB 732+00 - 735+00
NB 732+00 - 735+00

PROPERTY LINE FENCE, ITEM 553-II
SB 732+00 - 735+00 RL
NB 732+00 - 735+00 RL

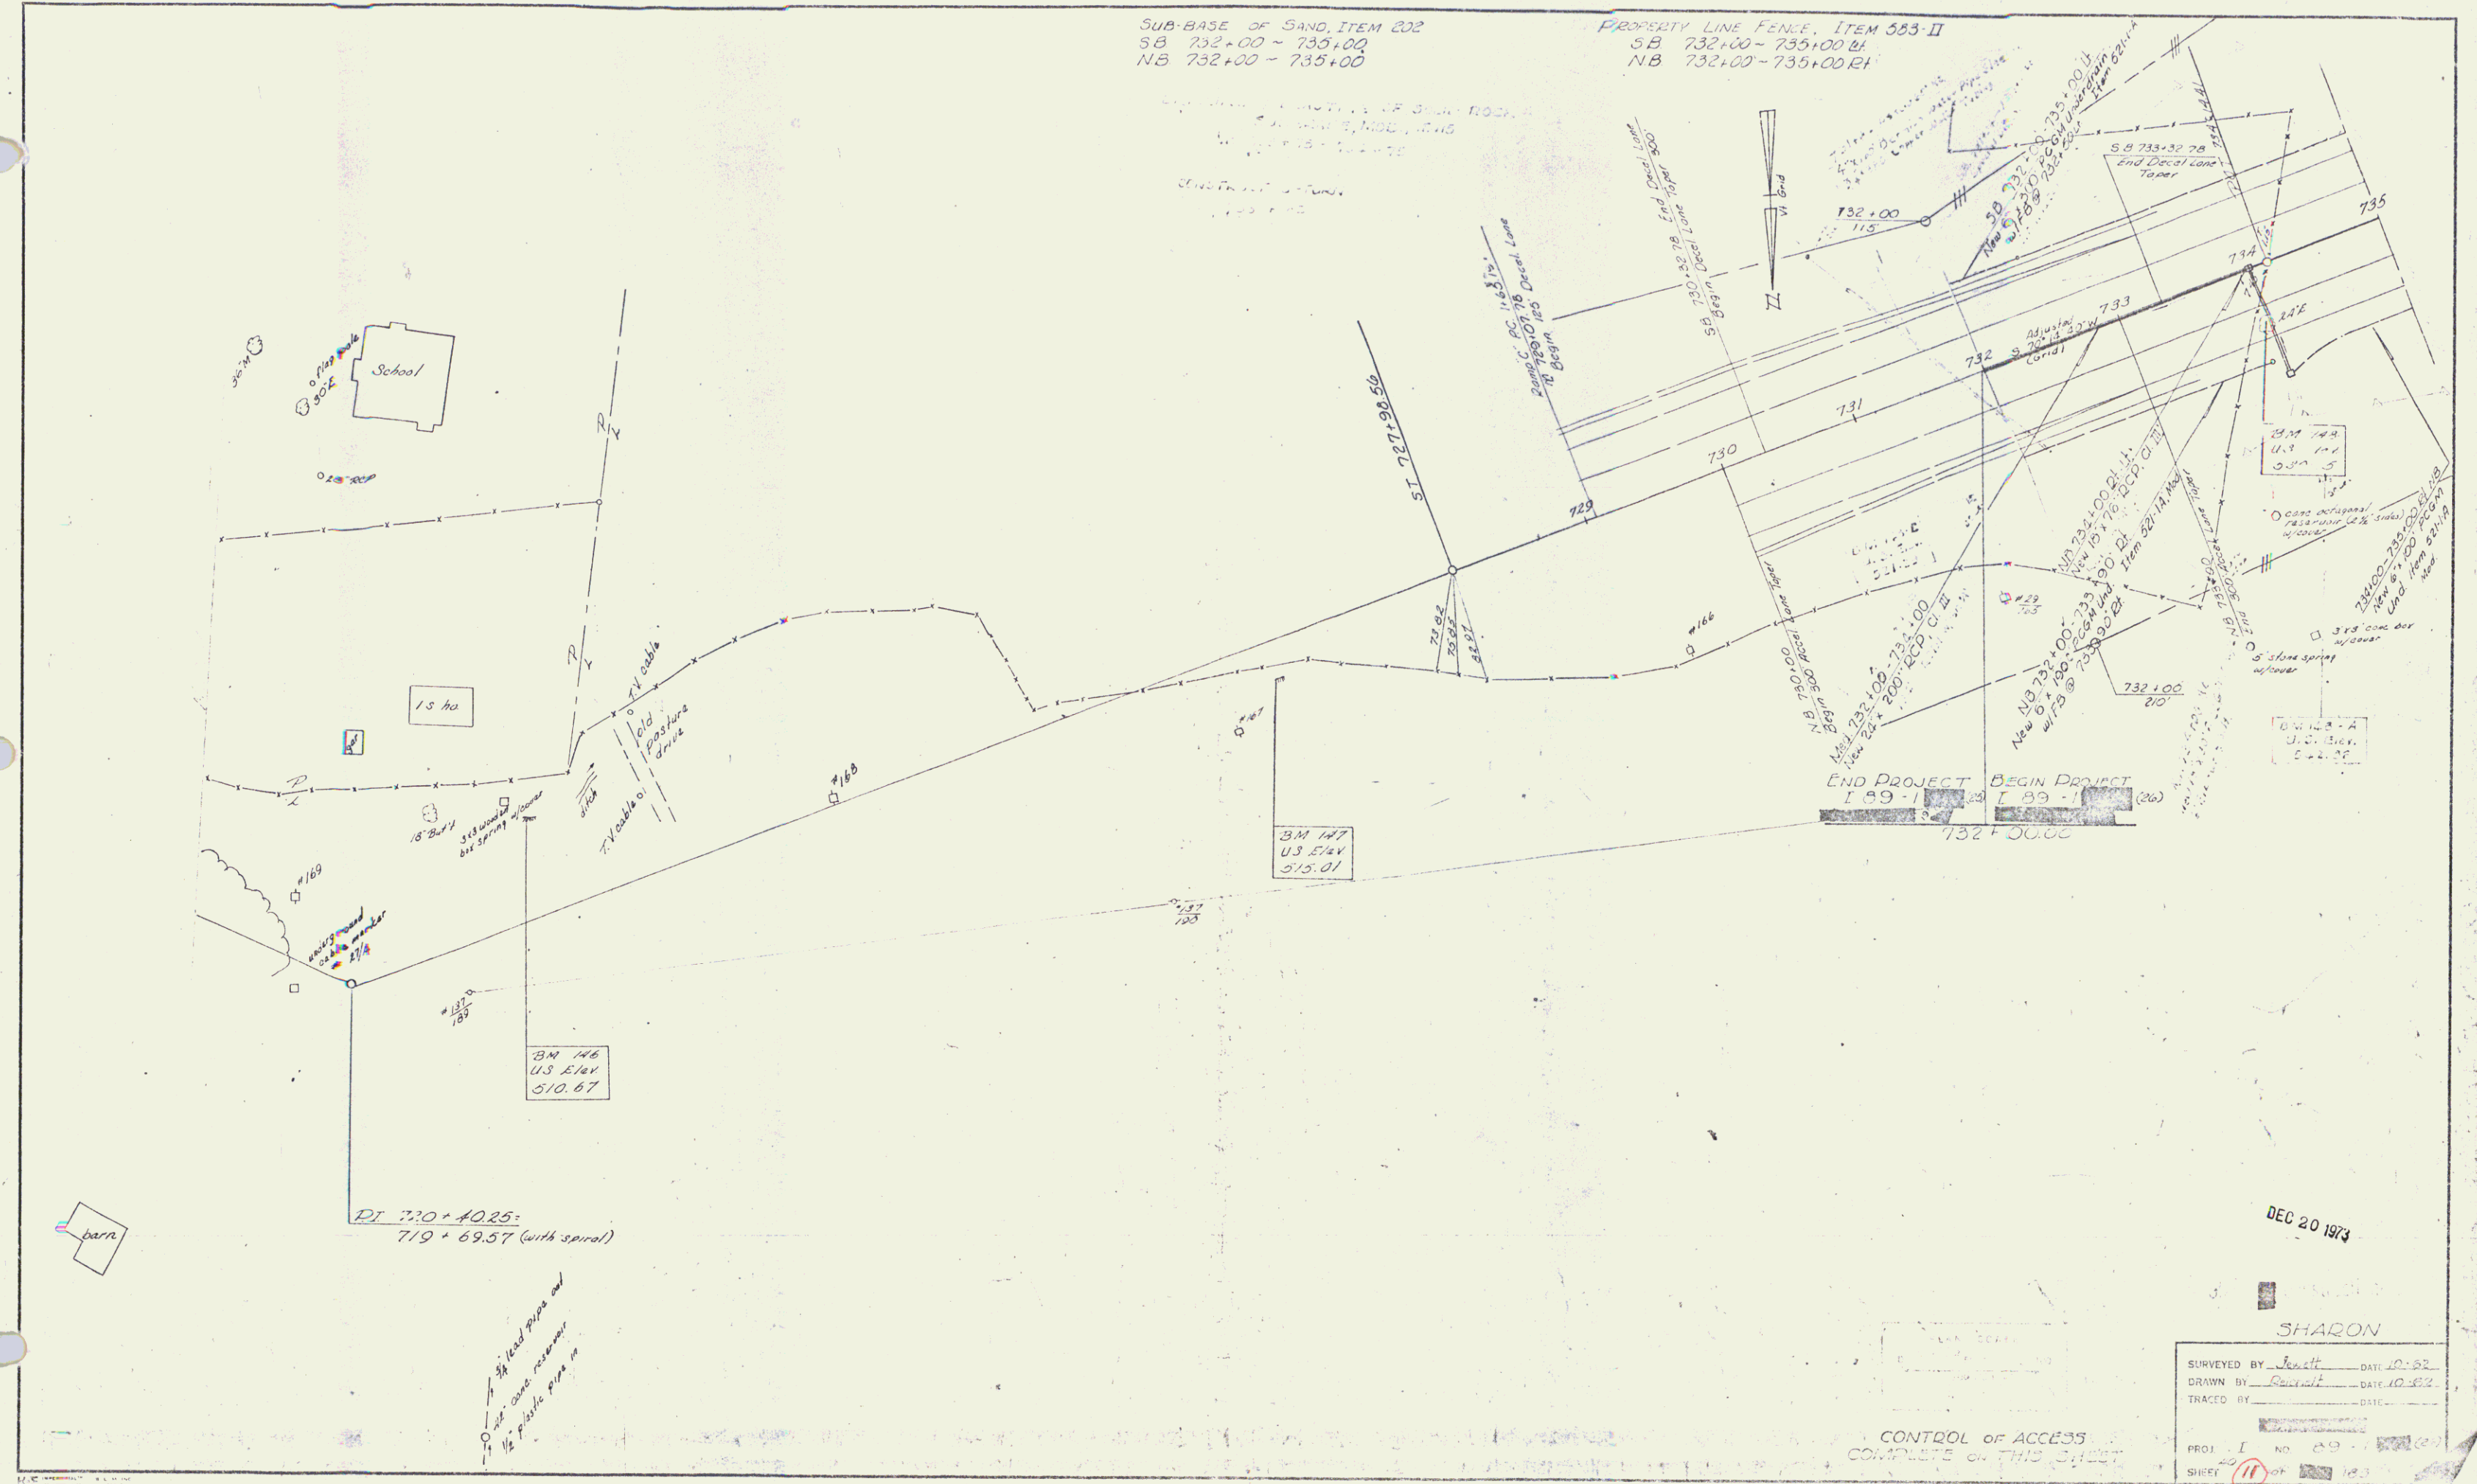

END PROJECT BEGIN DRAIN
732+00.00

DEC 20 1974

SHARON

SURVEYED BY Janett DATE 10-82
DRAWN BY General DATE 10-82
TRACED BY _____ DATE _____

CONTROL OF ACCESS
COMPLETE ON THIS SHEET

PROJ. I NO. 29
SHEET 11 OF 18.3

Sheet

67