


* THREE CABLE GUARD RAIL w/
LIGHT STEEL POSTS, ITEM 538
NB 831+00 - 841+00 LF
NB 843+68 - 847+00 LF
SB 843+26 - 843+02 LF
SB 831+00 - 832+24 LF

* TREATED TIMBER CURB
ITEM 538
NB 831+00 - 840+00 LF

GRAVEL BACKFILL, ITEM 222-A
SB 845+25 - 847+00 LF

PROPERTY LINE FENCE w/STEEL POSTS
ITEM 530 LF
SB 831+00 - 847+00 LF
NB 831+00 - 847+00 LF
Near Property Line Fence @ 831+00 - 847+00
Rt/Lt to be constructed prior to com-
mencement of other work in this area

4 SUBBASE OF SAND
ITEM 202
SB 833+25 - 837+00
SB 833+00 - 841+00
SB 846+00 - 847+00
NB 833+50 - 842+02 LF
NB 846+72 - 847+00

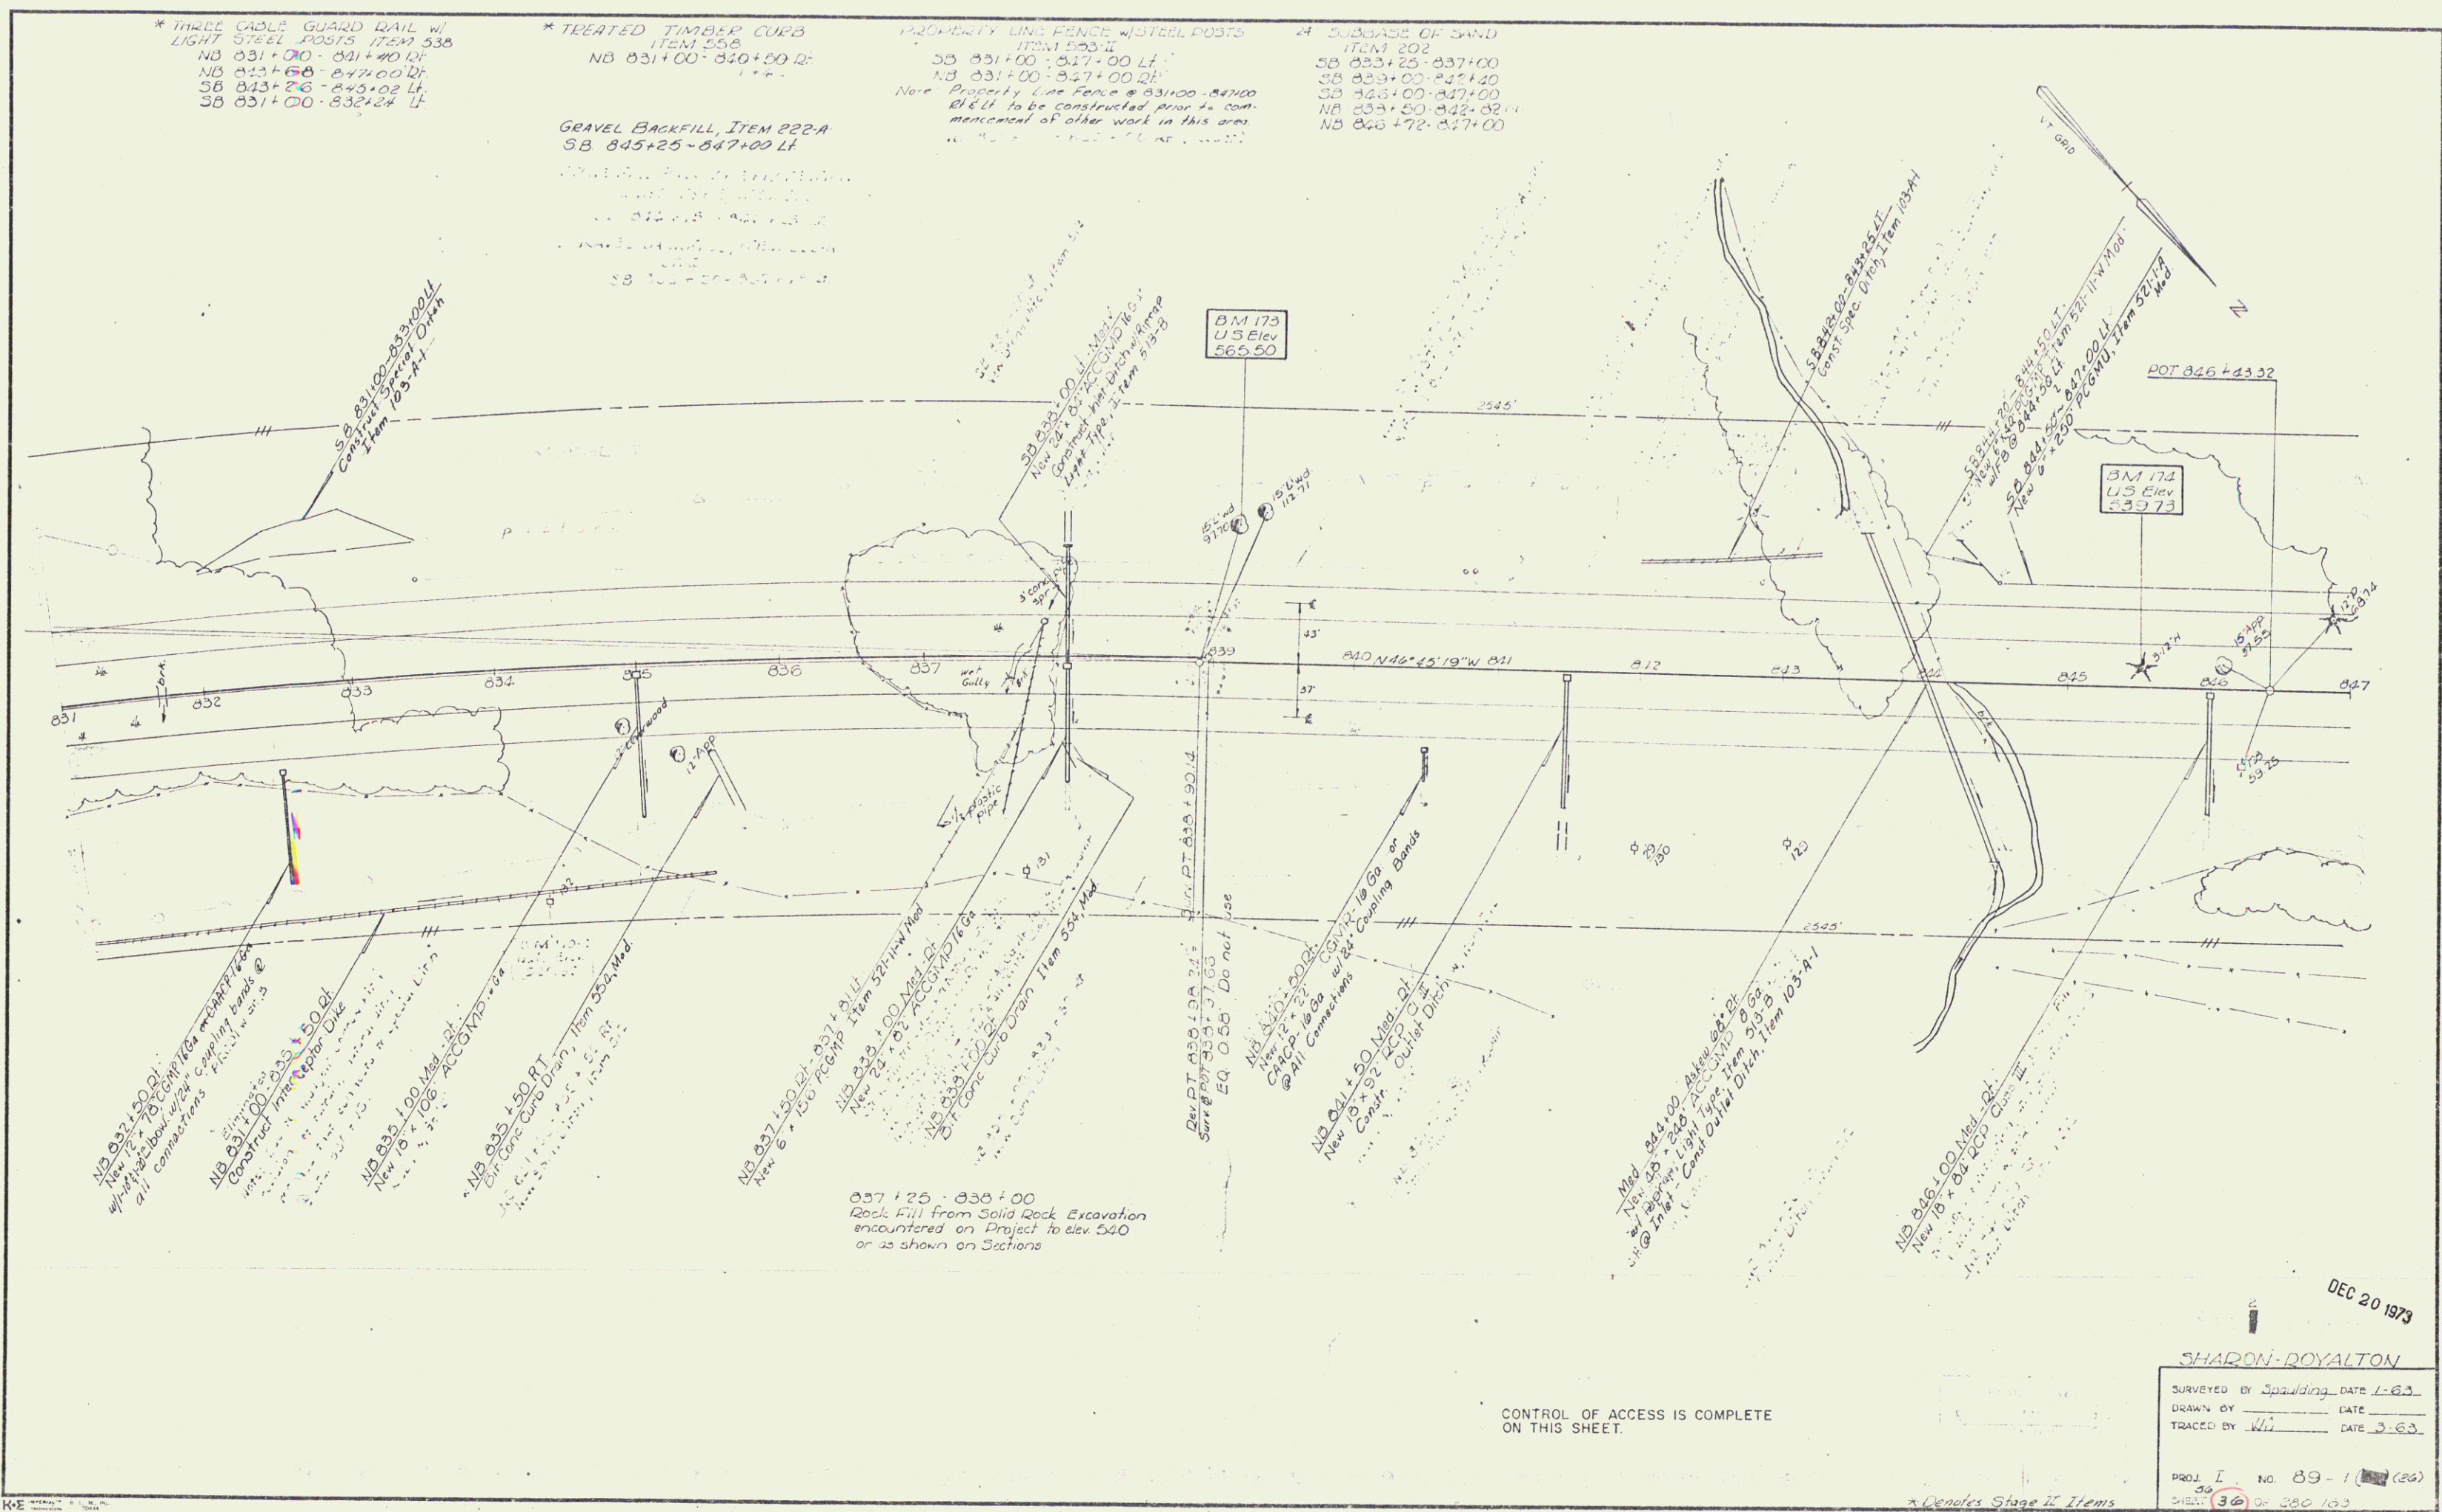

NB 832+00 LF
New 10' x 10' Catch Pits w/ 4\"/>

NB 831+00 LF
Construct 10' x 10' Catch Pits @
Int. @ 100' Intervals

NB 835+00 LF
New 10' x 10' Catch Pits @ Int. @ 100'

NB 835+00 LF
New 10' x 10' Catch Pits @ Int. @ 100'

NB 837+00 LF
New 6' x 6' Catch Pits @ Int. @ 100'

837+25 - 838+00
Rock Fill from Solid Rock Excavation
encountered on Project to elev. 540
or as shown on Sections

NB 841+00 LF
New 10' x 10' Catch Pits @ Int. @ 100'

NB 844+00 LF
New 10' x 10' Catch Pits @ Int. @ 100'

NB 846+00 LF
New 10' x 10' Catch Pits @ Int. @ 100'

SHARON ROYALTON
SURVEYED BY Spaulding DATE 1-63
DRAWN BY DATE
TRACED BY WJ DATE 3-63
PROJ. I. NO. 89-1 (26)
SHEET 36 OF 360 103

CONTROL OF ACCESS IS COMPLETE
ON THIS SHEET.

Sheet

DEC 20 1973

77