

*THREE CABLE GUARD RAIL w/
LIGHT STEEL POSTS ITEM 535
NB 880+02-883+70 Rt
NB 886+20-895+00 Rt

* TREATED TIMBER CHIED
ITEM 258
NB 886+34-883+50 Rt
NB 886+20-895+00 Rt


2A SUBBASE OF SAND
ITEM 202
SB 879+00-880+85
NB 879+00-879+65

PROPERTY LINE FENCE w/STEEL POSTS
ITEM 583-II, Mod
NB 879+00-895+00 Rt
SB 879+00-895+00 Lt

DRIVE GATE - DRAGONERT
LINE FENCE ITEM 583-V, Mod
SB 887+50 Lt

CONST EMERGENCY DRIVE (30' WIDE)
SB 889+50 Lt

GRAVEL BACKFILL ITEM 222-A
SB 879+00-885+50 Lt

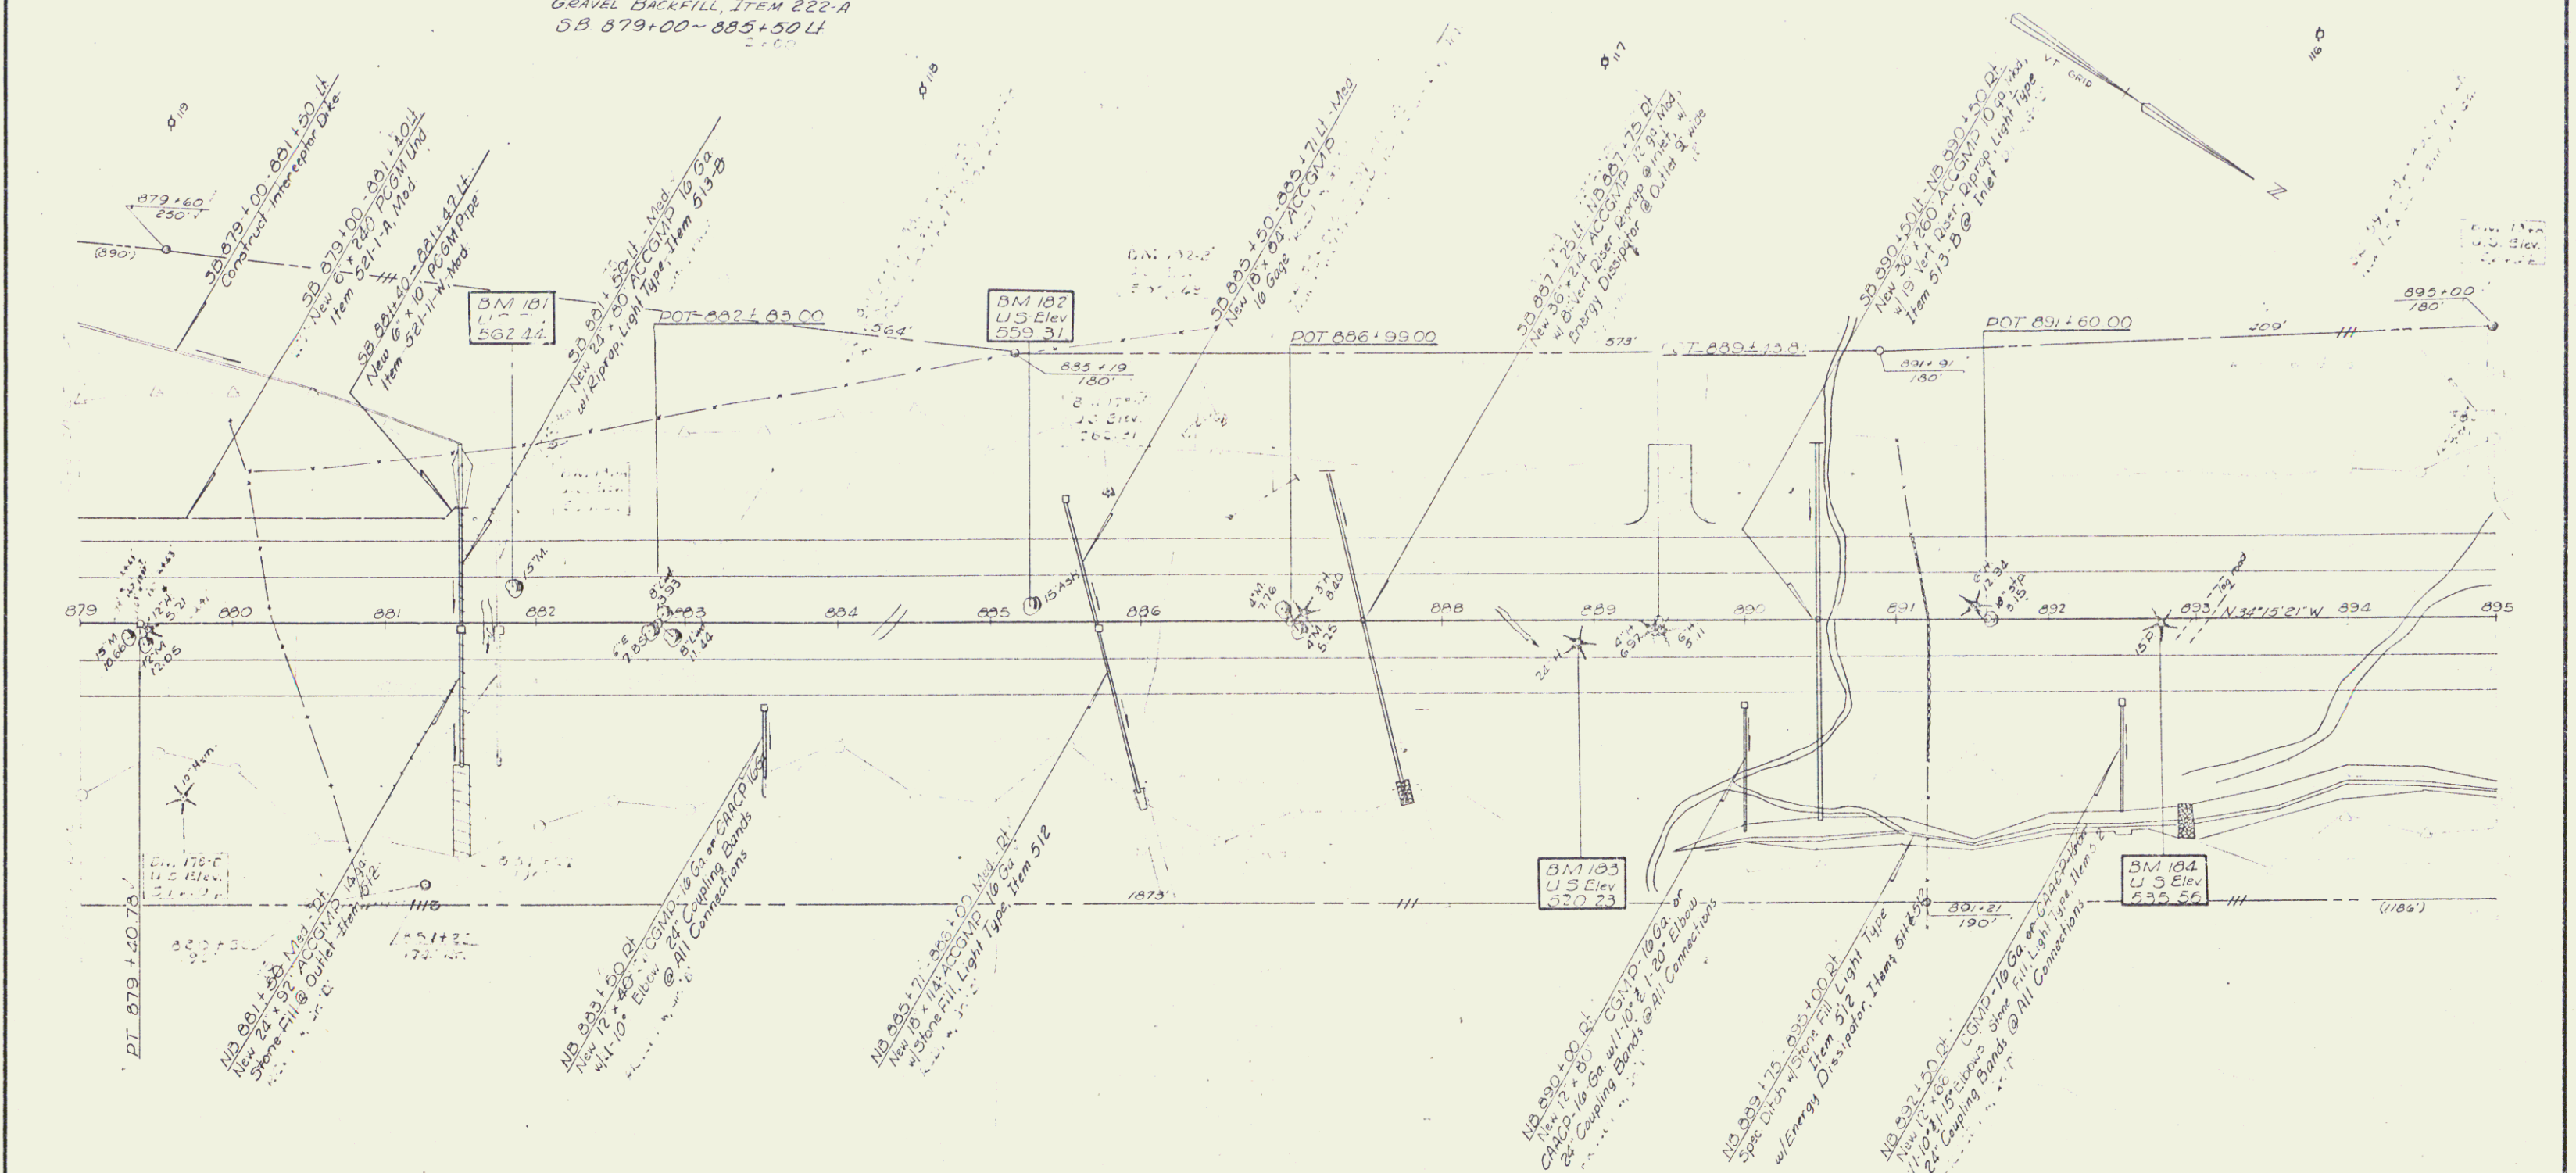

CONTROL OF ACCESS IS COMPLETE
ON THIS SHEET.

DEC 20 1973

SHARON-ROYALTON

SURVEYED BY Spaulding DATE 1-63
DRAWN BY DATE
TRACED BY WJ DATE 3-63

PROJ I NO 89-1 (22)
SHEET 42 OF 280/283

Demeter Stage II Plans

Sheet