

CHANNEL EXCAVATION
ITEM 103
SB 944+17-948+75 Lt
NB 952+60-953+60 Rt

BIPDAP (LIGHT TYPE) ITEM 513-B
SB 944+17-948+75 Lt

STONE FILL FOR SLOPE PROTECTION
(LIGHT TYPE) ITEM 512
NB 951+60-953+50 Lt
NB 953+35-953+00 Rt

*JUTE MATTING ITEM 625
Med 944+50-956+50
Med 951+20-953+50
Med 955+50-957+50

* TREATED TIMBER CURB
ITEM 558
NB Lt 944+40-959+00
SB Lt 944+74-955+14 Lt


* THREE CABLE GUARD RAILS & STEEL POSTS
ITEM 538
NB 943+00-950+40 Lt
SB 944+48-956+00 Lt

PROPERTY LINE FENCE W/ STEEL POSTS, ITEM 583-II
SB 943+00-953+00 Lt
NB 943+00-953+00 Rt

* STANDARD STEEL BEAM GUARD
RAIL & STEEL POSTS ITEM 545-A (6" SPACING)
NB Rt 950+34-959+00

Control of Access is Complete on this Sheet
* Indicates Stage 2 Construction

PLAN
DATE
BY
CHECKED
DATE
BY
SCALE
NO. OF SHEETS
SHEET NO.

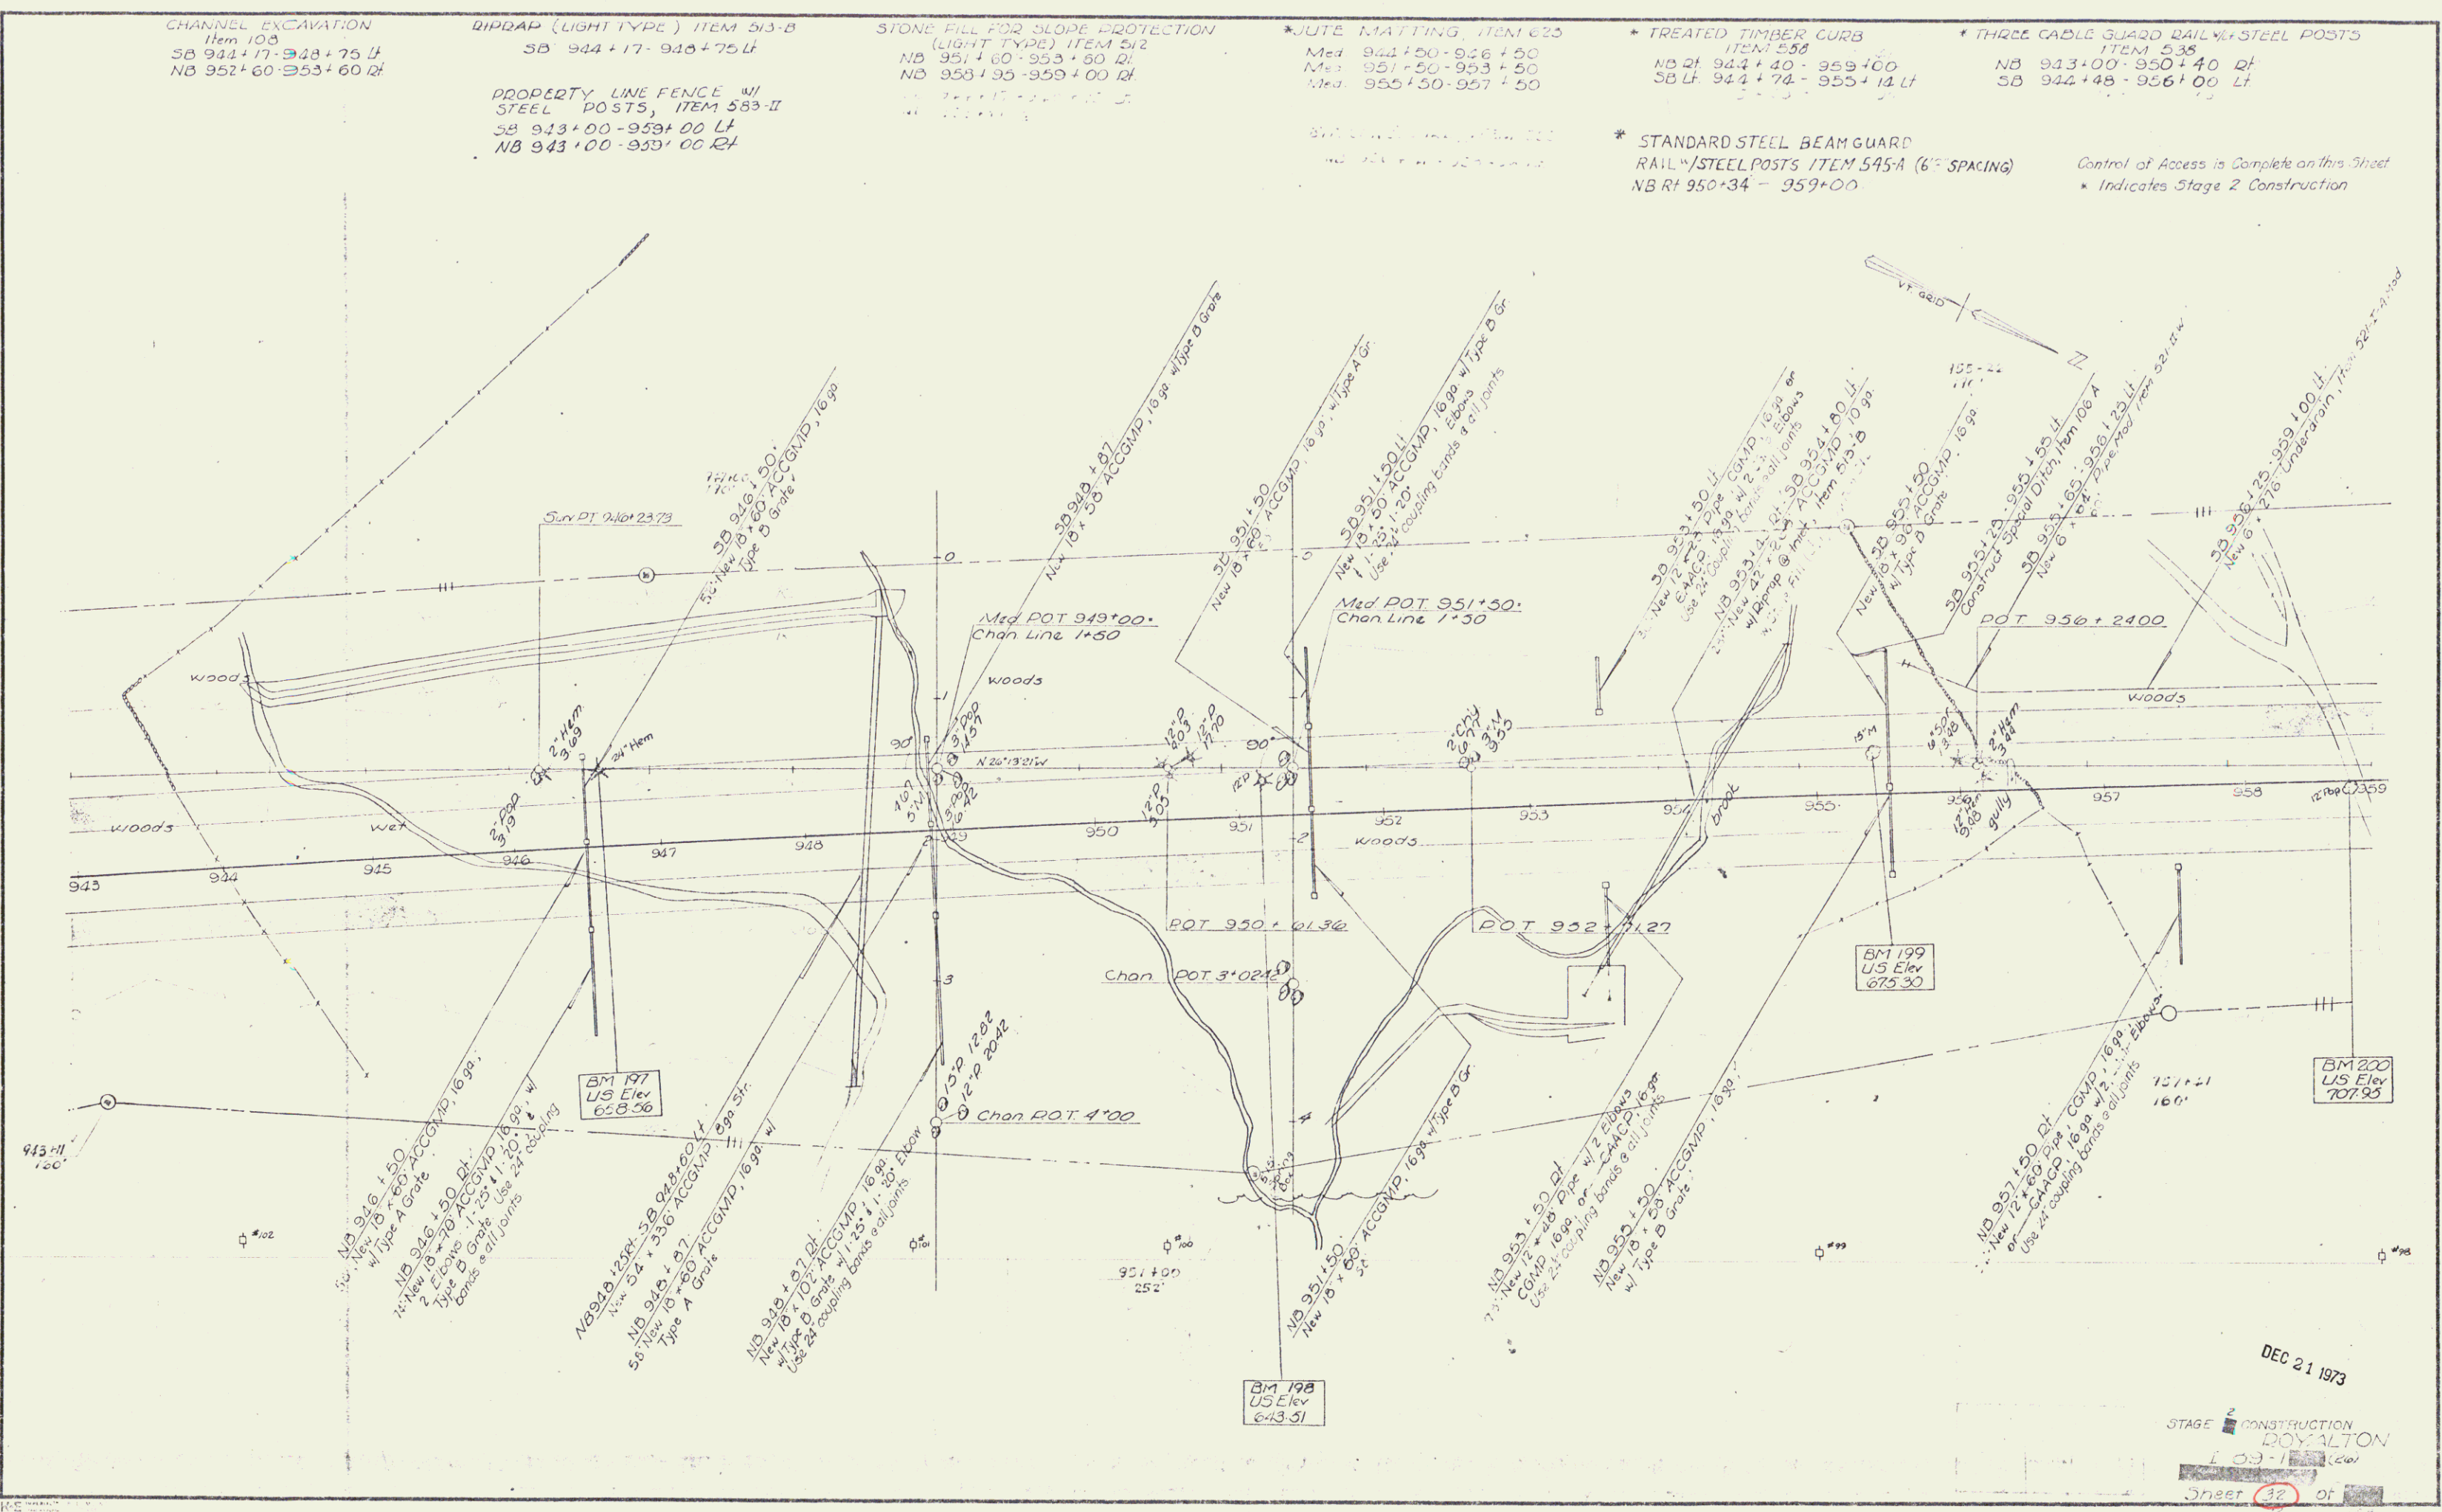

DEC 21 1973

STAGE 2 CONSTRUCTION
ROYALTON

Sheet 32 of 32

Sheet

26