

DRILLING AND BLASTING OF SOLID
ROCK SUBGRADE, ITEM 115
1006+90 - 1008+75
1010+25 - 1021+75

PROPERTY LINE FENCE w/ STEEL POSTS
ITEM 533-E
NB 1006+50 - 1023+00 Rt
SB 1006+50 - 1023+00 Lt


* JUTE MATTING
ITEM 623
Med 1019+00 - 1020+50

* THREE CABLE GUARD RAIL w/ STEEL POSTS
ITEM 538
SB 1006+50 - 1023+00 Rt

* STANDARD STEEL BEAM GUARD RAIL
w/ STEEL POSTS ITEM 545-A (6' STACING)
NB 1006+50 - 1009+00 Rt
NB 1015+50 - 1023+00 Rt

Control of Access is complete on this sheet
* Indicates Stage 2 Construction

Δ 49° 54' 02" L
D 3' 30"
R 1637.02
T 761.64
L 1425.73
E 160.50

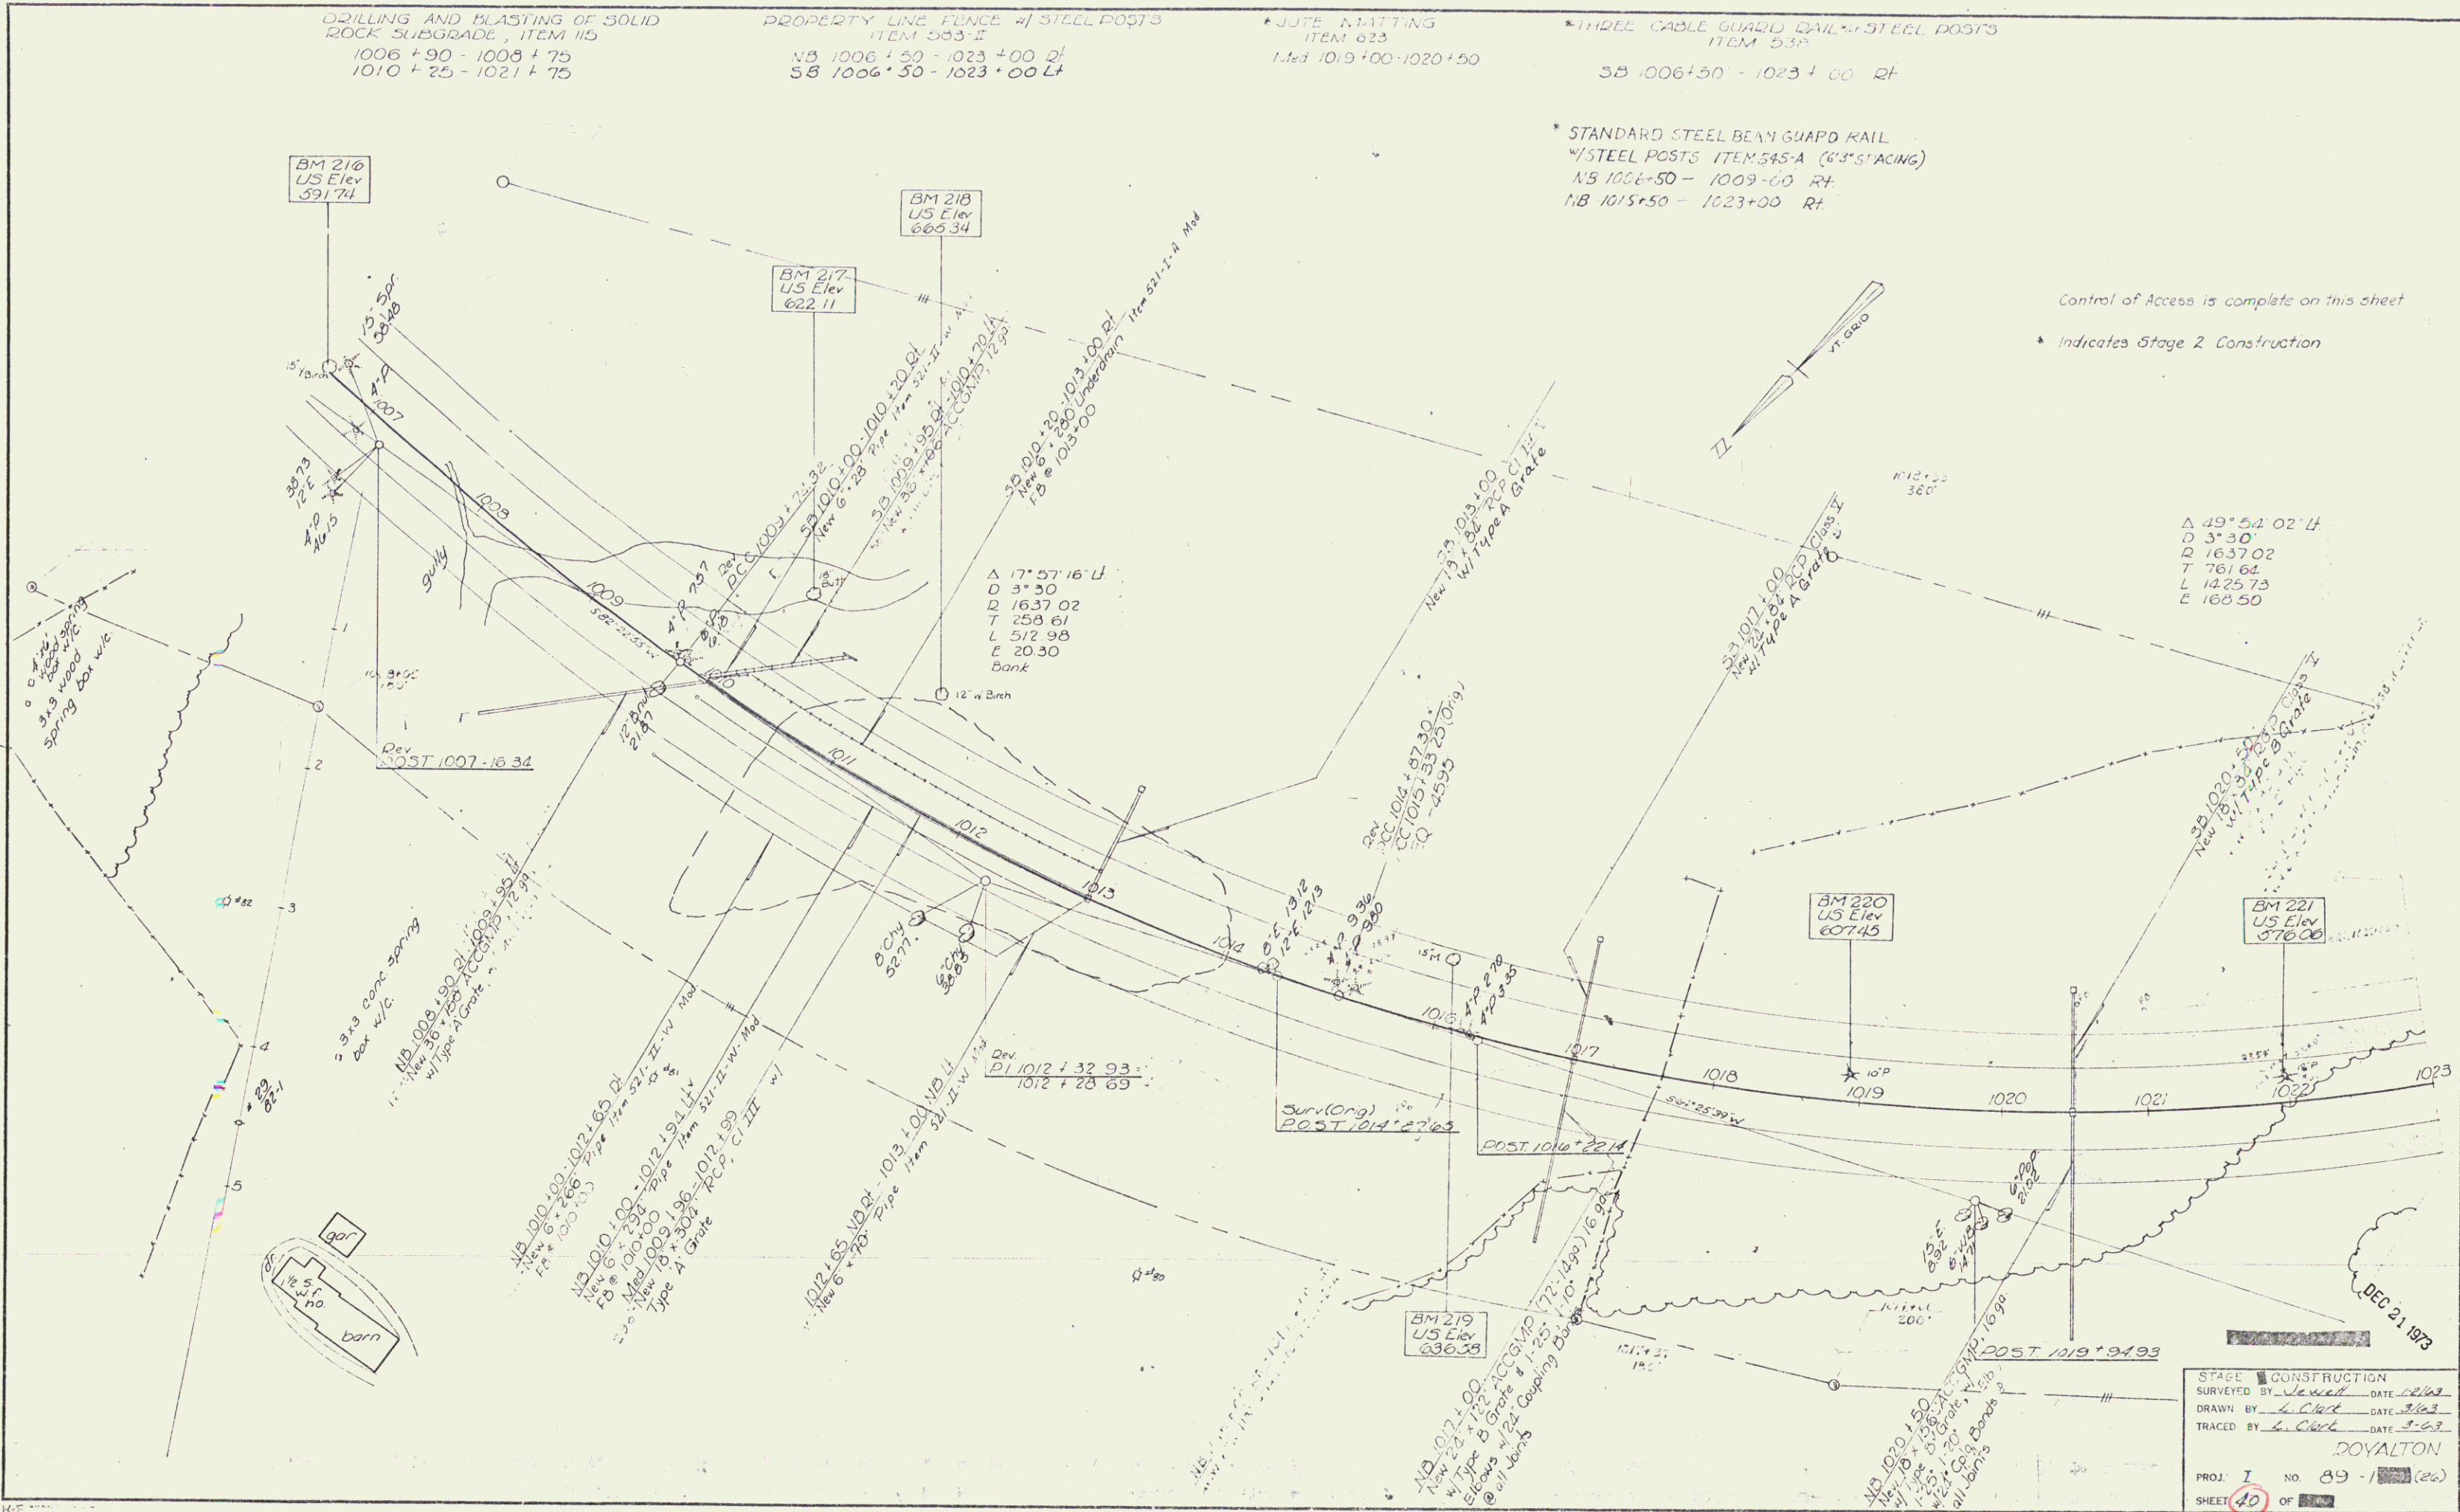

STAGE CONSTRUCTION
SURVEYED BY Sevel DATE 12/68
DRAWN BY L. Clark DATE 3/63
TRACED BY L. Clark DATE 3-63
DOVALTON
PROJ. I NO. 89 - / (20)
SHEET 40 OF 103
Sheet