
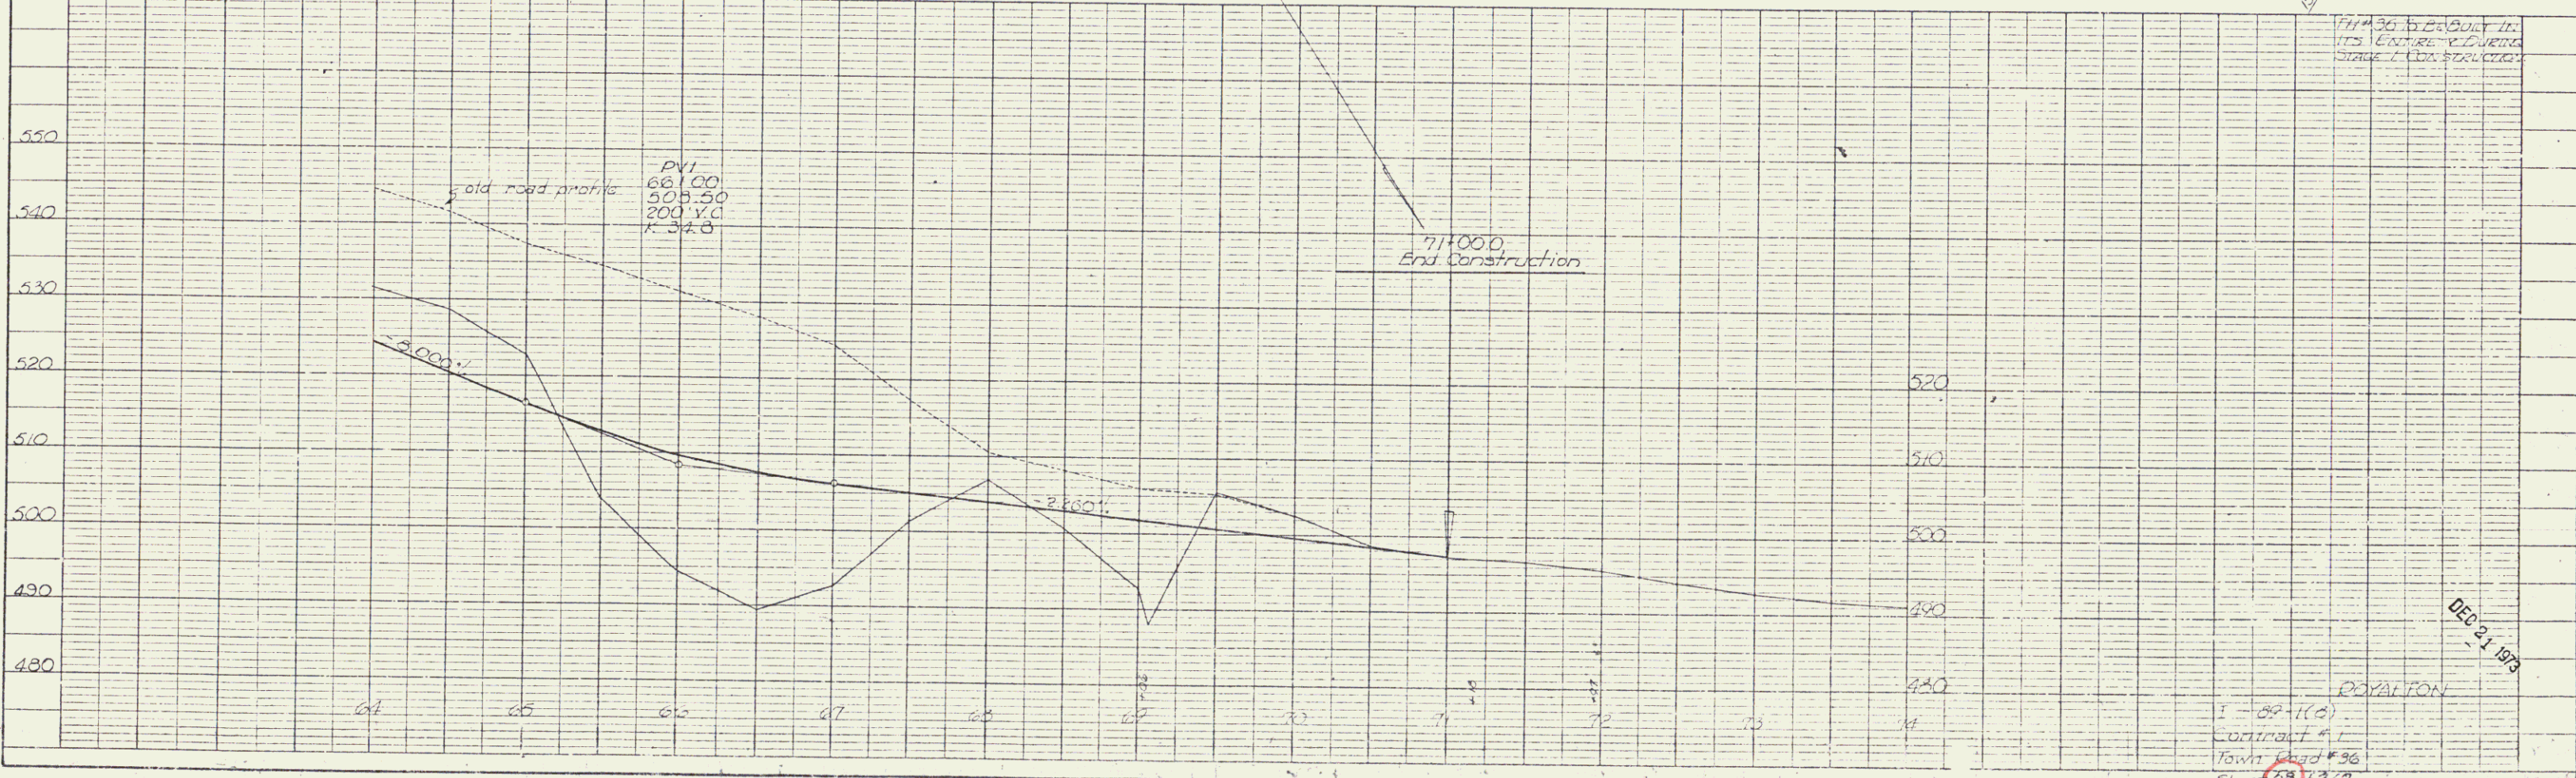


PLAN
 DATE: 10/84
 DRAWN BY: [Name]
 CHECKED BY: [Name]
 NO. 0124

PROFILE
 DATE: 10/84
 DRAWN BY: [Name]
 CHECKED BY: [Name]
 NO. 0124

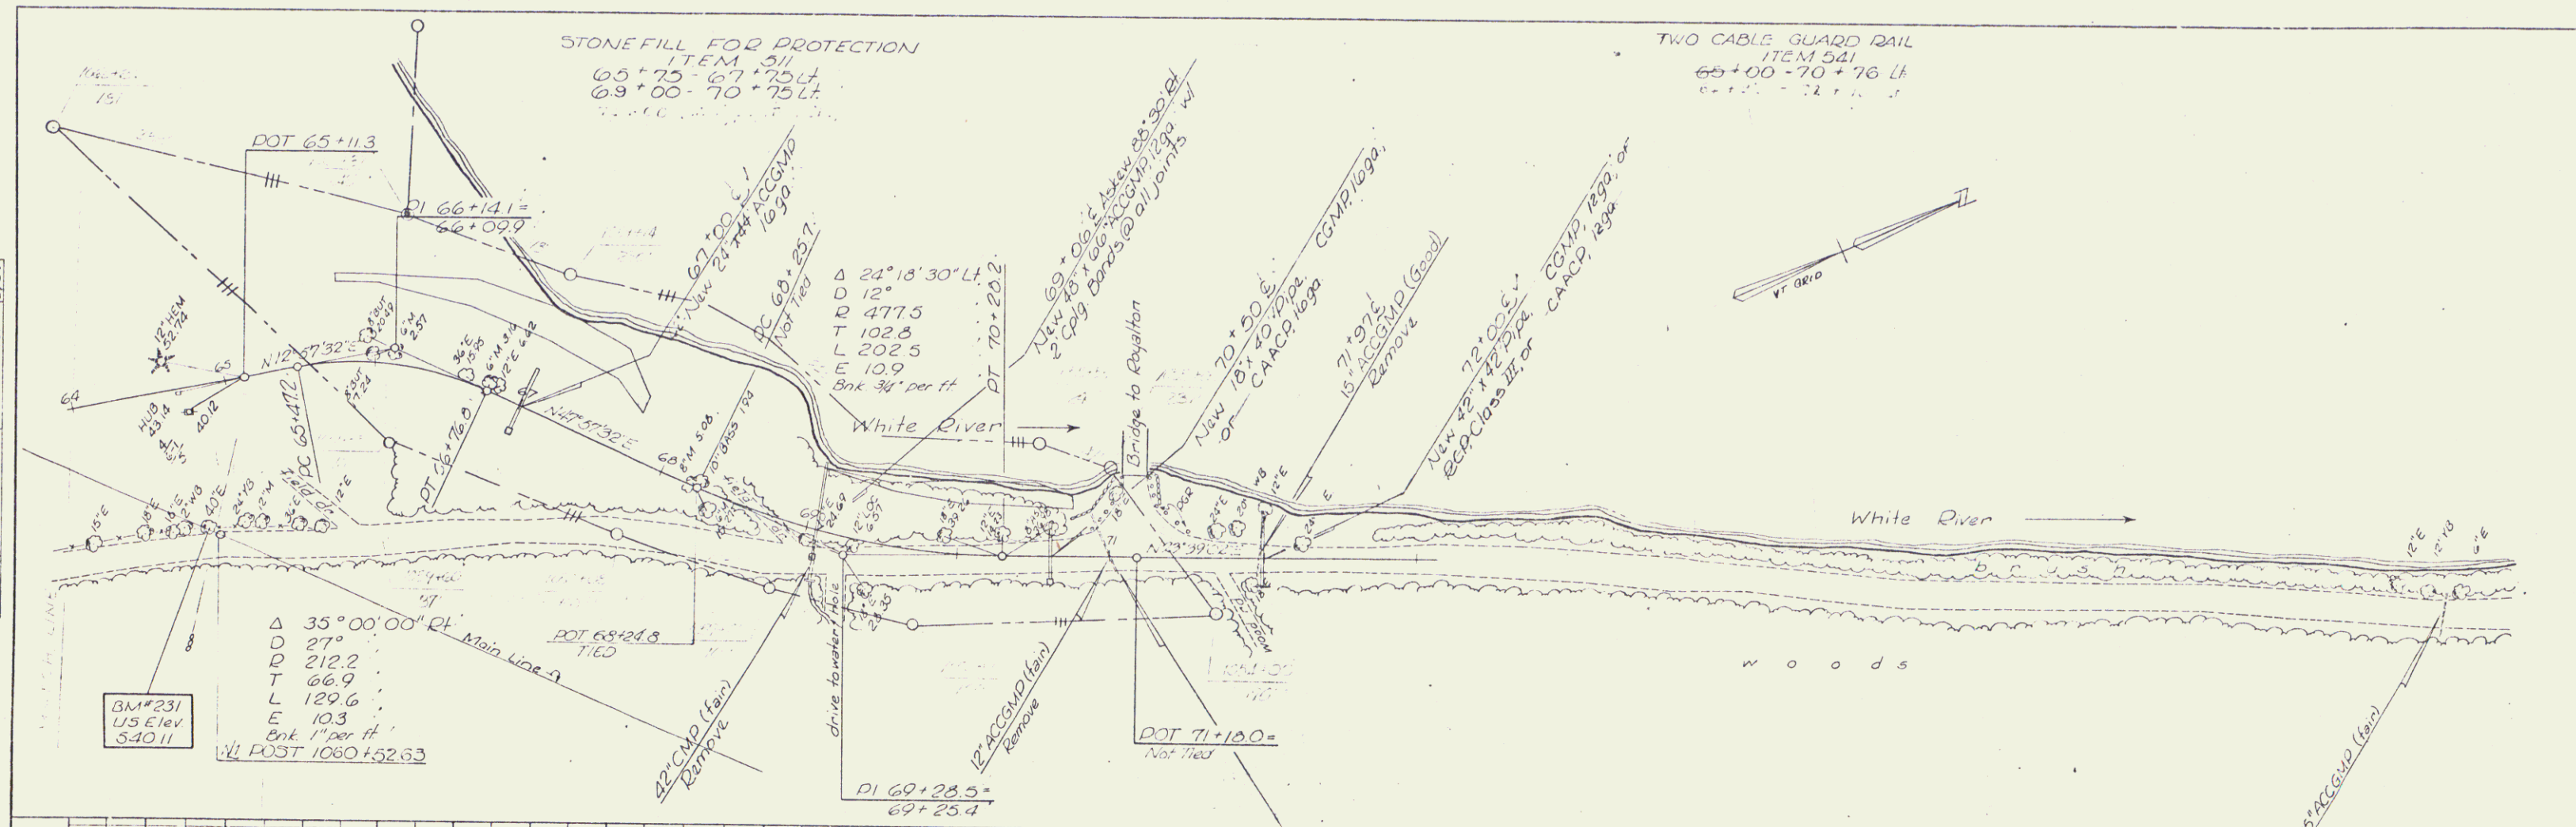

K&E PLATE 1, PLAN PROFILE
 MADE BY K&E CO.

96