

REMOVAL AND DISPOSAL OF
PRESENT GUARD RAIL, ITEM 549
VT 107, 22+65-25+00 RT

GRANITE SLOPE EDGING
ITEM 550 "A"
VT 107, 22+60-25+00 & ISLAND


BITUMINOUS CONCRETE SURFACE FOR
GUTTERS AND TRAFFIC ISLANDS, ITEM 554
VT 107, 24+12 RT

THREE CABLE GUARD RAIL
WIREPOSTS, ITEM 542
VT 107, 20+24 - 25+00 EI

Proposed by P. J. ...
VT 107, 22+63 - 25+00

VT 107
Δ 3°14'00" LT
D 0+25
R 7639.44
T 215.61
L 431.11
E 3.05

VT 107
Δ 9°17'30" LT
D 10
R 5729.50
T 465.02
L 929.16
E 18.89
Bk. 14" per ft

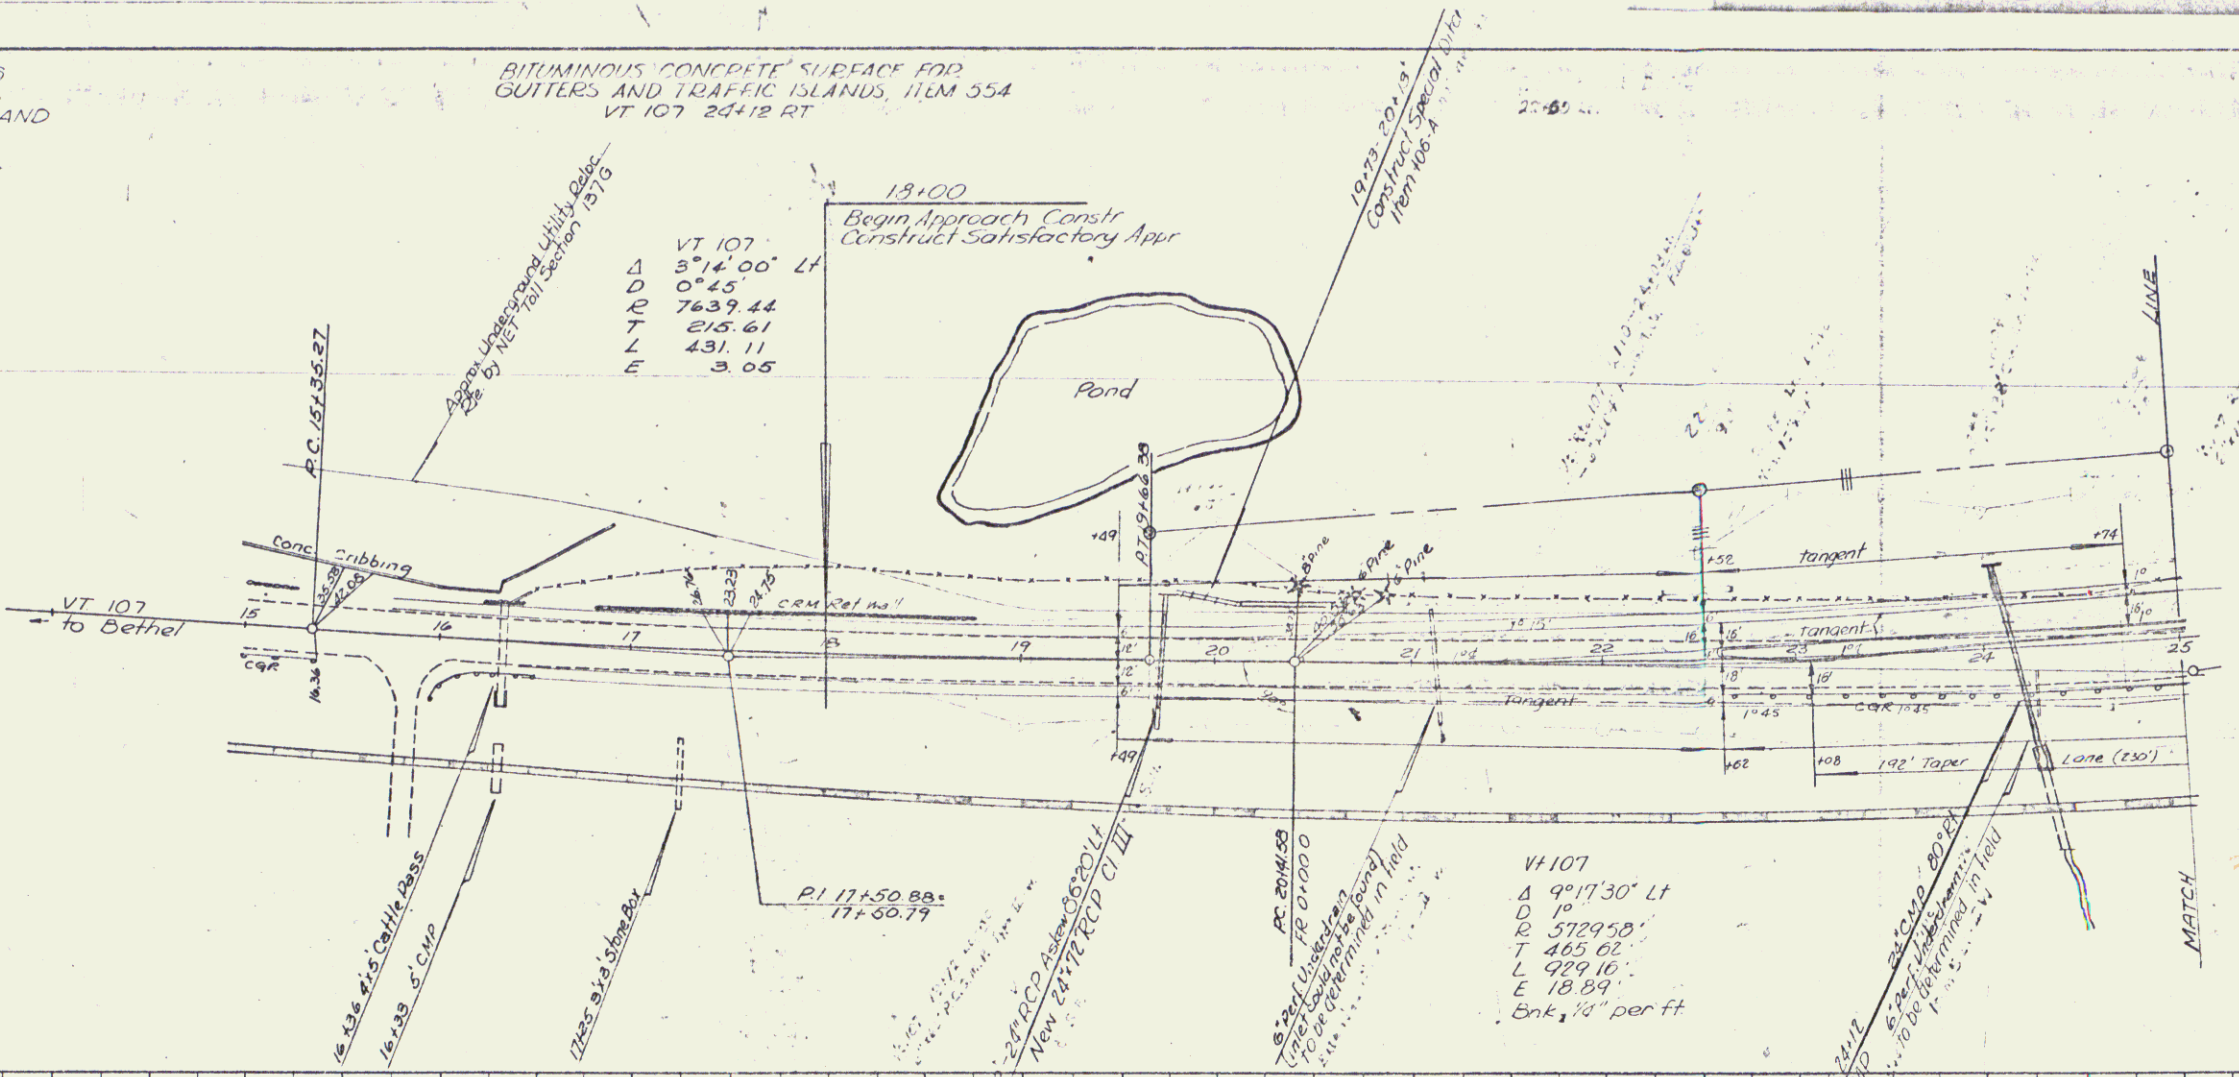

PLAN
DATE: _____
BY: _____
CHECKED: _____
DATE: _____

PROFILE
DATE: _____
BY: _____
CHECKED: _____
DATE: _____

DEC 21 1973
Note: VT 107 is to be
built in its current
alignment.

ROYALTON
39-1151
Sheet 1 of 1