


* THREE CABLE GUARD RAIL,
ITEM 535
1231+00 - 1247+00 NB-21

JOINT MATING ITEM 523
1245+50 - 1247+00 MSD
1245+50 - 1247+00 SB-L1

* TREATED TIMBER CURB
ITEM 553
1231+00 - 1247+00 NB-21

PROPERTY LINE FENCE, MOD
ITEM 533-II
1243+00 - 1247+00 SB-L1
1243+00 - 1247+00 NB-21

* DENOTES STAGE 2 CONSTRUCTION

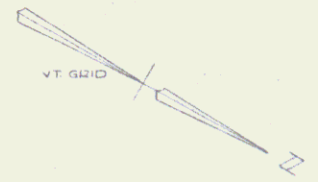

DEC 21 1973

CONTROL OF ACCESS COMPLETE ON THIS SHEET

28 Sheet

117