


PROPERTY LINE FENCE, MOD
ITEM 583 - II
1247+00 - 1256+30 SB-L
1247+00 - 1253+44 NB-R
1262+00 - 1263+00 SB-L

JUTE MATTING, ITEM 623
1255+25 - 1256+75 SB-L

THREE CABLE GUARD RAIL
ITEM 542
1247+00 - 1254+44 NB-R
1257+50 - 1259+10 NB-R
1256+00 - 1260+80 SB-L

BIT CONC CURB, ITEM 555
1247+00 - 1250+75 NB-R
DRILLING & BLASTING OF SOLID
ROCK SUBGRADE, ITEM 115
1248+75 - 1256+10 SB
1249+70 - 1250+45 NB
1251+30 - 1256+75 NB
1257+90 - 1263+00 NB
1256+40 - 1263+00 SB

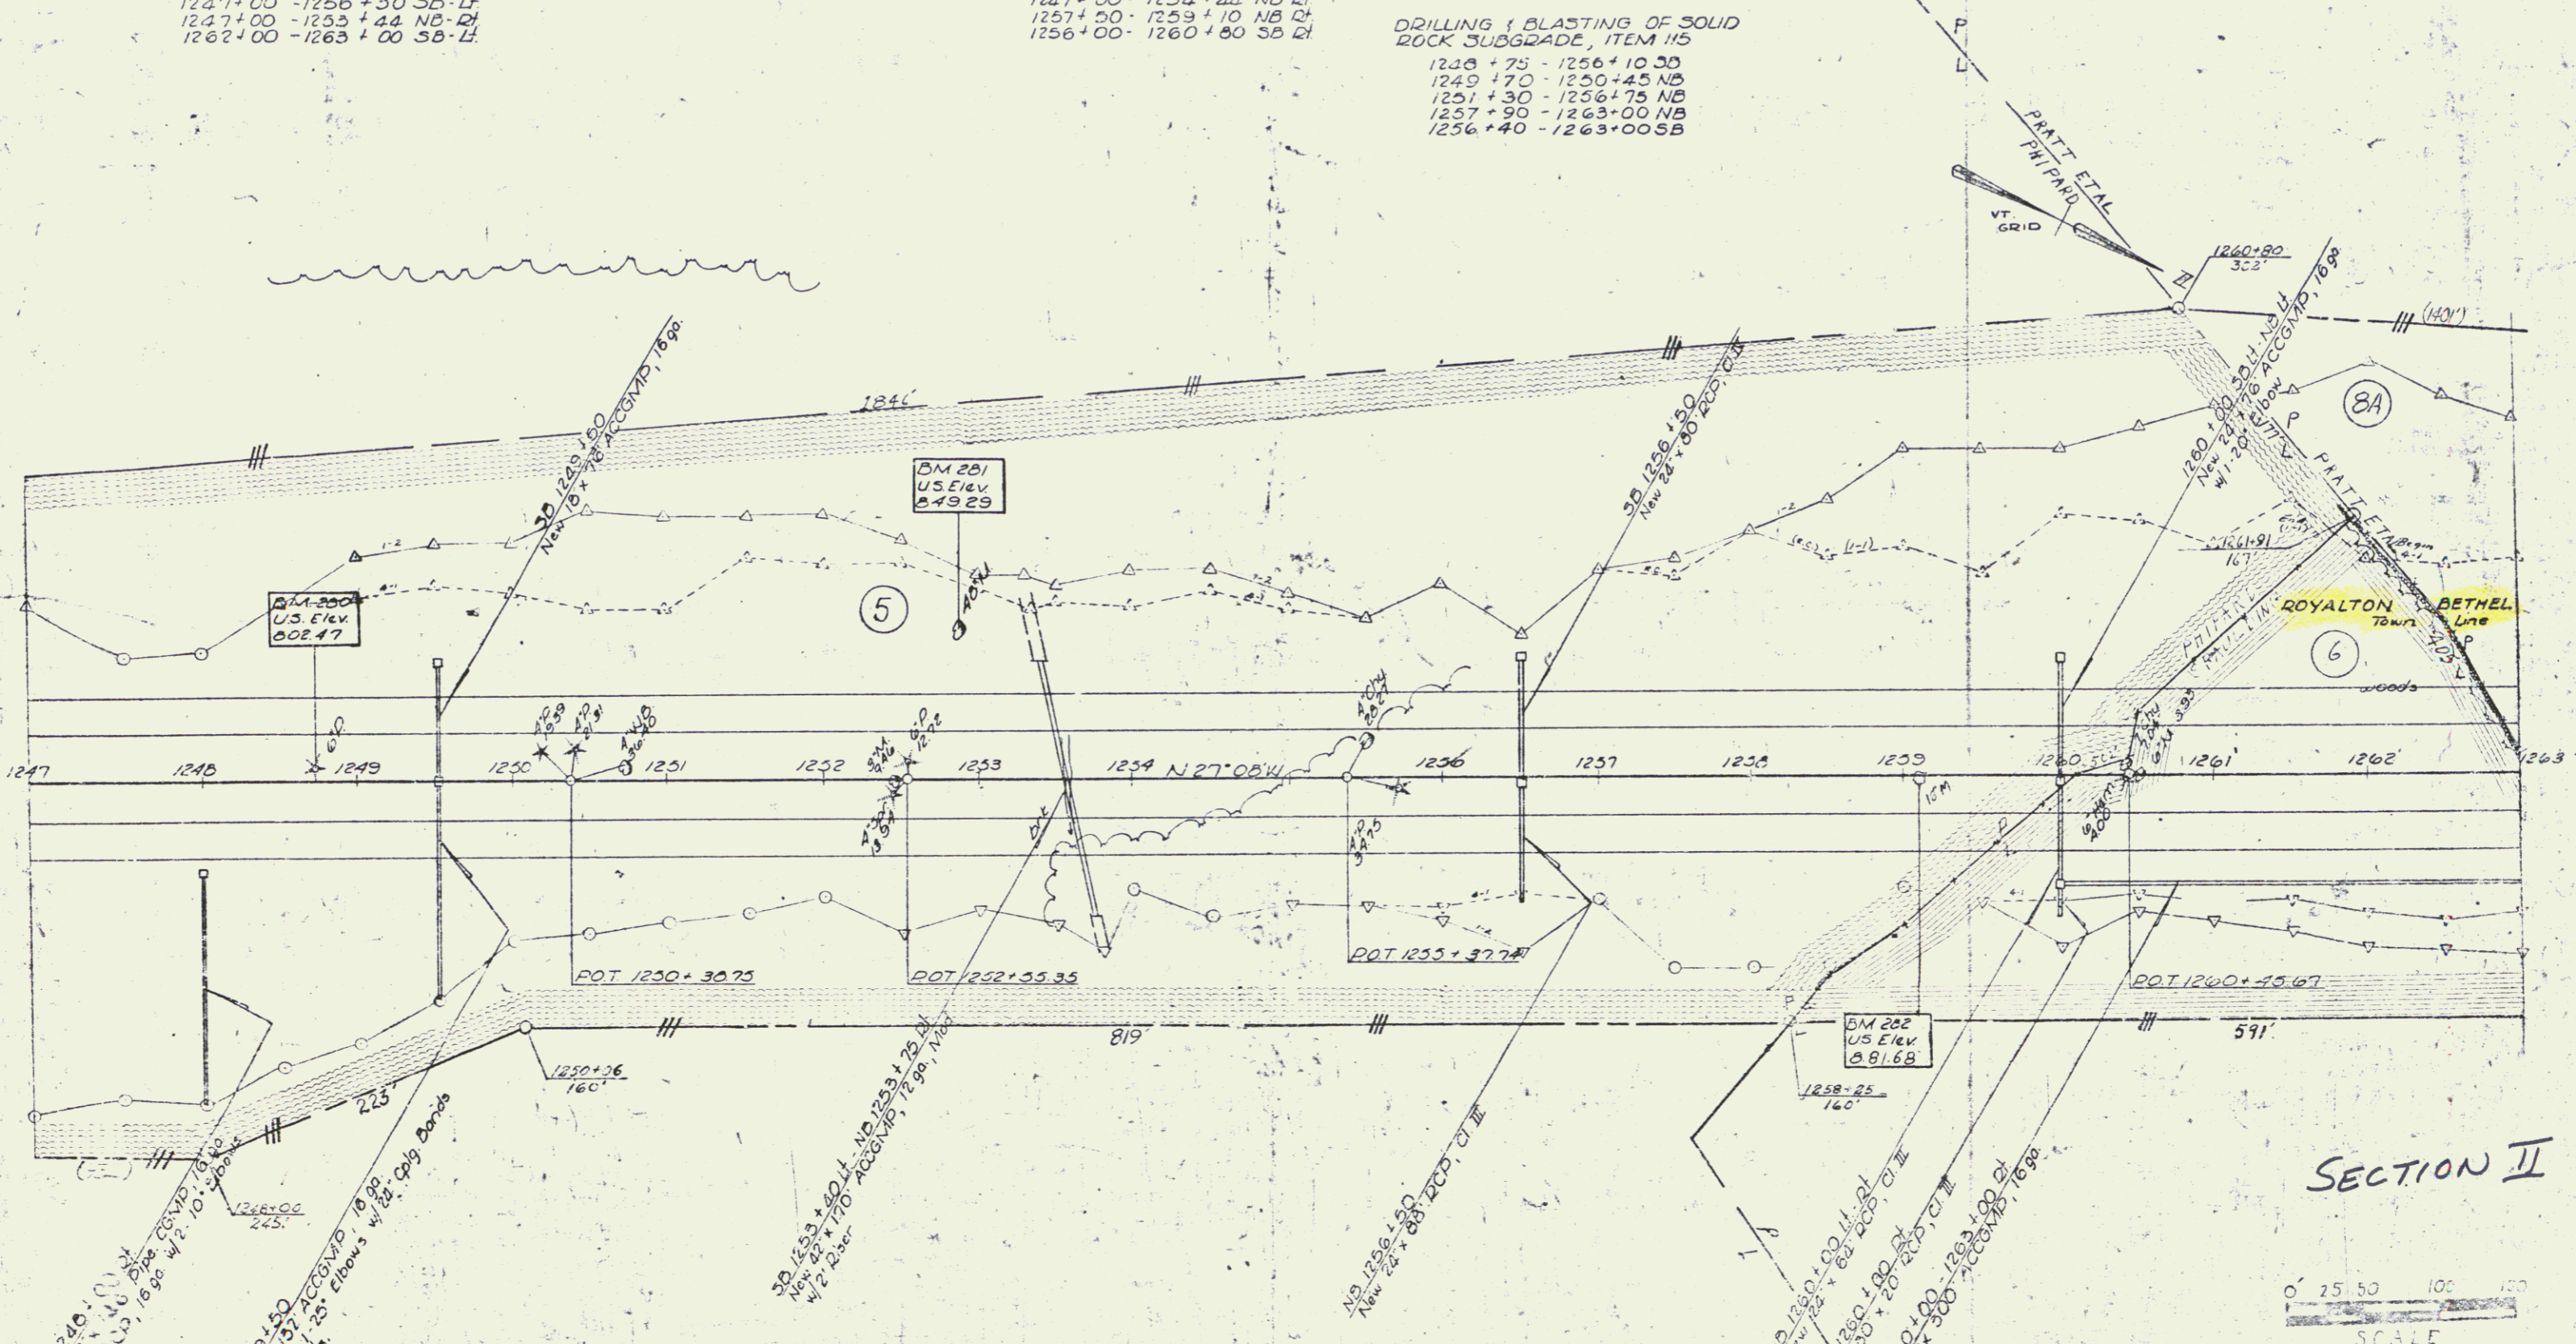

0' 25' 50' 100' 150'
SCALE

VERMONT DEPARTMENT OF HIGHWAYS
RIGHT-OF-WAY PLANS
PROJECT: ROYALTON-BETHEL-RANDOLPH
NO: 199-(114)
SHEET: 19 OF 44