
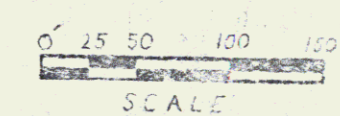
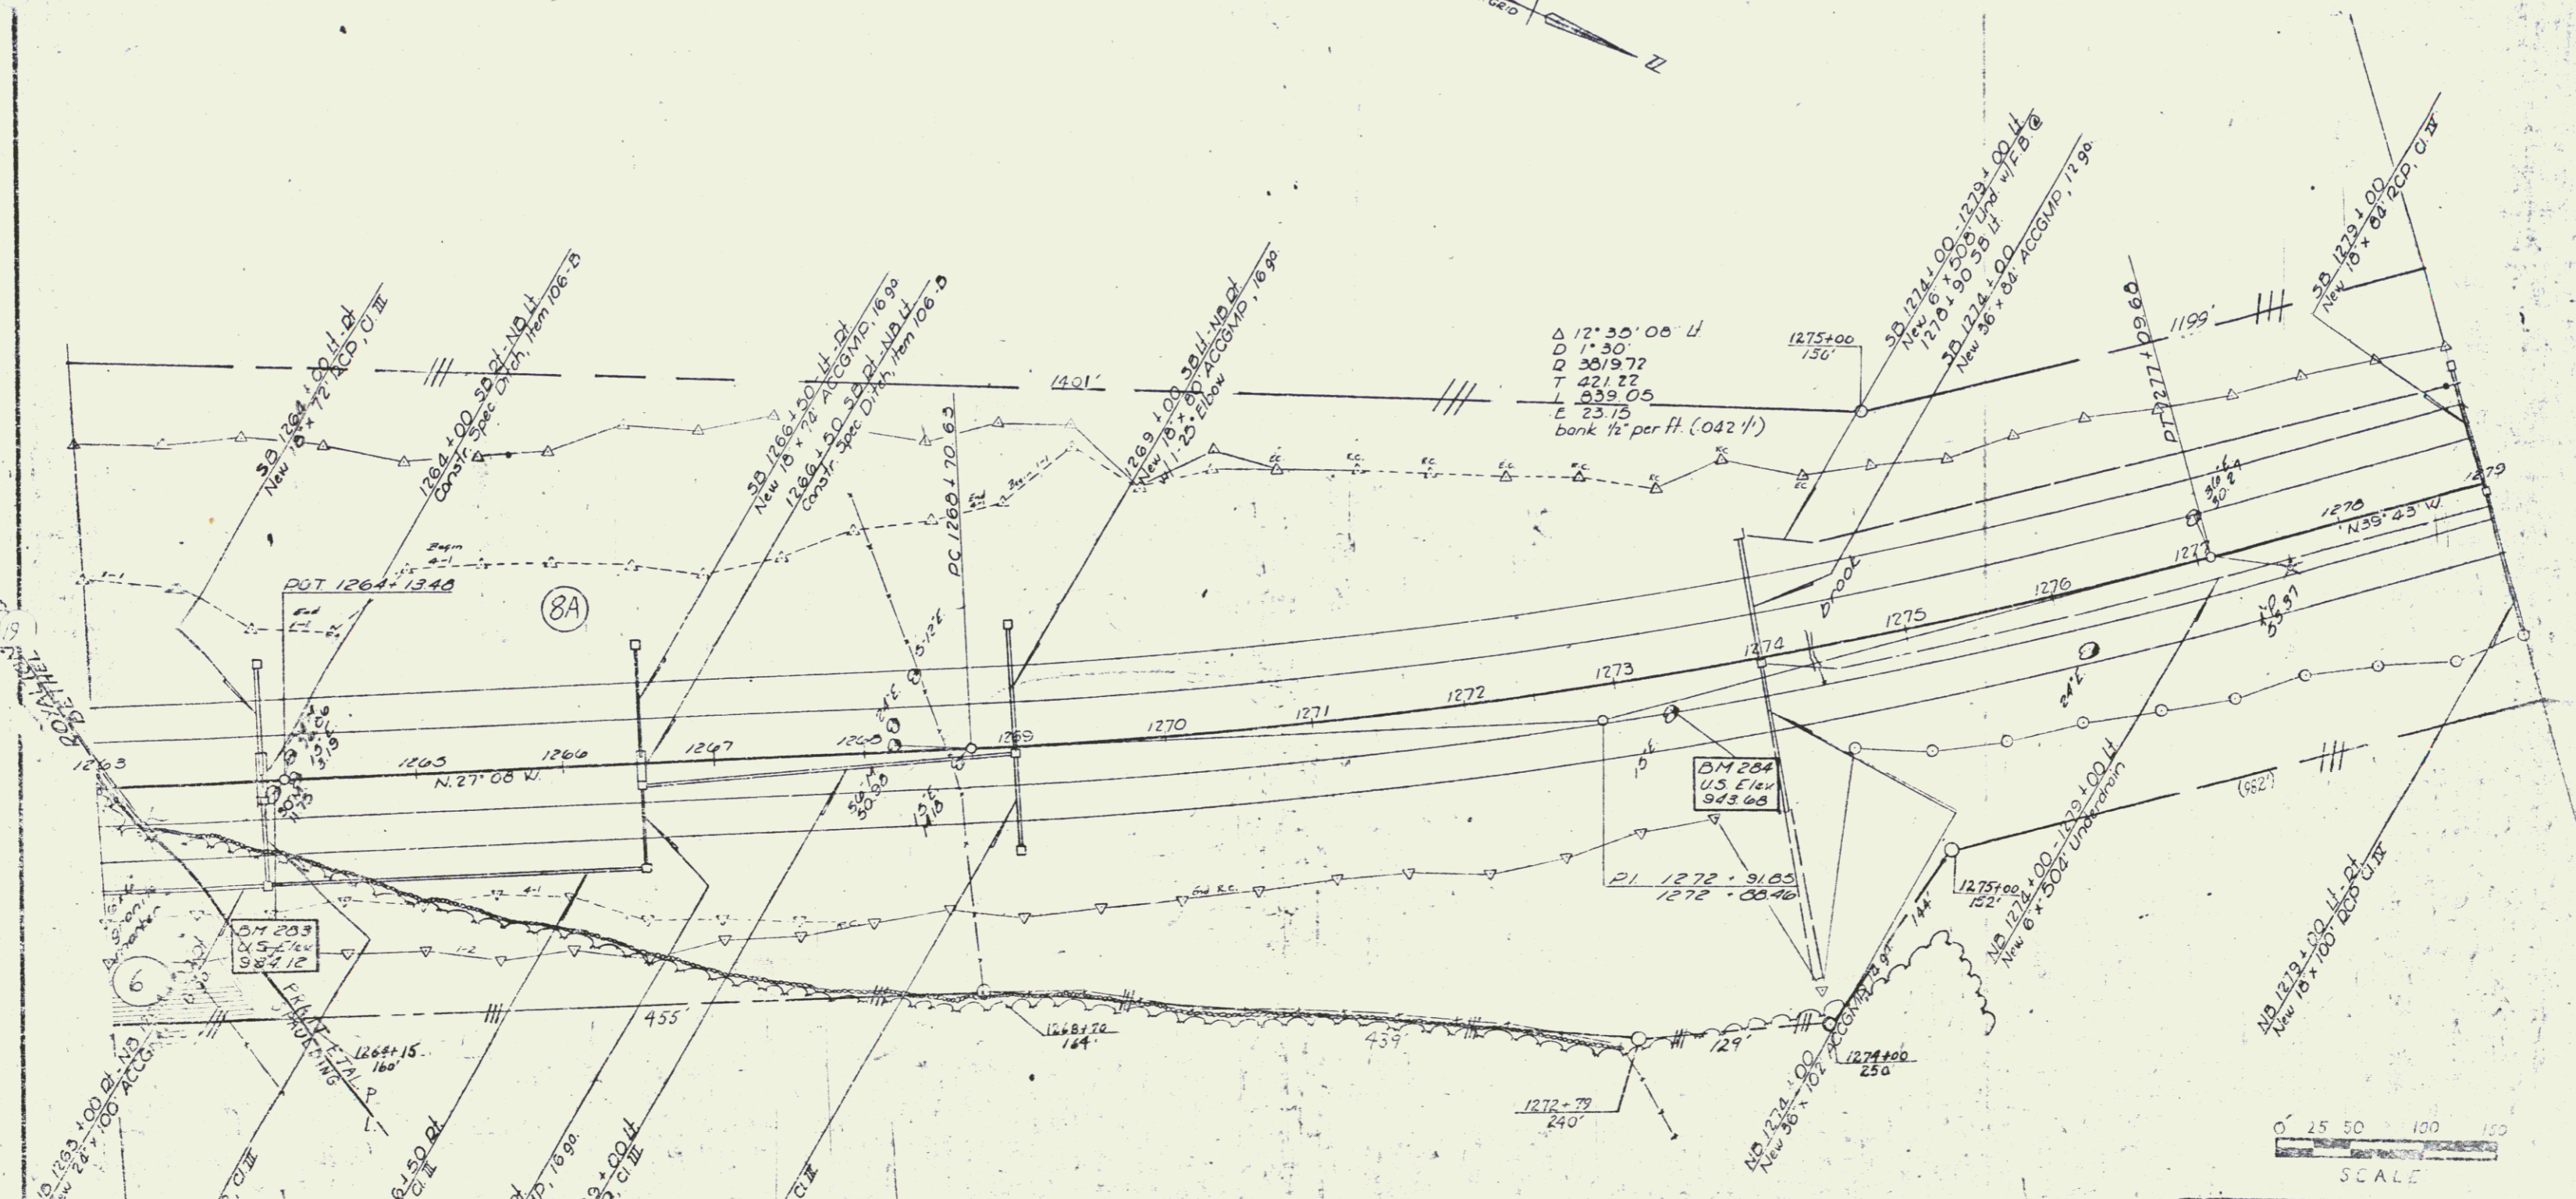


PROPERTY LINE FENCE, MOD
ITEM 533-II
1263+00 - 1279+00 SB U
1265+30 - 1279+00 NBD.

THREE CABLE GUARD RAIL
ITEM 542
1268+68 - 1279+00 SB D.

JUTE MATTING, ITEM 623
1270+75 - 1274+25 NB D.
1272+25 - 1279+00 Med.
1274+75 - 1279+00 SB U.

DRILLING & BLASTING OF SOLID
ROCK SUBGRADE, ITEM 115
1263+00 - 1272+60 NB
1263+00 - 1274+10 SB

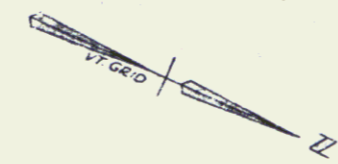

VERMONT DEPARTMENT OF HIGHWAYS
RIGHT-OF-WAY PLANS
PROJECT: SOLINGTON-BETHEL-RANDOLPH
NO. 109-1(14)
SHEET 20 OF 11

SECTION II