


PROPERTY LINE FENCE
ITEM 563 II
1279 + 00 - 1280 + 25 30 ft
1279 + 00 - 1283 + 90 NB Rt

JUTE MATTING, ITEM 623
1279 + 00 - 1280 + 00 Med
1279 + 00 - 1282 + 75 35 ft
1283 + 75 - 1295 + 00 NB Rt
1291 + 75 - 1295 + 75 Med
1294 + 25 - 1295 + 00 30 ft

THREE CABLE GUARD, ITEM 547
1282 + 00 - 1283 + 56 NB Rt
1279 + 00 - 1283 + 00 30 ft

BITUMINOUS CONC CURB
ITEM 565
1283 + 50 - 1286 + 40 NB Rt

DRILLING & BLASTING OF SOUL
ROCK SUBGRADE, ITEM 115
NB 1290 + 75 - 1295 + 00
SB 1292 + 30 - 1295 + 00

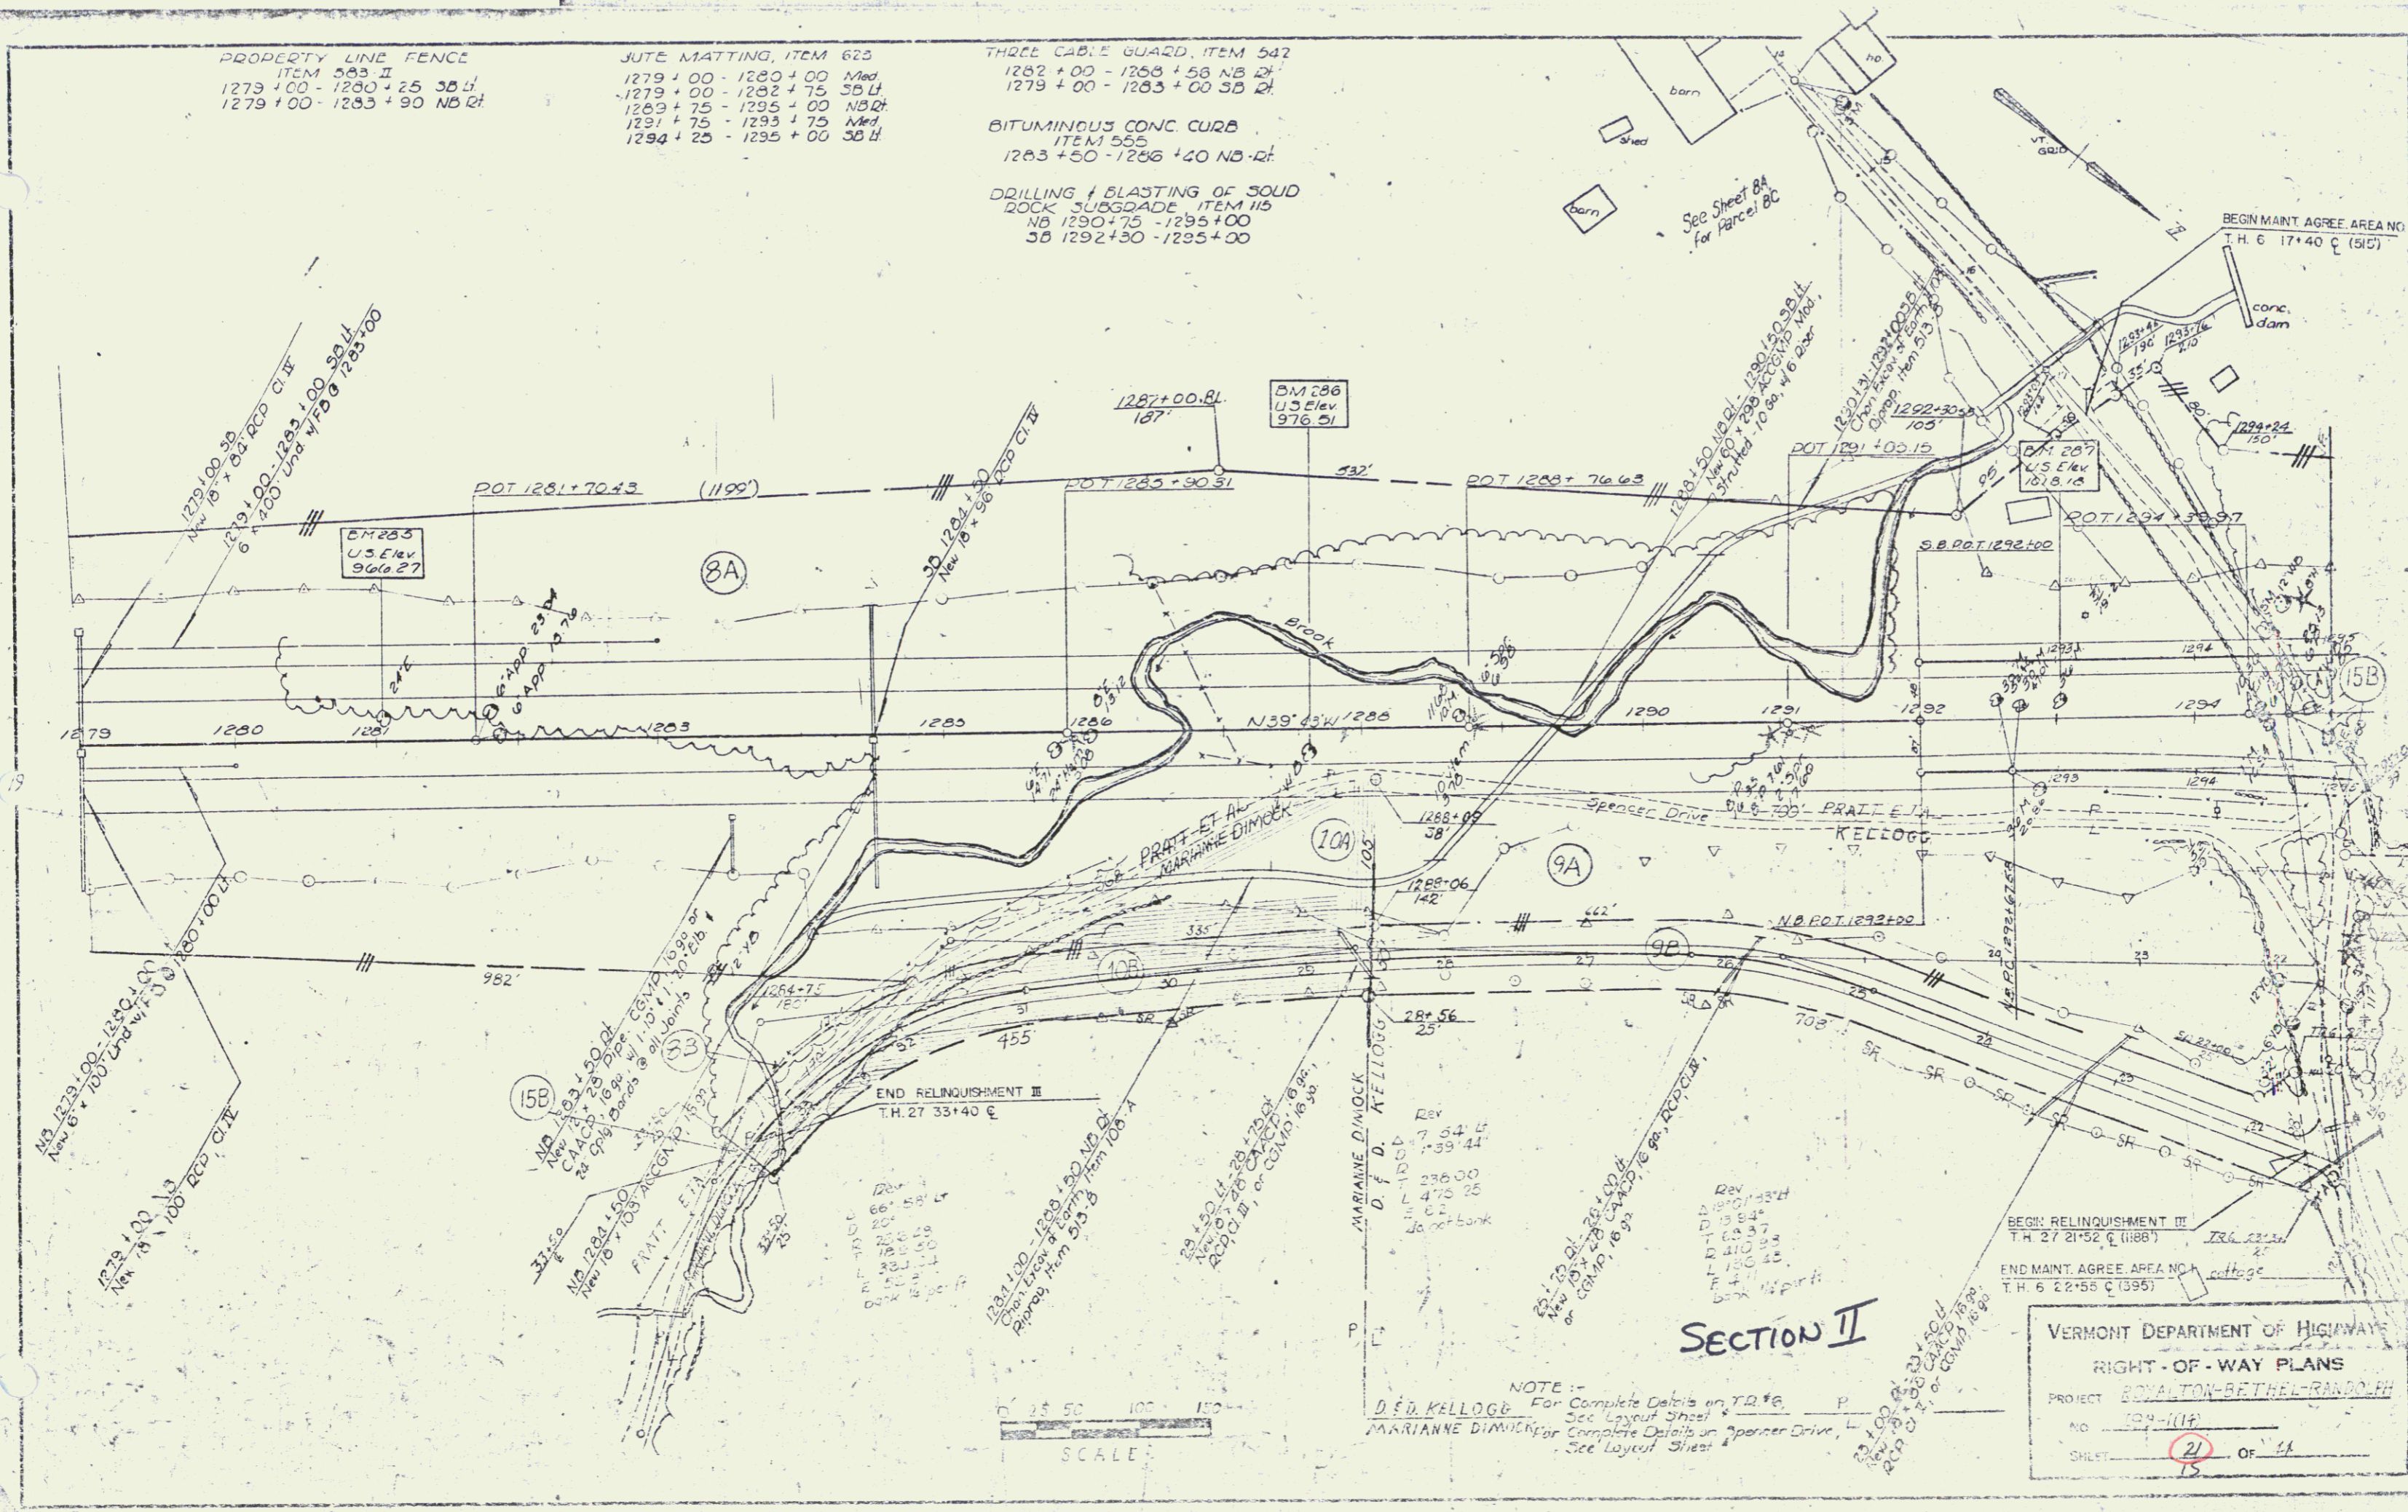

VERMONT DEPARTMENT OF HIGHWAYS
RIGHT-OF-WAY PLANS
PROJECT ROYALTON-BETHEL-RANDOLPH
NO. 1294-117
SHEET 21 OF 44