


DRILLING AND BLASTING OF SOLID ROCK SUBGRADE, ITEM 115  
 NB 1295+00-1311+00  
 SB 1295+00-1296+60  
 SB 1307+75-1311+00

JUTE MATTING, ITEM 623  
 NB 1295+00-1304+75 RT  
 SB 1295+00-1296+25 LT  
 SB 1300+25-1303+75 RT

MUCK EXCAVATION, ITEM 117  
 S.B. 1300+25-1303+75

THREE CABLE GUARD RAIL w/ STEEL POSTS, ITEM 542  
 1300+00-1305+60 S.B. LT

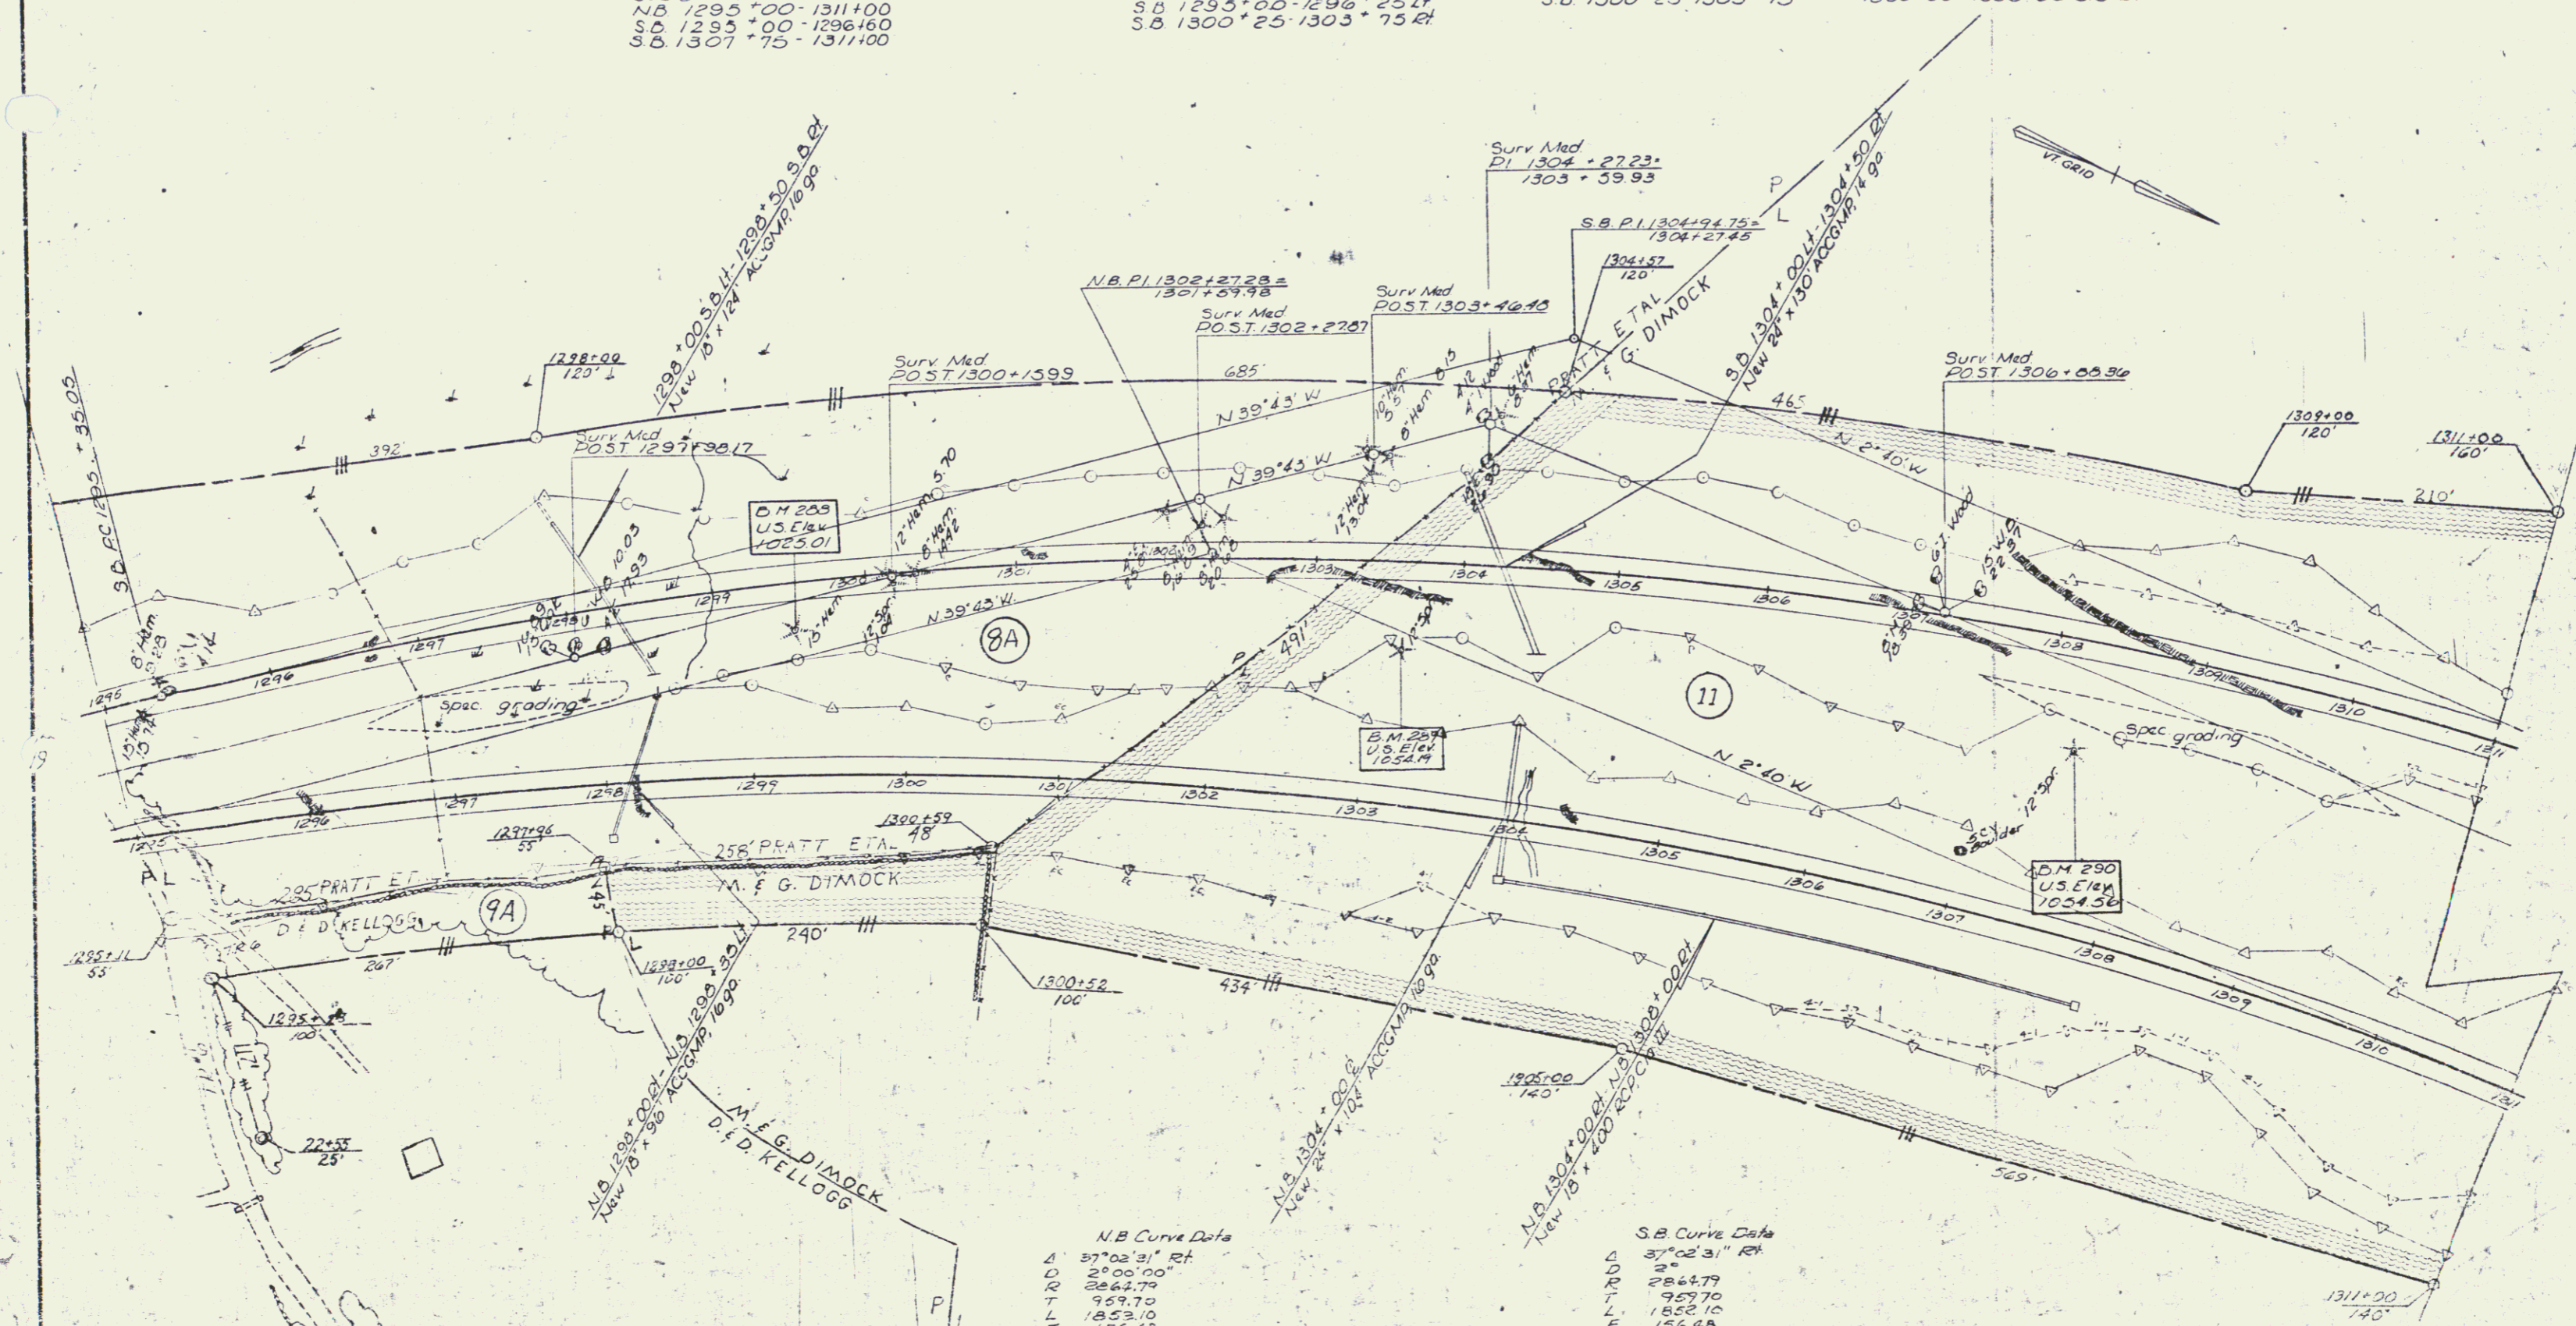

N.B. Curve Data  
 Δ 37°02'31" RT  
 D 2°00'00"  
 R 2864.79  
 T 959.70  
 L 1852.10  
 E 156.48  
 Bnt 361.71 (052%)

S.B. Curve Data  
 Δ 37°02'31" RT  
 D 2°00'00"  
 R 2864.79  
 T 959.70  
 L 1852.10  
 E 156.48  
 Bnt 361.71 (052%)

SECTION II  
 0 25 50 100 150  
 SCALE

VERMONT DEPARTMENT OF HIGHWAYS  
 RIGHT-OF-WAY PLANS  
 PROJECT: ROYALTON-BETHEL-RANDOLPH  
 No. 159-1(1+)  
 SHEET 17 23 OF 14