


THREE CABLE GUARD RAIL
 W/ STEEL POSTS ITEM 542
 1322+00-1327+00 NB LT
 1324+00-1327+00 NB RT
 1320+00-1327+00 SB RT
 1322+00-1325+52 SB LT

JUTE MATTING
 ITEM 623
 1317+25-1321+75 NB RT

DRILLING AND BLASTING OF
 SOLID ROCK SUBGRADE
 ITEM 115
 NB 1311+00-1319+75
 SB 1311+00-1320+10

BITUM CONC CURB
 ITEM 305
 1325+50-1327+00 NB LT

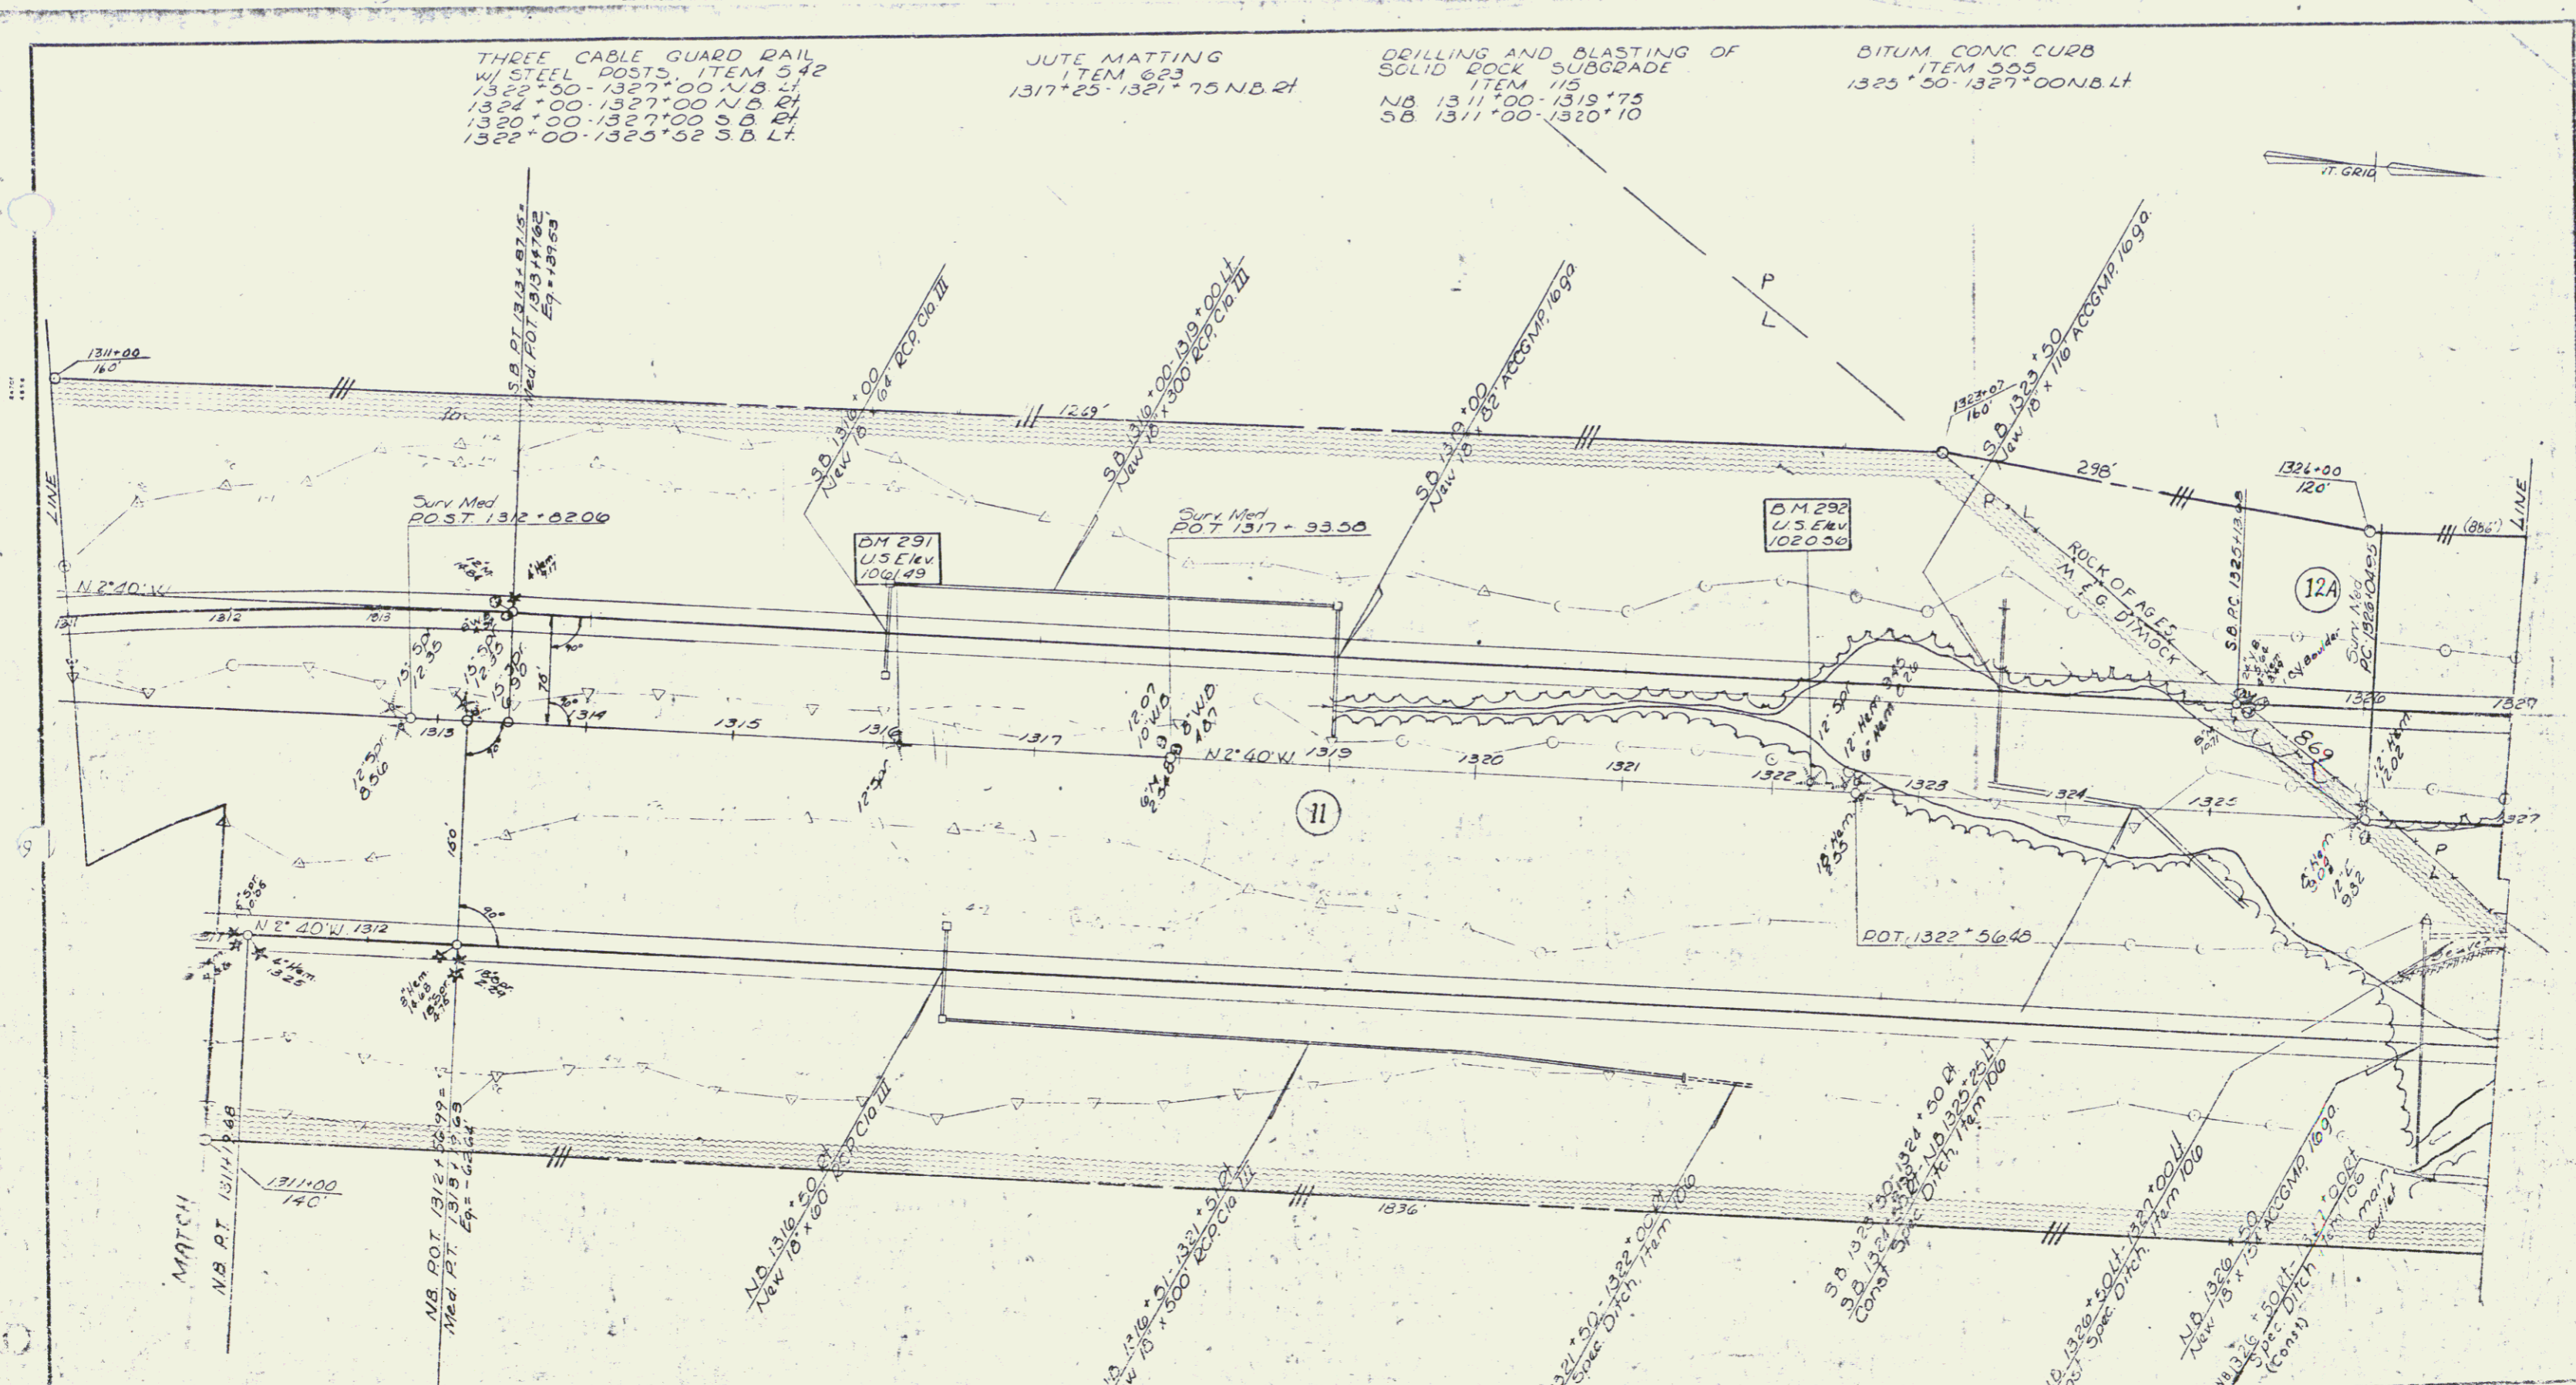

SECTION II
 0 25 50 100 150
 SCALE

VERMONT DEPARTMENT OF HIGHWAYS
 RIGHT-OF-WAY PLANS
 PROJECT ROYALTON-BETHEL-RANDOLPH
 NO 189-1(1)
 SHEET 18 **24** OF 44