


DRILLING & BLASTING OF SOLID
ROCK SUBGRADE, ITEM 115
1359+00 - 1362+60 NB
1359+00 - 1360+75 SB

JUTE MATTING, ITEM 623
1363+00 - 1369+25 NB LT
1367+00 - 1374+75 SB LT

THREE CABLE GUARD RAIL
ITEM 542
1374+00 - 1375+00 SB LT
1365+50 - 1375+00 NB LT

BIT CONC. CURB, ITEM 555
1374+50 - 1375+00 SB LT
1368+00 - 1370+50 NB LT

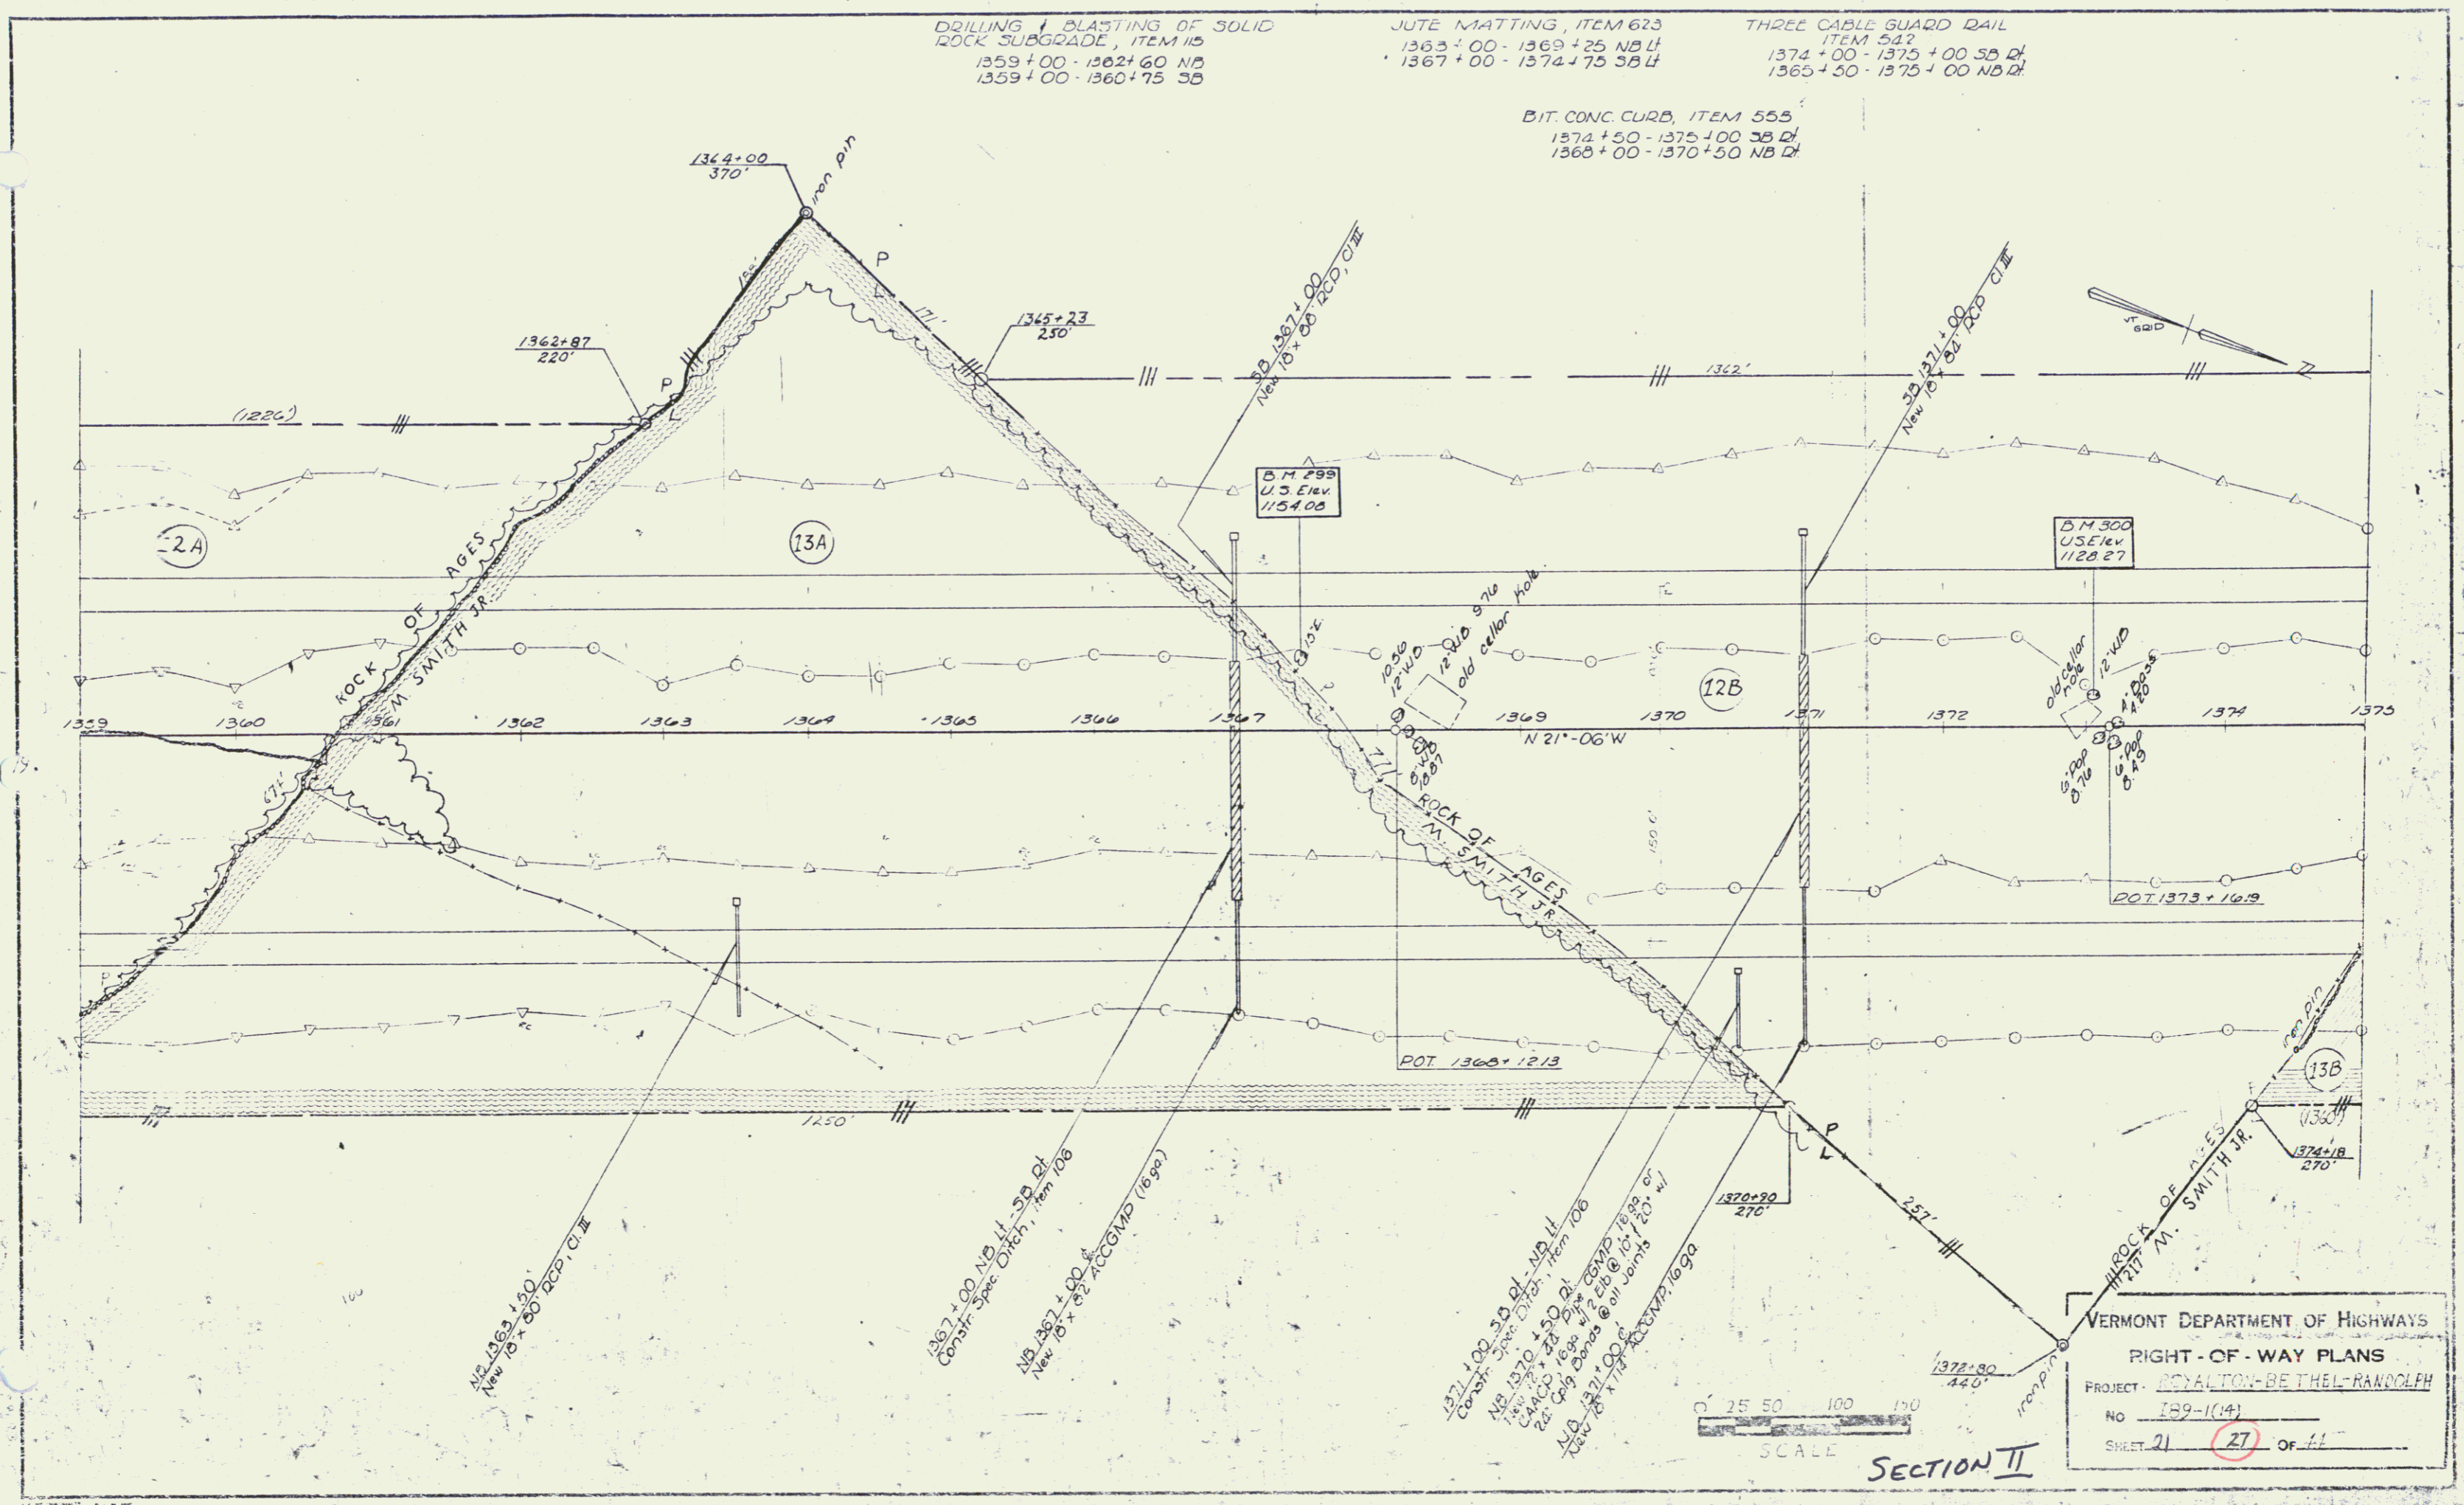

VERMONT DEPARTMENT OF HIGHWAYS
RIGHT-OF-WAY PLANS
PROJECT: ROYALTON-BETHEL-RANDOLPH
NO. 189-1(14)
SHEET 21 **27** OF 41

SECTION II