
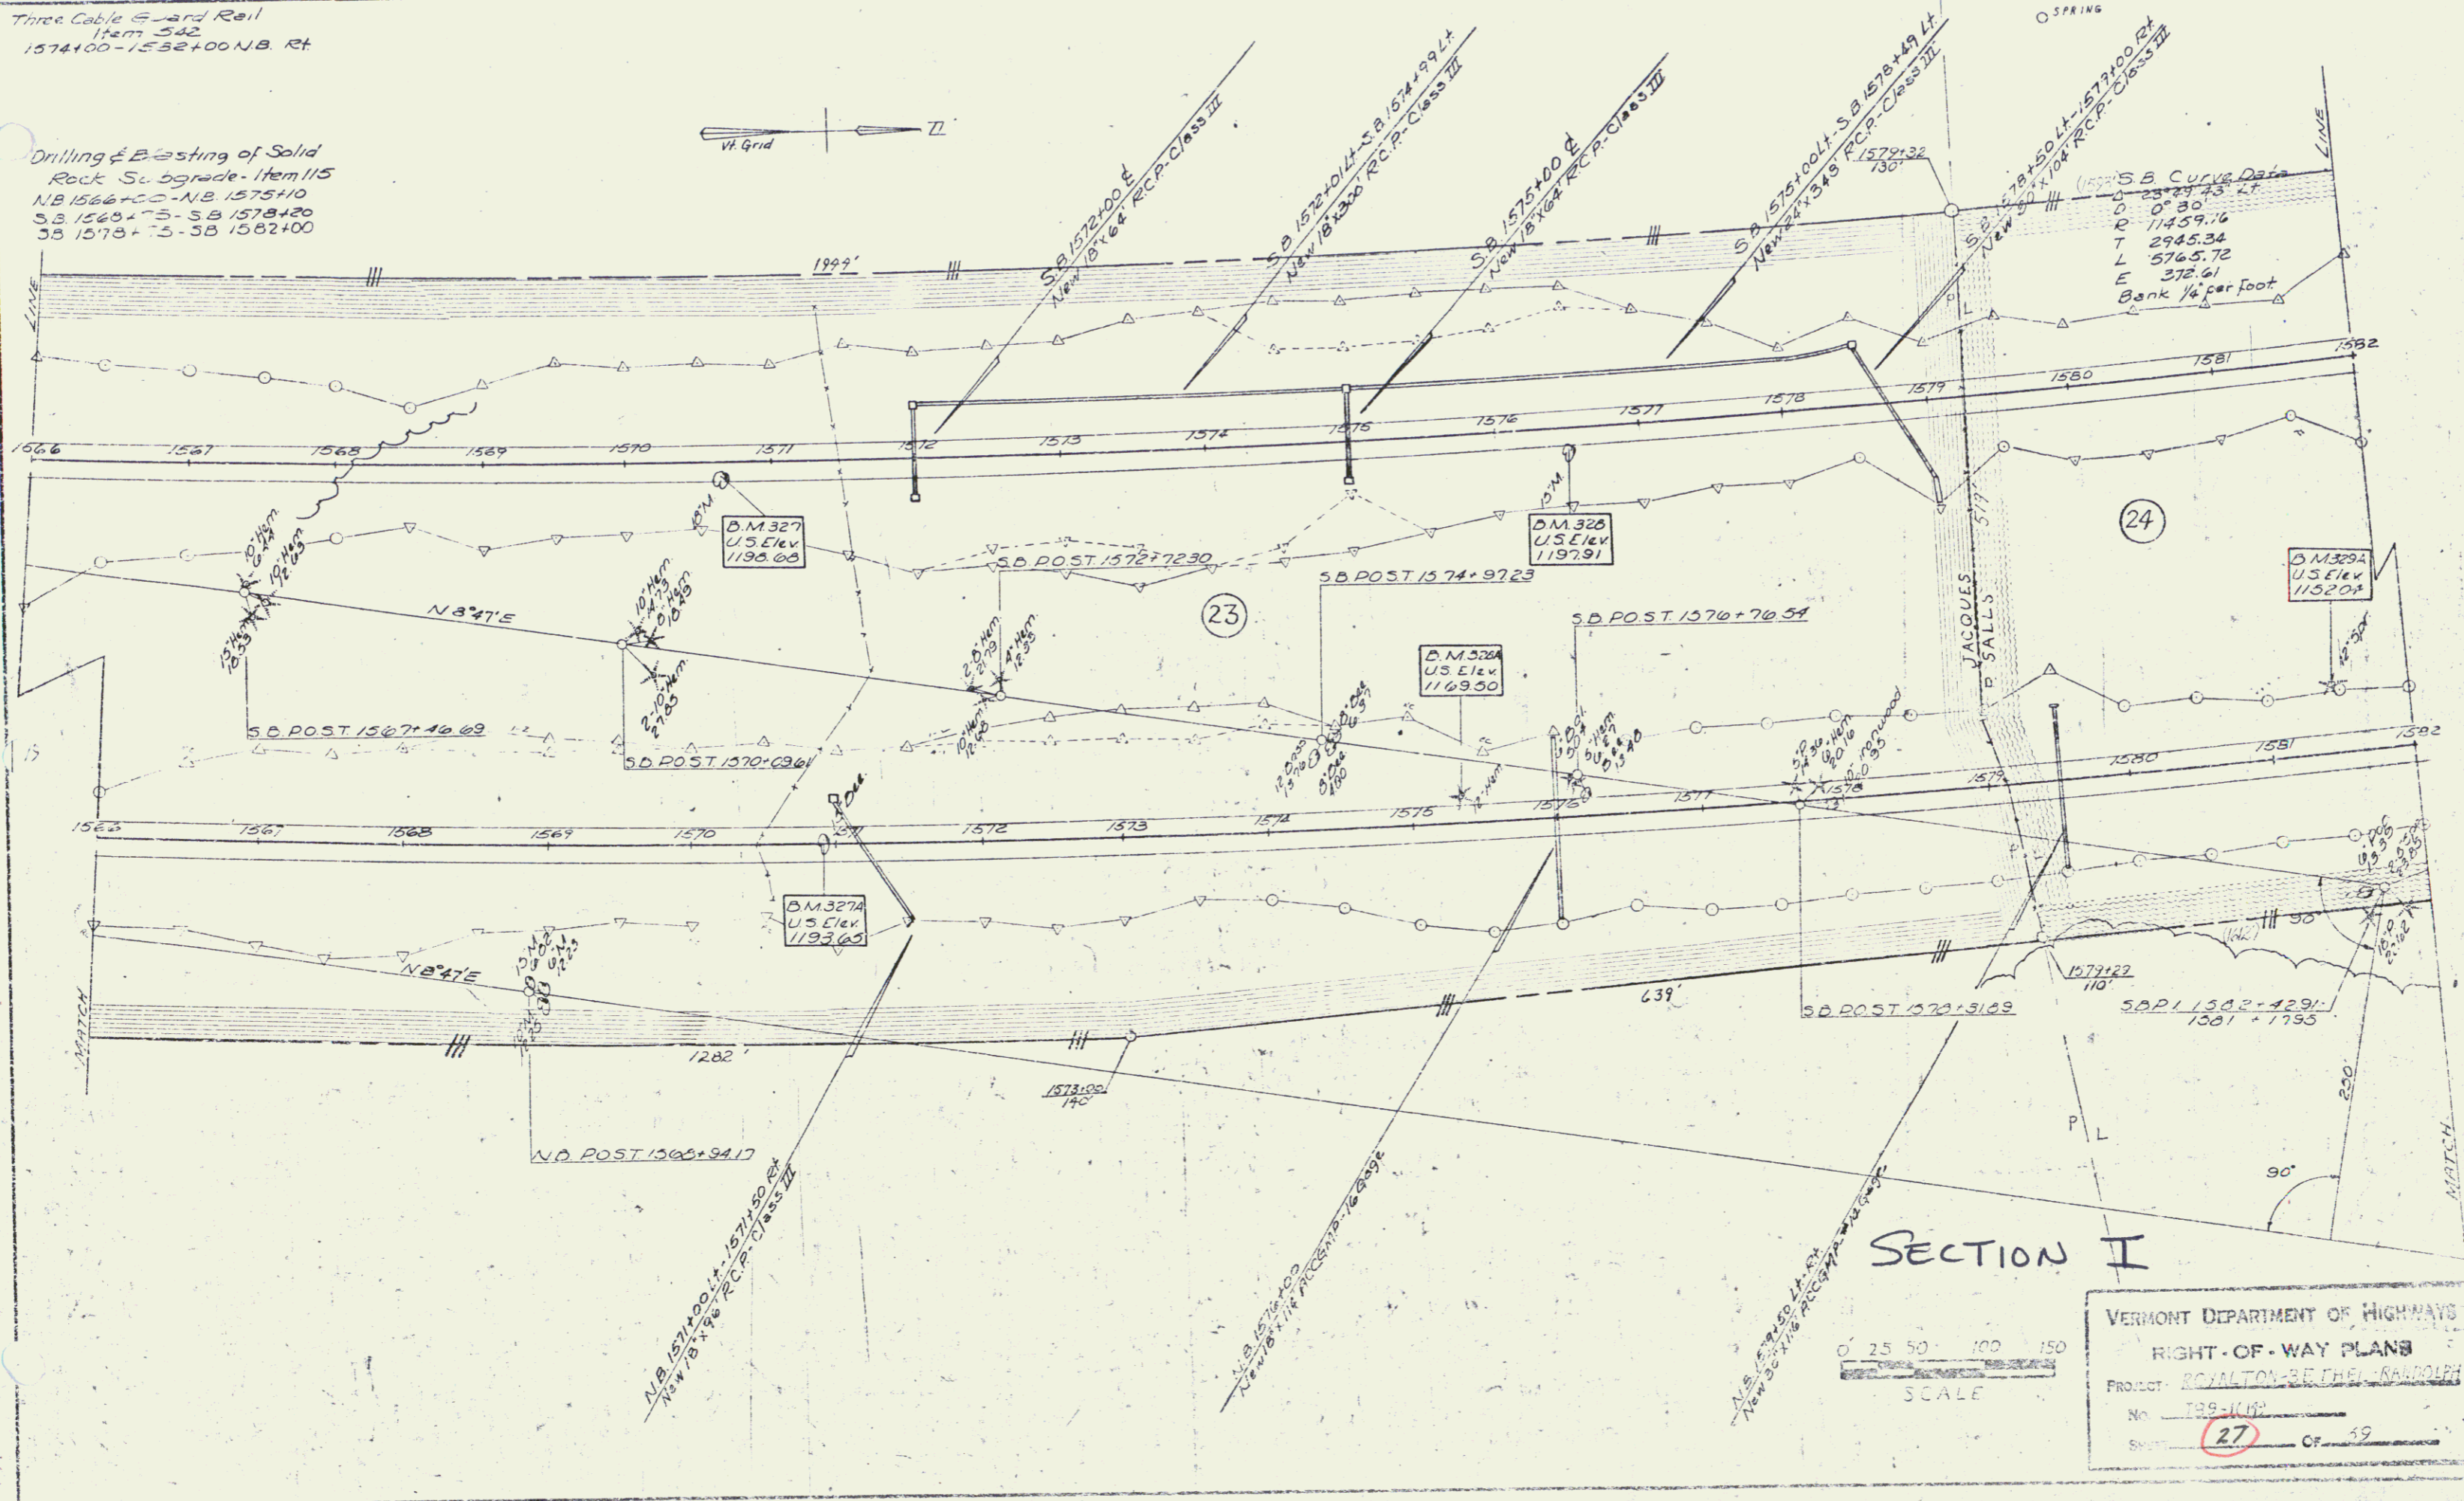


Three Cable Strand Rail  
Item 542  
1574100-1582+00 N.B. RT

Drilling & Blasting of Solid  
Rock Subgrade. Item 115  
NB 1566+00-NB 1575+10  
SB 1569+75-SB 1578+20  
SB 1579+75-SB 1582+00

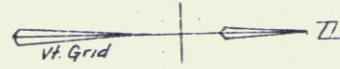

0 25 50 100 150  
SCALE