


THREE CABLE GUAR. RAIL
ITEM 542
SB 1653*50LT-1660*00



DM 333
U.S. ERY
171.63

DM 339
U.S. ERY
114.23

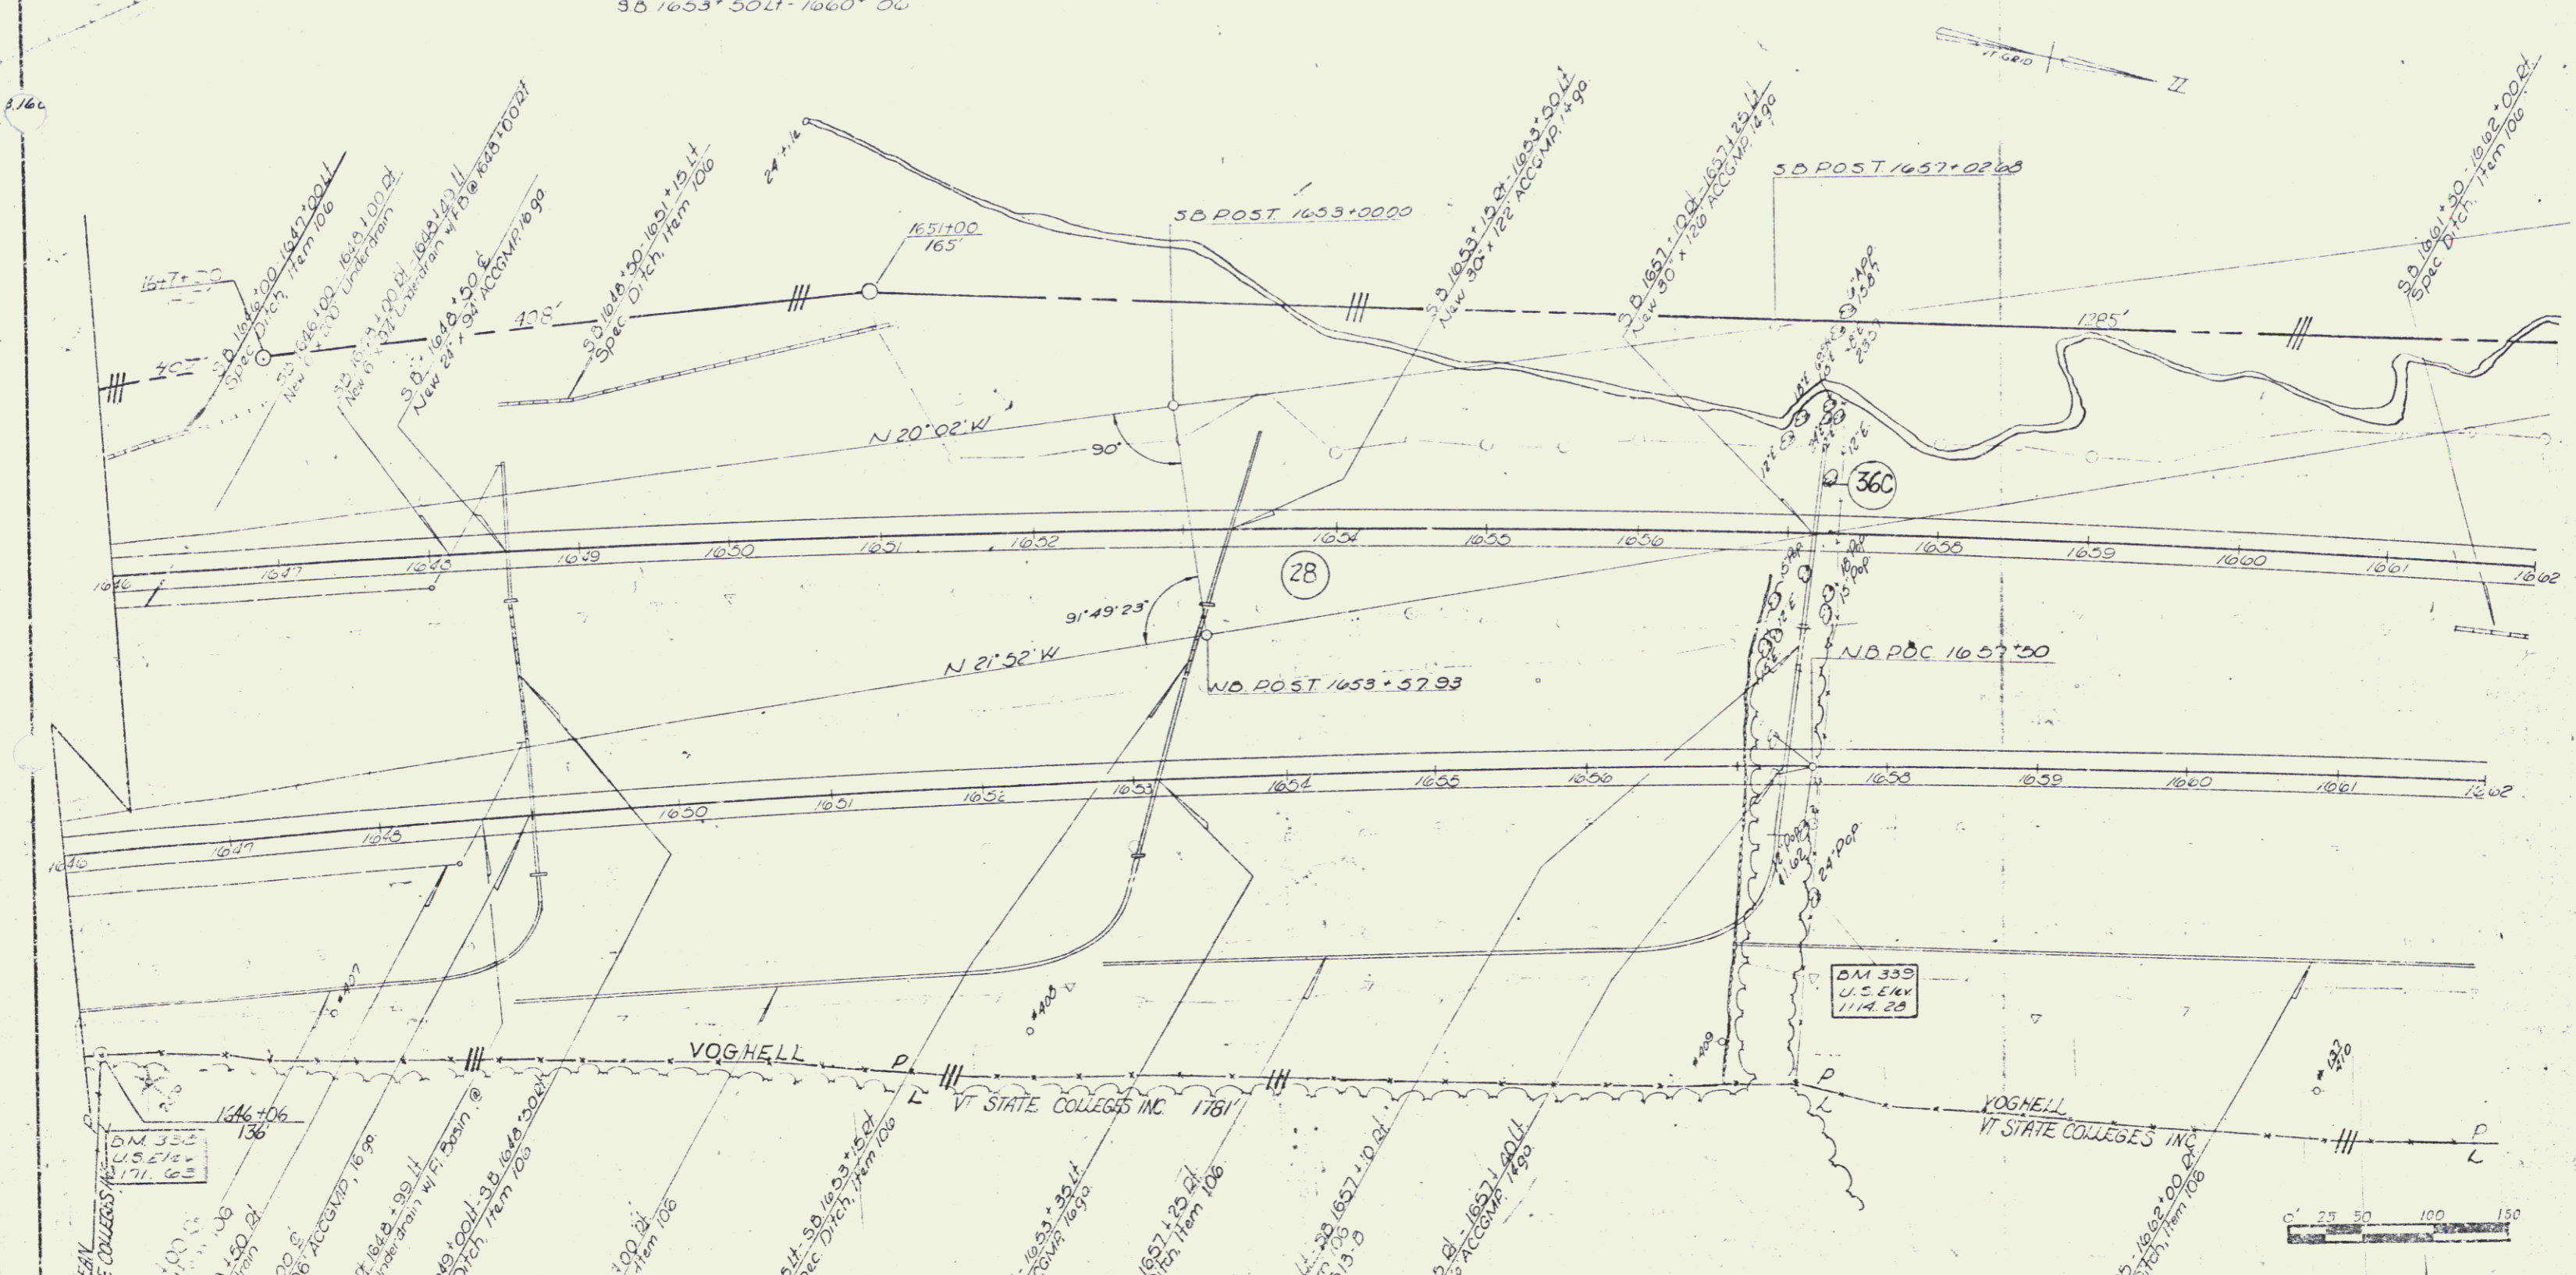

SECTION I

VERMONT DEPARTMENT OF HIGHWAYS-
RIGHT-OF-WAY PLANS
PROJECT ROYALTON-BETHEL RANDOLPH
NO 189-114
SHEET 32 OF 59