


\* THREE CABLE GUARD RAIL,  
LIGHT STEEL POSTS, ITEM 538  
1321\*50-1325\*98 S.B. II  
1323\*50-1327\*00 N.B. II

JUTE MATTING  
ITEM 623

DRILLING AND BLASTING OF  
SOLID ROCK SUBGRADE  
ITEM 115  
N.B. 1311\*00-1319\*75  
S.B. 1311\*00-1320\*10

PROPERTY LINE FENCE, MOD., ITEM 583-II  
S.B. 1311\*00-1327\*00 LT.  
N.B. 1311\*00-1327\*00 RT.

\* DENOTES STAGE 2 CONSTRUCTION

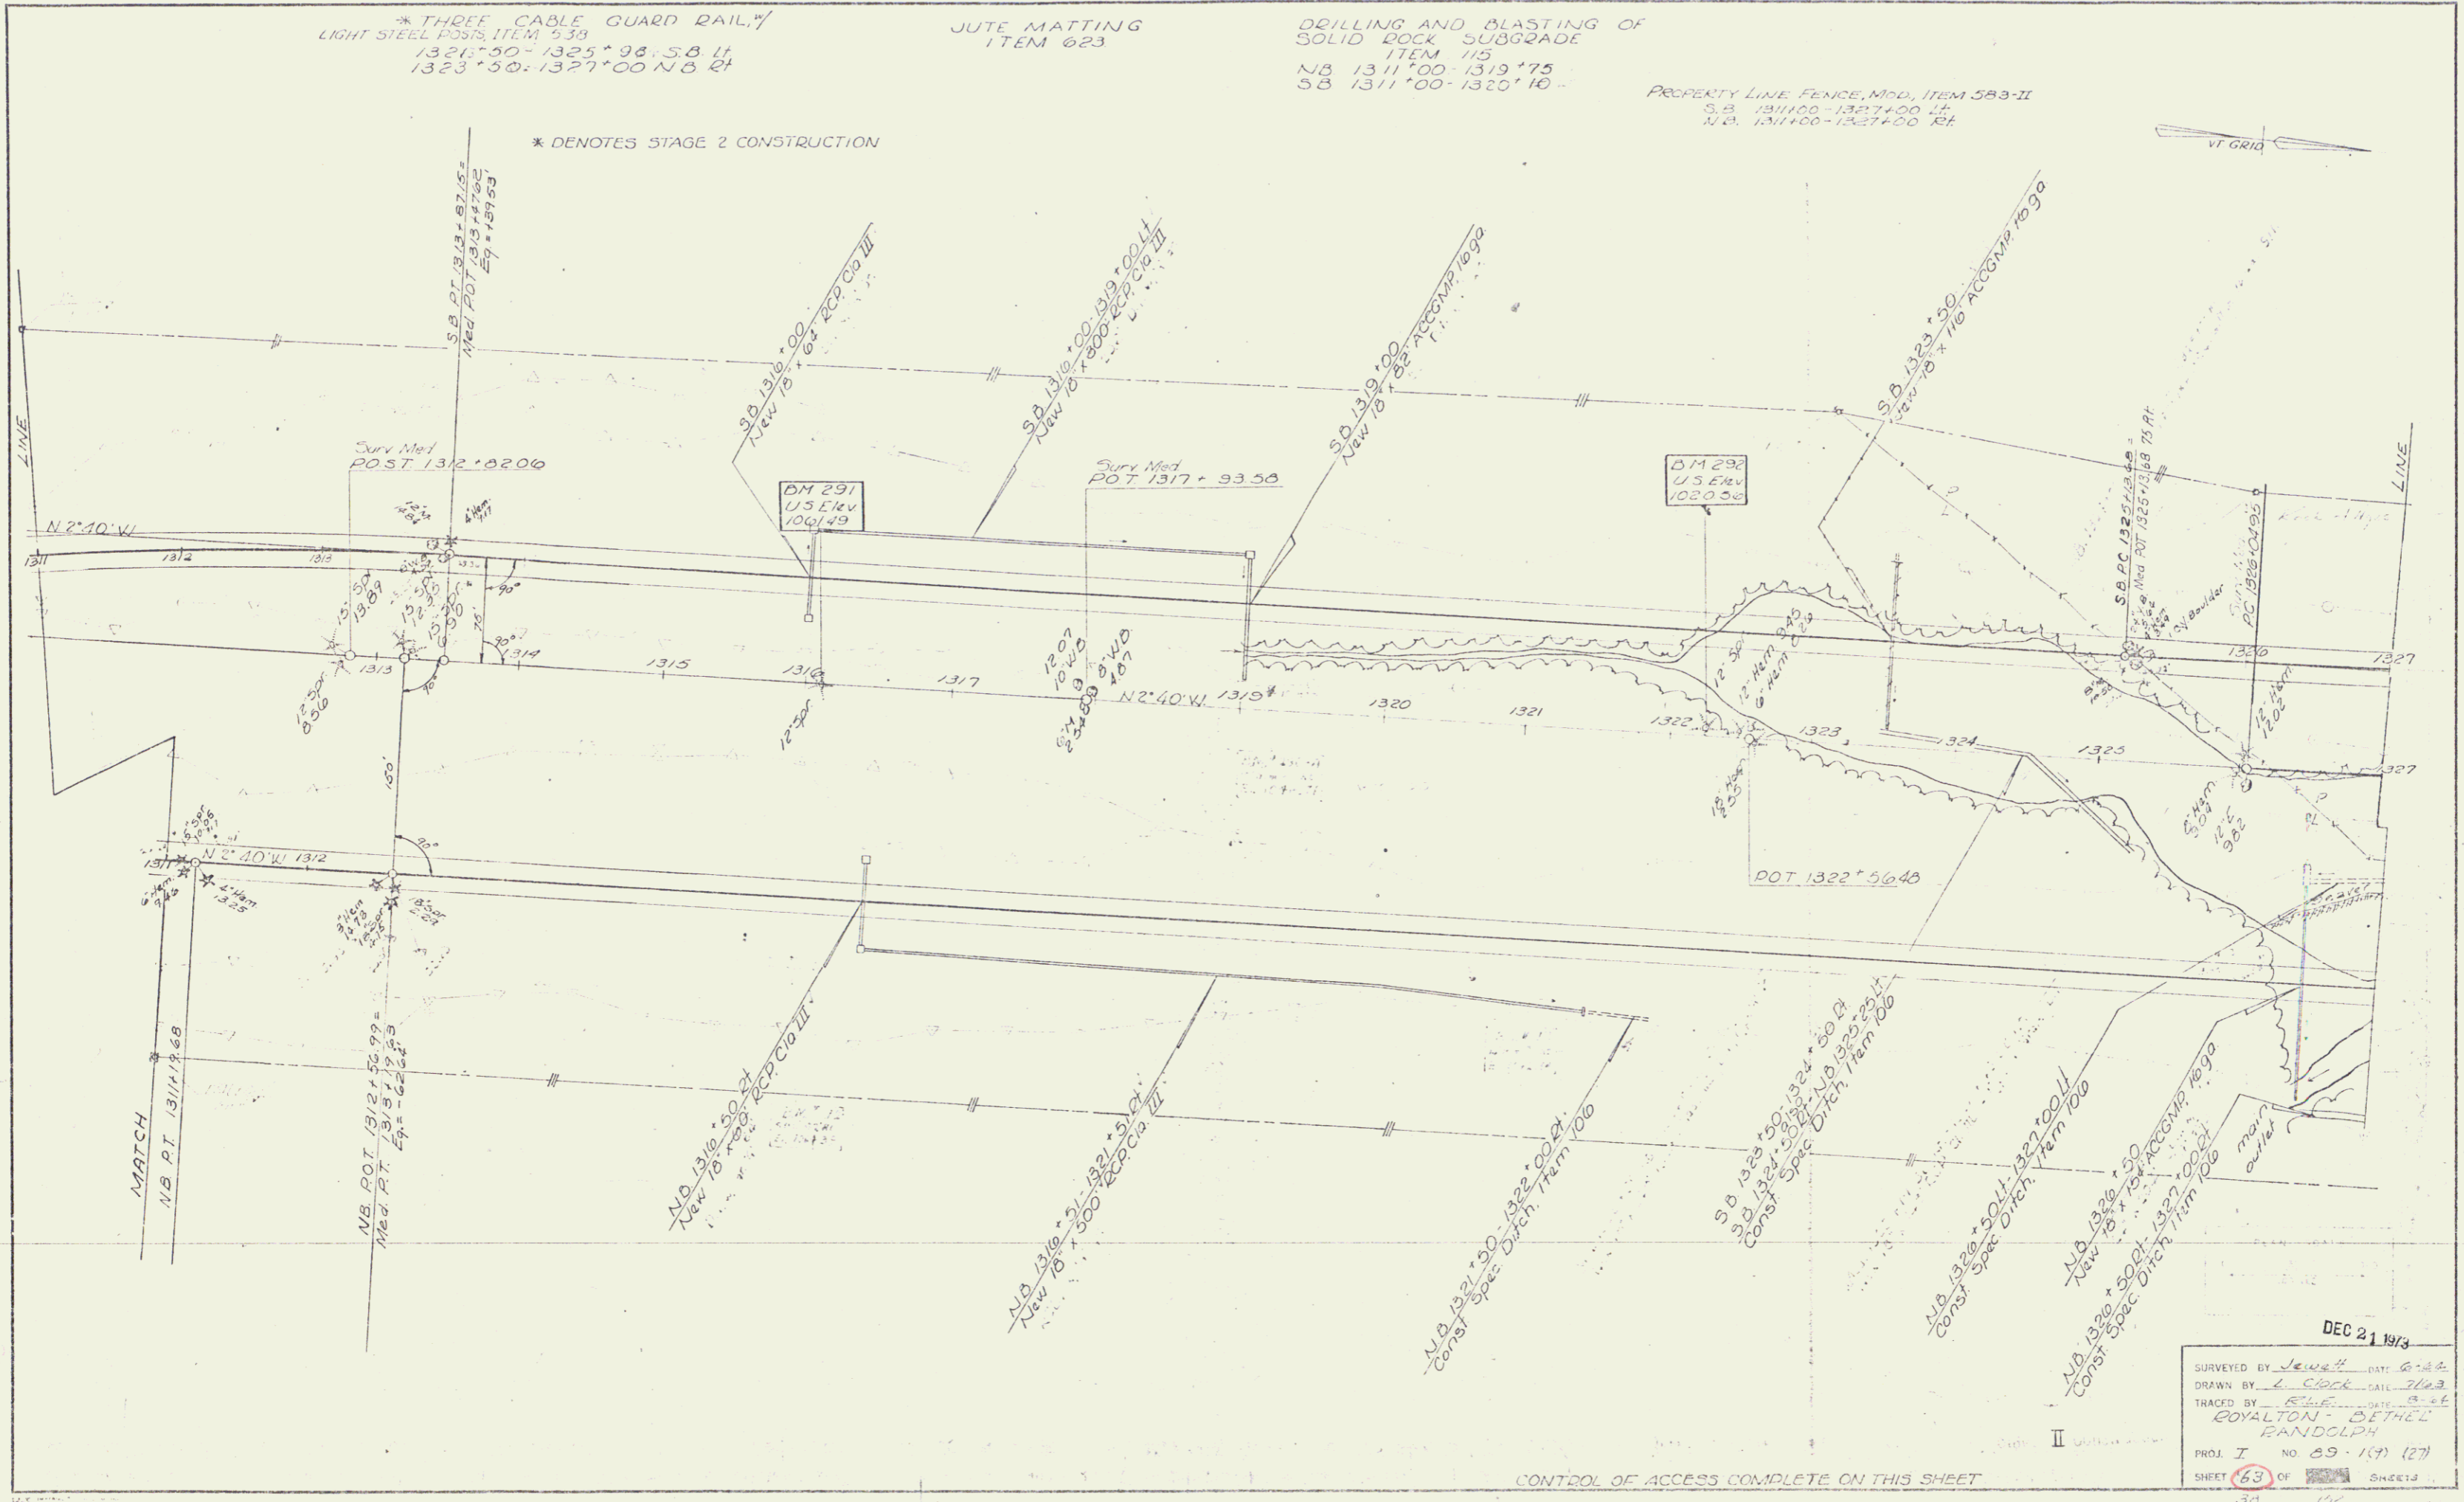

DEC 21 1973

SURVEYED BY Jewett DATE 6-26-73  
DRAWN BY L. Cook DATE 11-23-73  
TRACED BY REBE DATE 12-11-73  
ROYALTON: DETHEL  
RANDOLPH

CONTROL OF ACCESS COMPLETE ON THIS SHEET

PROJ. I NO 89-1(7) (27)  
SHEET 63 OF 156 SHEETS  
30 156

69