

PROPERTY LINE FENCE, MCD, ITEM 583-12  
 S.D. 1327+00 - 1343+00 Lt  
 N.B. 1327+00 - 1343+00 Rt

STONE FILL FOR SLOPE PROTECTION  
 ITEM 512  
 1327+75 - 1330+05 Rt


\* THREE CABLE GUARD RAIL w/  
 LIGHT STEEL POSTS, ITEM 513

\* TREATED TIMBER CURB  
 ITEM 515

MUCK EXCAVATION, ITEM 117  
 SB 1334+50 - 1337+00

1327+00 - 1339+50 N.B.Rt  
 1333+00 - 1340+00 S.B.Lt  
 \* DENOTES STAGE 2 CONSTRUCTION

Met & S.B. Data  
 1327+00  
 1328+00  
 1329+00  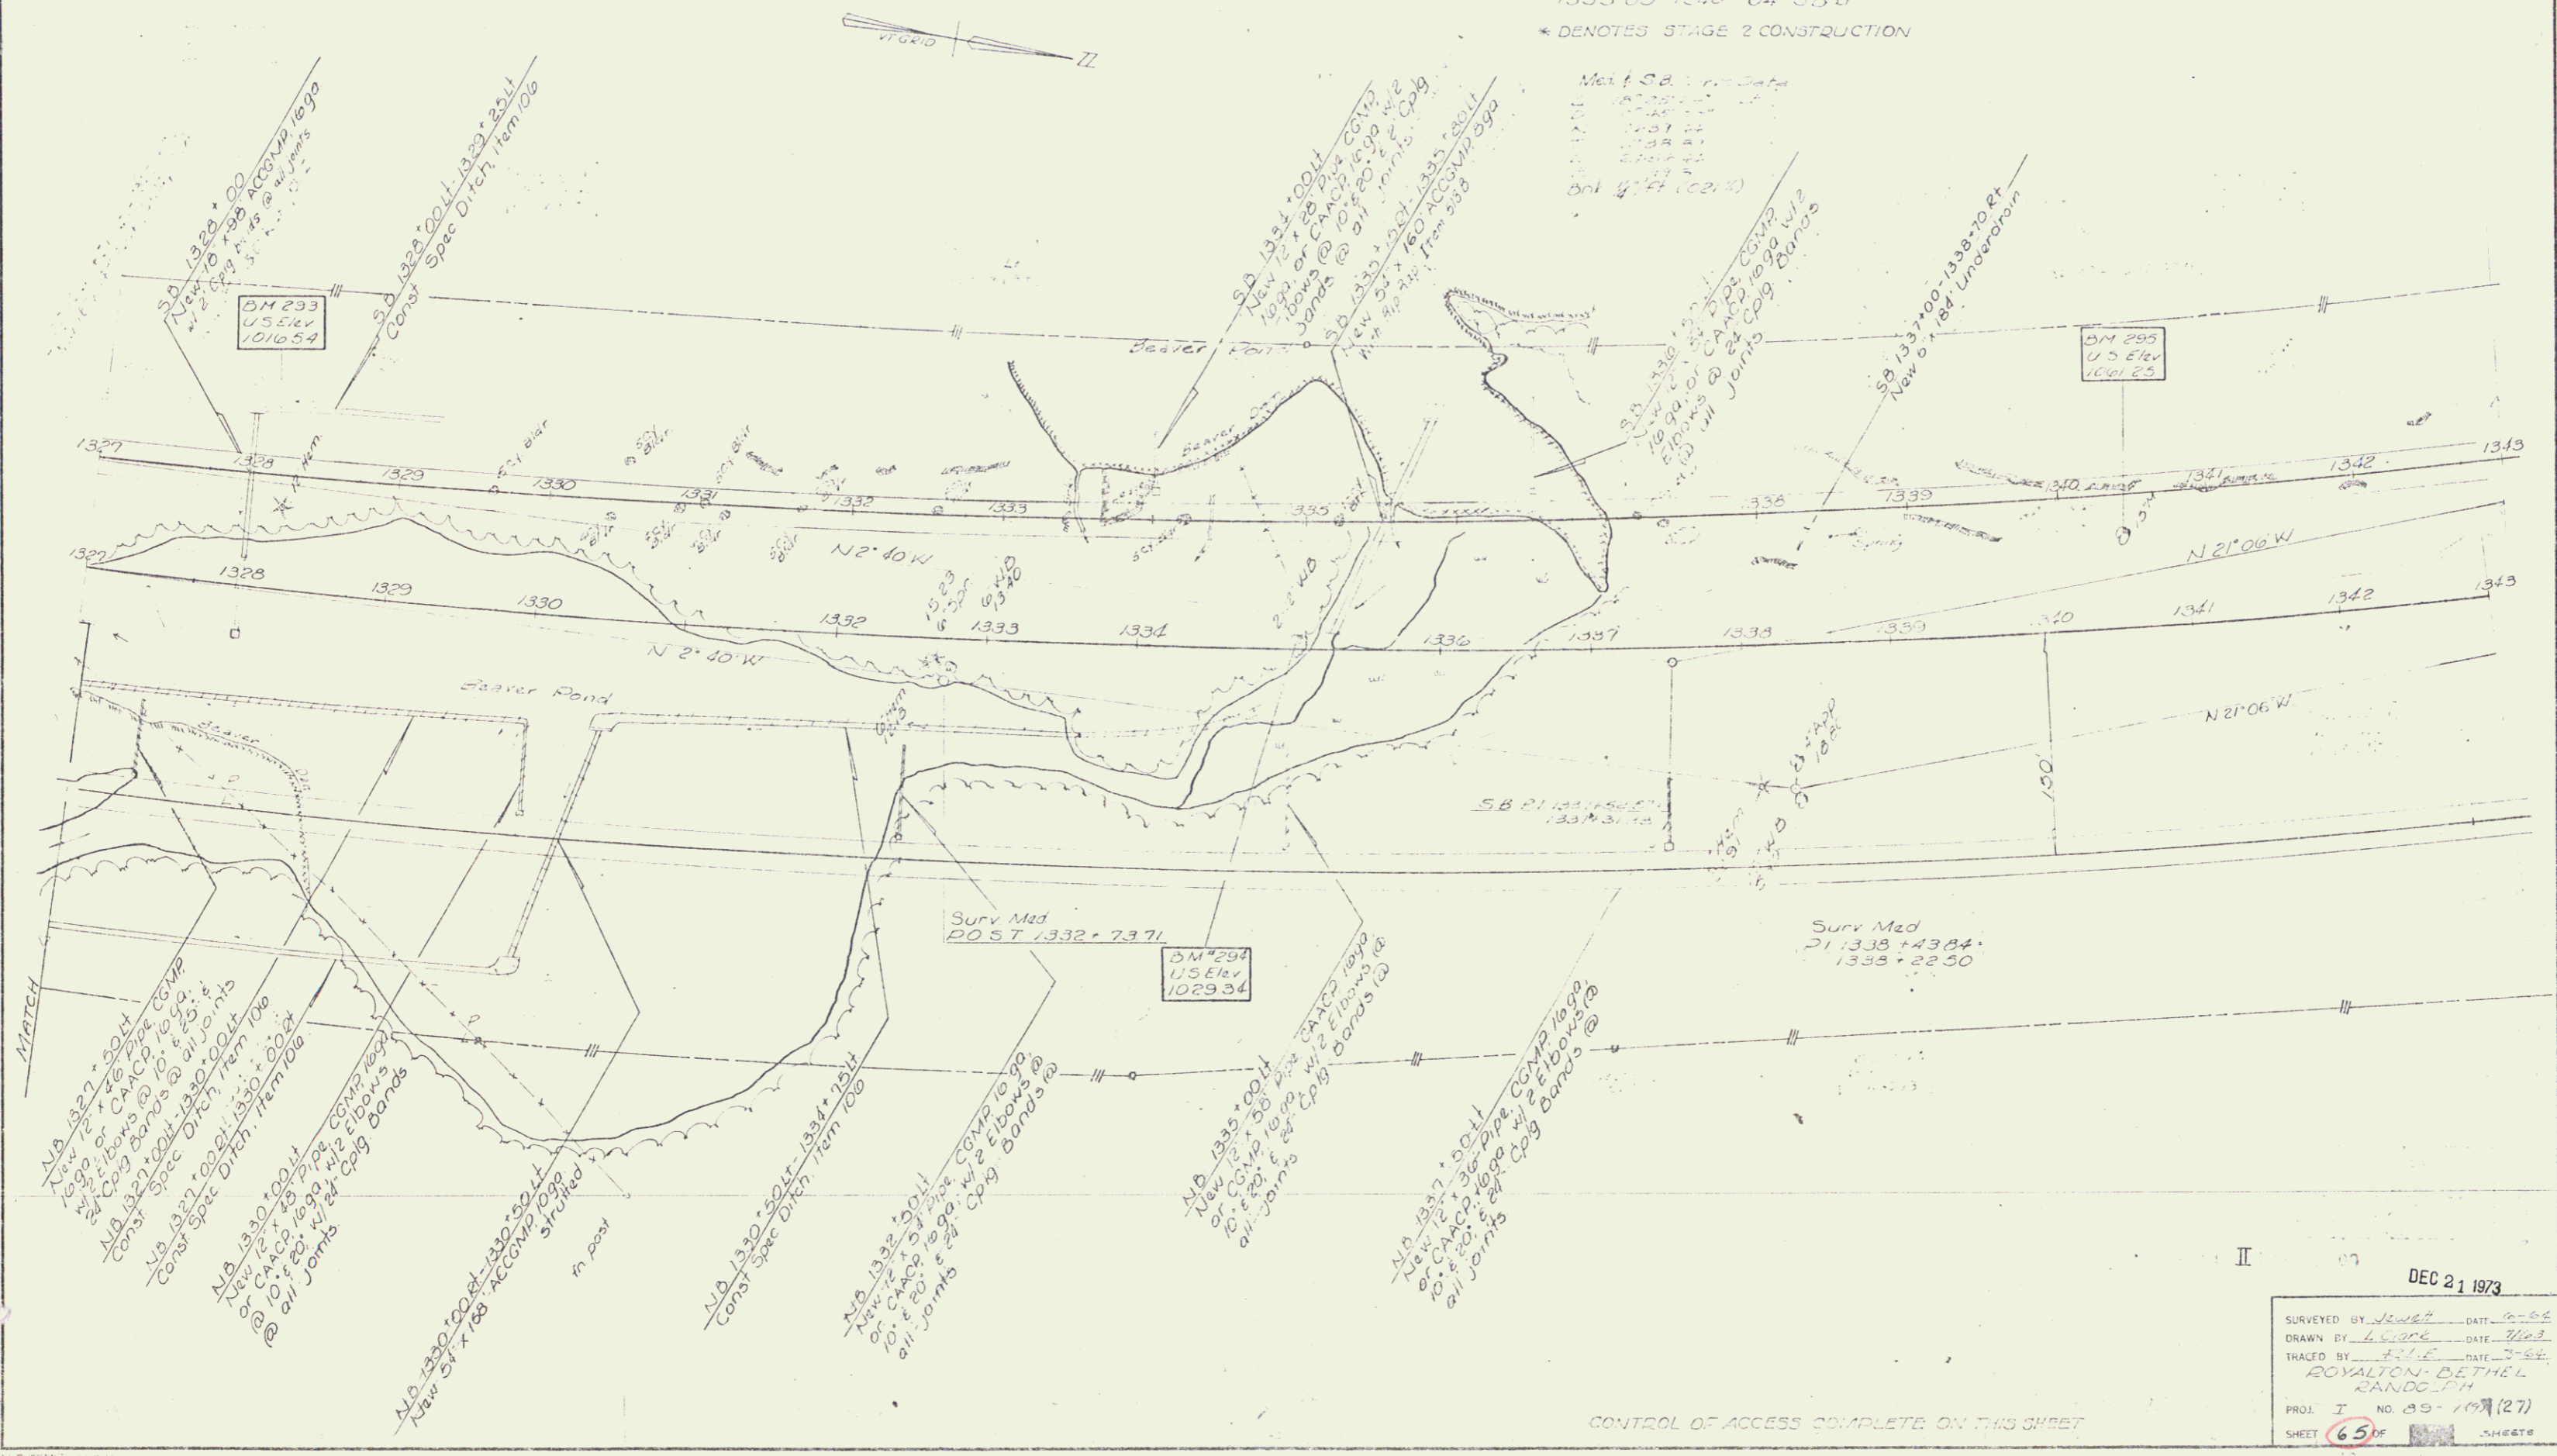
CONTROL OF ACCESS COMPLETE ON THIS SHEET

DEC 21 1973  
 SURVEYED BY L. Spack DATE 10-5-73  
 DRAWN BY L. Spack DATE 11-3-73  
 TRACED BY F. L. E. DATE 1-2-74  
 ROYALTON-BETHEL  
 RANDOLPH  
 PROJ. I NO. 89-109 (27)  
 SHEET 65 OF 100 SHEETS