


* Three Cable Guard Rail (LIGHT STEEL POST) ITEM 538
 1504+30-1518+00 SB Rt 1502+00-1517+18 NB Rt
 1504+40-1518+00 SB Lt 1504+30-1517+42 NB Lt

* TREATED TIMBER CORB, ITEM 358
 1506+00-1518+00 SB Rt
 1507+00-1518+00 SB Lt
 1505+00-1518+50 NB Rt
 1508+00-1518+50 NB Lt

ALL FENCE TO BE ERECTED PRIOR TO CONSTRUCTION NB 1502+00 - 1517+45 Rt

WIRE MATTING ITEM 623 NB 1502+00 - 1517+25 Lt

* DENOTES STAGE TWO CONSTRUCTION
 Drilling & Blasting of Solid Rock Subgrade - Item 116
 S.B. 1502+30-1506+10
 PROPERTY LINE FENCE, MOD. ITEM 588-II
 S.B. 1502+00-1518+00 Lt
 N.B. 1502+00-1518+00 Rt

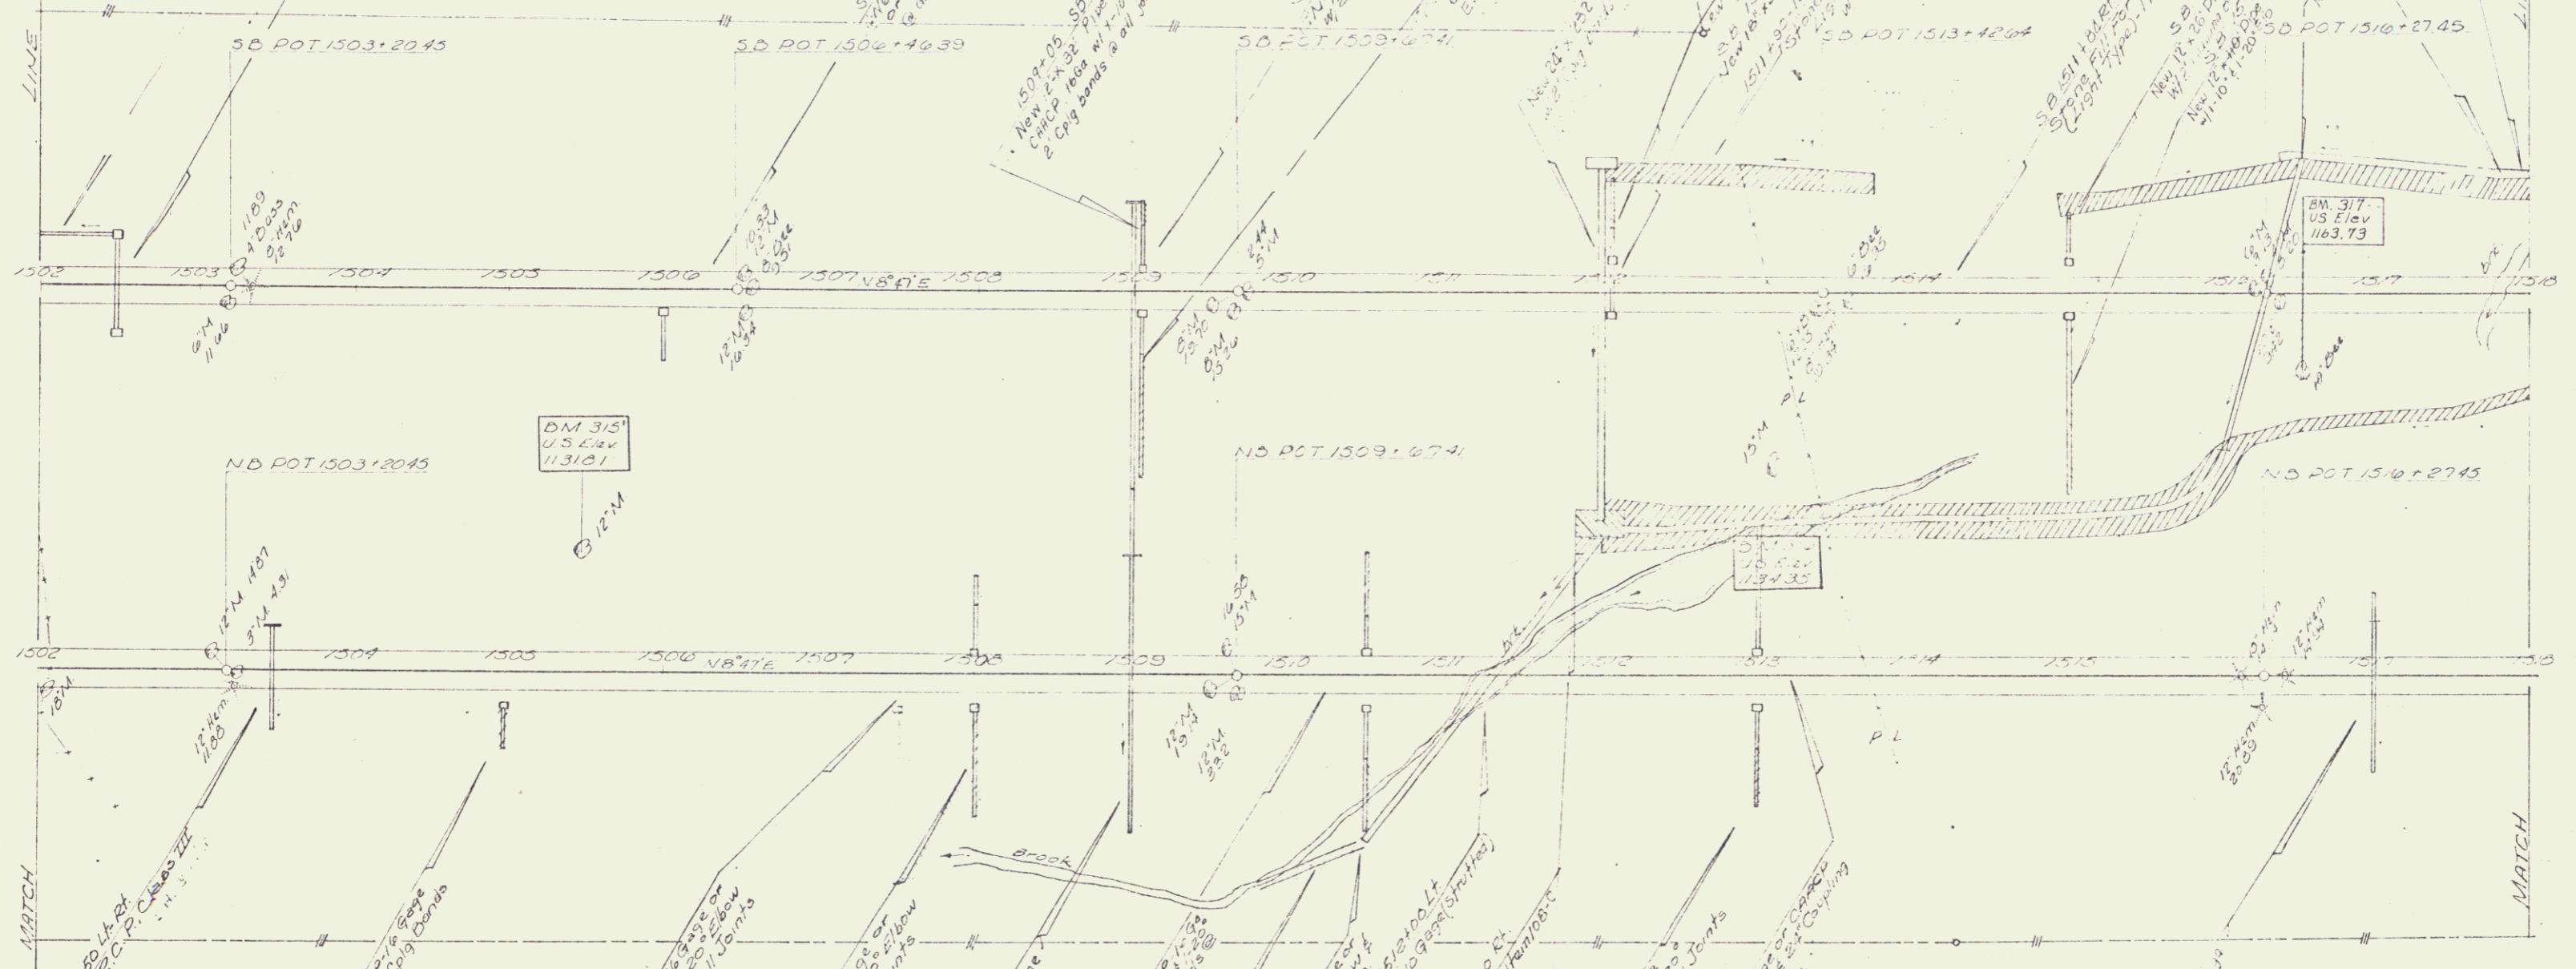

DEC 21 1973
 SURVEYED BY Jewell DATE 9/63
 DRAWN BY L. Cook DATE 9/63
 TRACED BY L. Cook DATE 9/63
 ROYALTON-BETHEL
 RANDOLPH
 PROJ. NO. 83-1(9)(27)
 SHEET 81 OF 81
 56 152

CONTROL OF ACCESS COMPLETE ON THIS SHEET