

* Three Cable Guard Rail
 Item 538
 NB 1573+00-1583+00 NB RT
 SB 1566+00-1567+11 SB RT

PROPERTY LINE FENCE, MOD. ITEM 53-II
 SB 1566+00-1582+00 Lt
 NB 1566+00-1582+00 Rt

MUCK EXCAVATION, Item 117
 NB 1580+50-1582+00
 SB 1570+00-1568+25


* DENOTES STAGE 2 CONSTRUCTION

Drilling & Blasting of Solid
 Rock Subgrade - Item 115
 NB 1566+00-NB 1575+10
 SB 1568+15-SB 1578+20
 SB 1578+15-SB 1582+00

* STANDARD STEEL BEAM
 GUARD RAIL ITEM 5-15E
 SB 1566+00-1567+00 RT



S.B. Curve Data
 C 23° 27' 43" Lt
 O 0° 30'
 R 11459.16
 T 2945.34
 L 5765.72
 E 372.61
 Bank 1/4 per foot

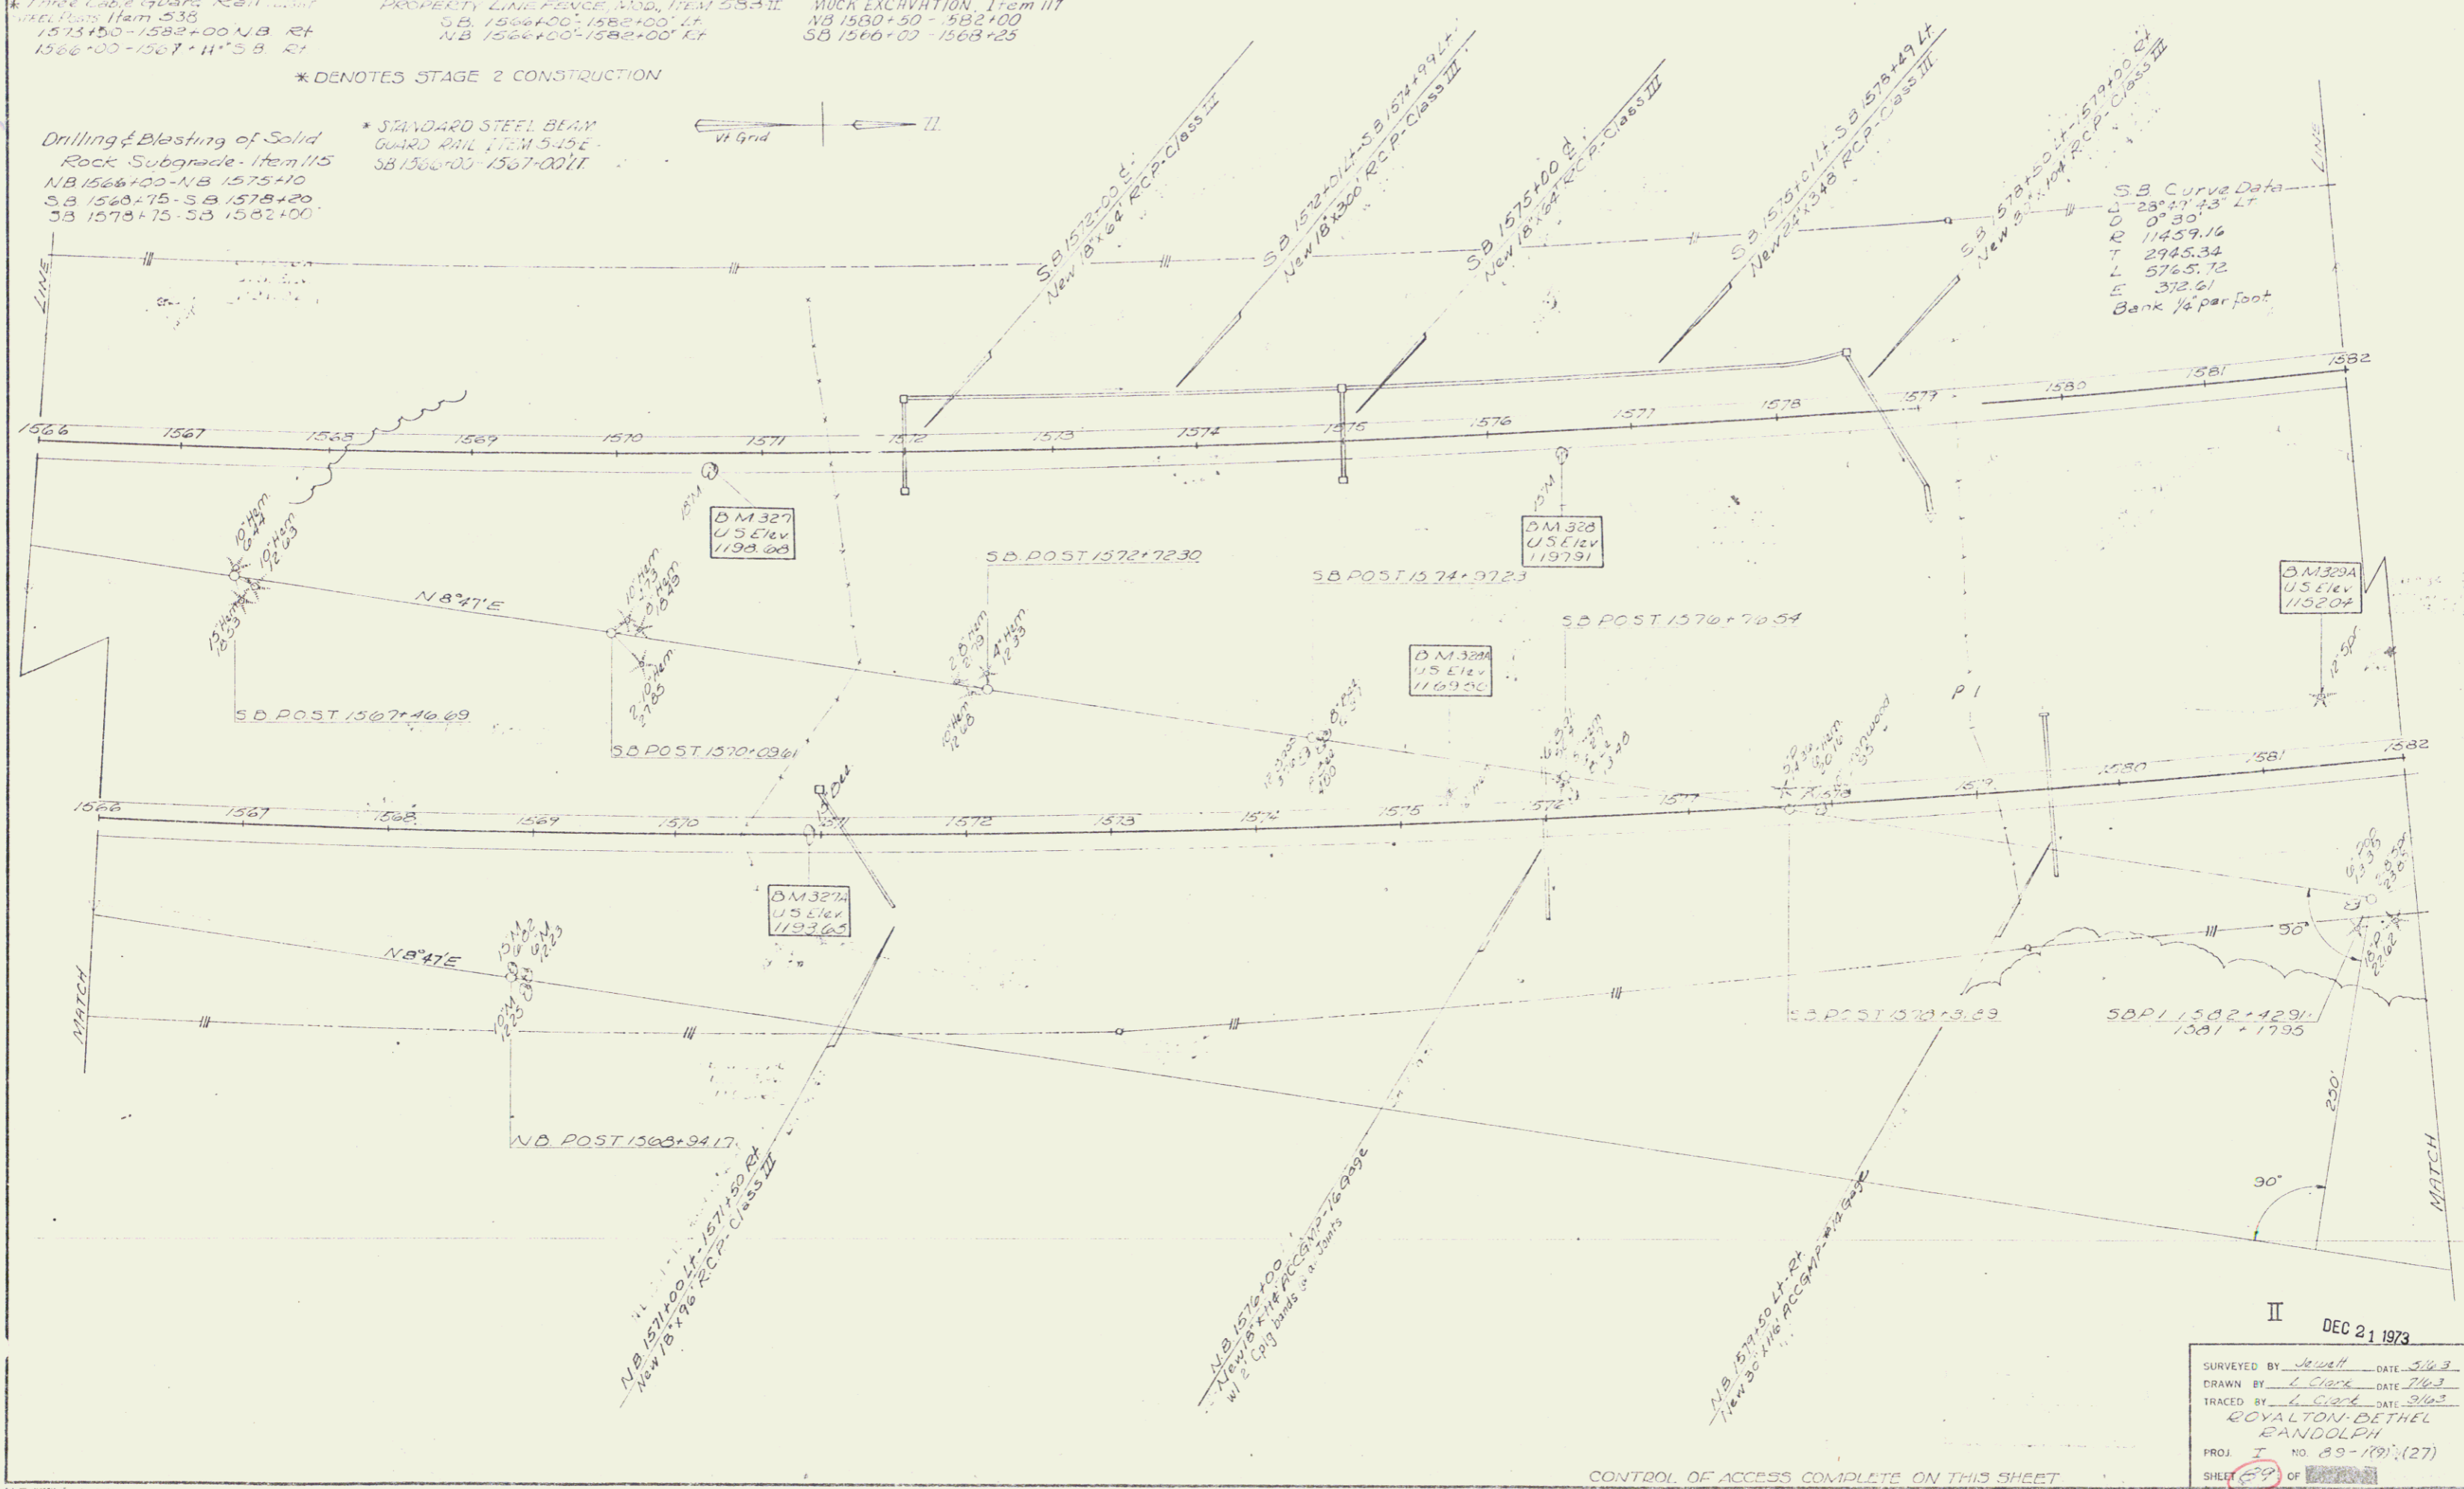

II
 DEC 21 1973

SURVEYED BY	Joseph	DATE	5/2/73
DRAWN BY	T. Clark	DATE	7/6/73
TRACED BY	T. Clark	DATE	3/6/73
ROYALTON-BETHEL RANDOLPH			
PROJ. NO.	89-197	(27)	
SHEET	69	OF	152

CONTROL OF ACCESS COMPLETE ON THIS SHEET