

MUCK EXCAVATION, Item 117
 1582+00-1590+50 NB
 1584+75-1587+25 SB
 1593+25-1598+00 SB

* Three Cable Guard Rail, Light
 Steel Posts, Item 538

Stone Fill For Slope Protection
 Item 512


* TREATED TIMBER CURB, ITEM 558

Drilling & Blasting of Solid Rock Subgrade-Item 115

N.B. 1582+00 RT-N.B. 1583+02 RT
 N.B. 1586+48 LT-N.B. 1578+00 LT
 S.B. 1584+52 RT-S.B. 1578+00 RT
 S.B. 1574+00 LT-S.B. 1578+00 LT

N.B. 1588+98-N.B. 1583+02 LT
 N.B. 1592+98 LT-N.B. 1573+02 LT
 N.B. 1596+98 LT-N.B. 1571+02 LT

* DENOTES STAGE 2 CONSTRUCTION

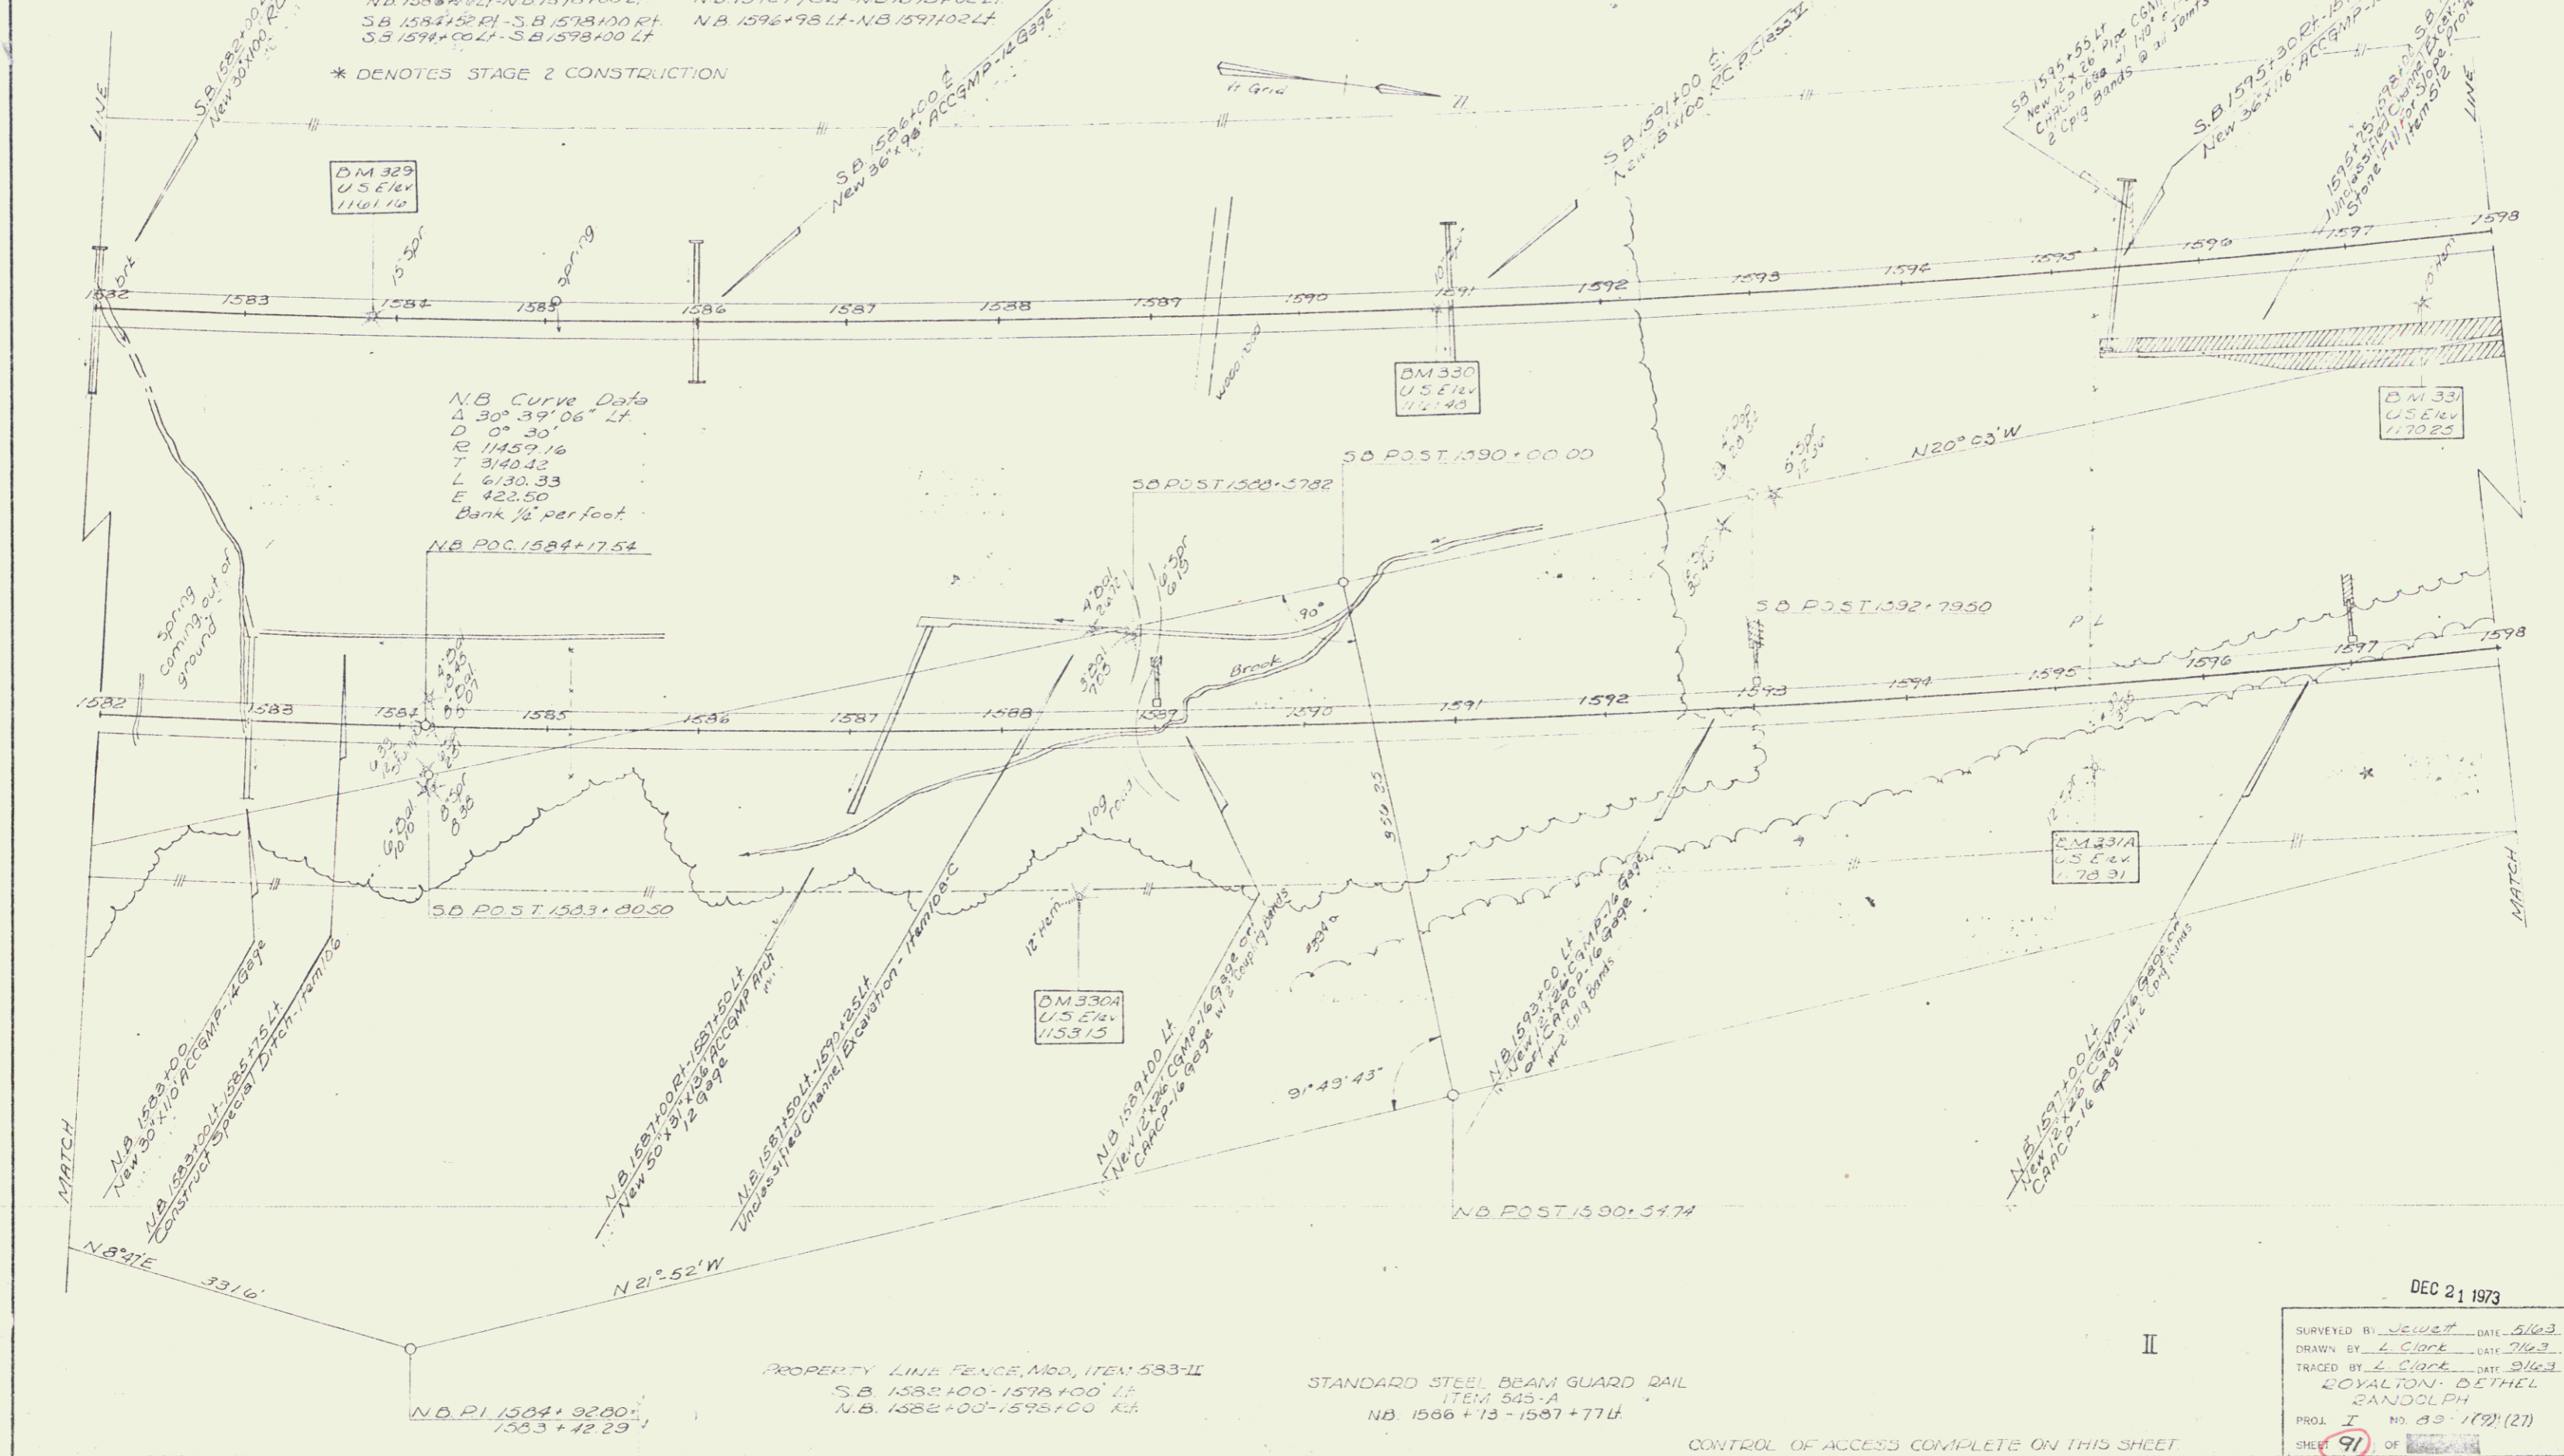

PROPERTY LINE FENCE, MCO, ITEM 533-II
 S.B. 1582+00-1578+00 LT
 N.B. 1582+00-1598+00 RT

STANDARD STEEL BEAM GUARD RAIL
 ITEM 545-A
 NB. 1586+73-1587+77 LT

CONTROL OF ACCESS COMPLETE ON THIS SHEET

DEC 21 1973
 SURVEYED BY SEWET DATE 5/63
 DRAWN BY L. CLACK DATE 7/63
 TRACED BY L. CLACK DATE 9/63
 ROYALTON, BETHEL
 SANDOLPH
 PROJ. I NO. 89-172(27)
 SHEET 91 OF 120