


BY REFERENCE TO EXHIBITED PRIOR
TO CONSTRUCTION
1631+90 - 1636+00 NB LI
1637+44 - 1646+00 SB LI

PROPERTY LINE FENCE, MOO
ITEM 503-II
SB 1630+00 - 1643+00 LI
NB 1630+00 - 1646+00 LI

CIPRAPP ITEM 513-B
1637+00 - 1643+00 LI

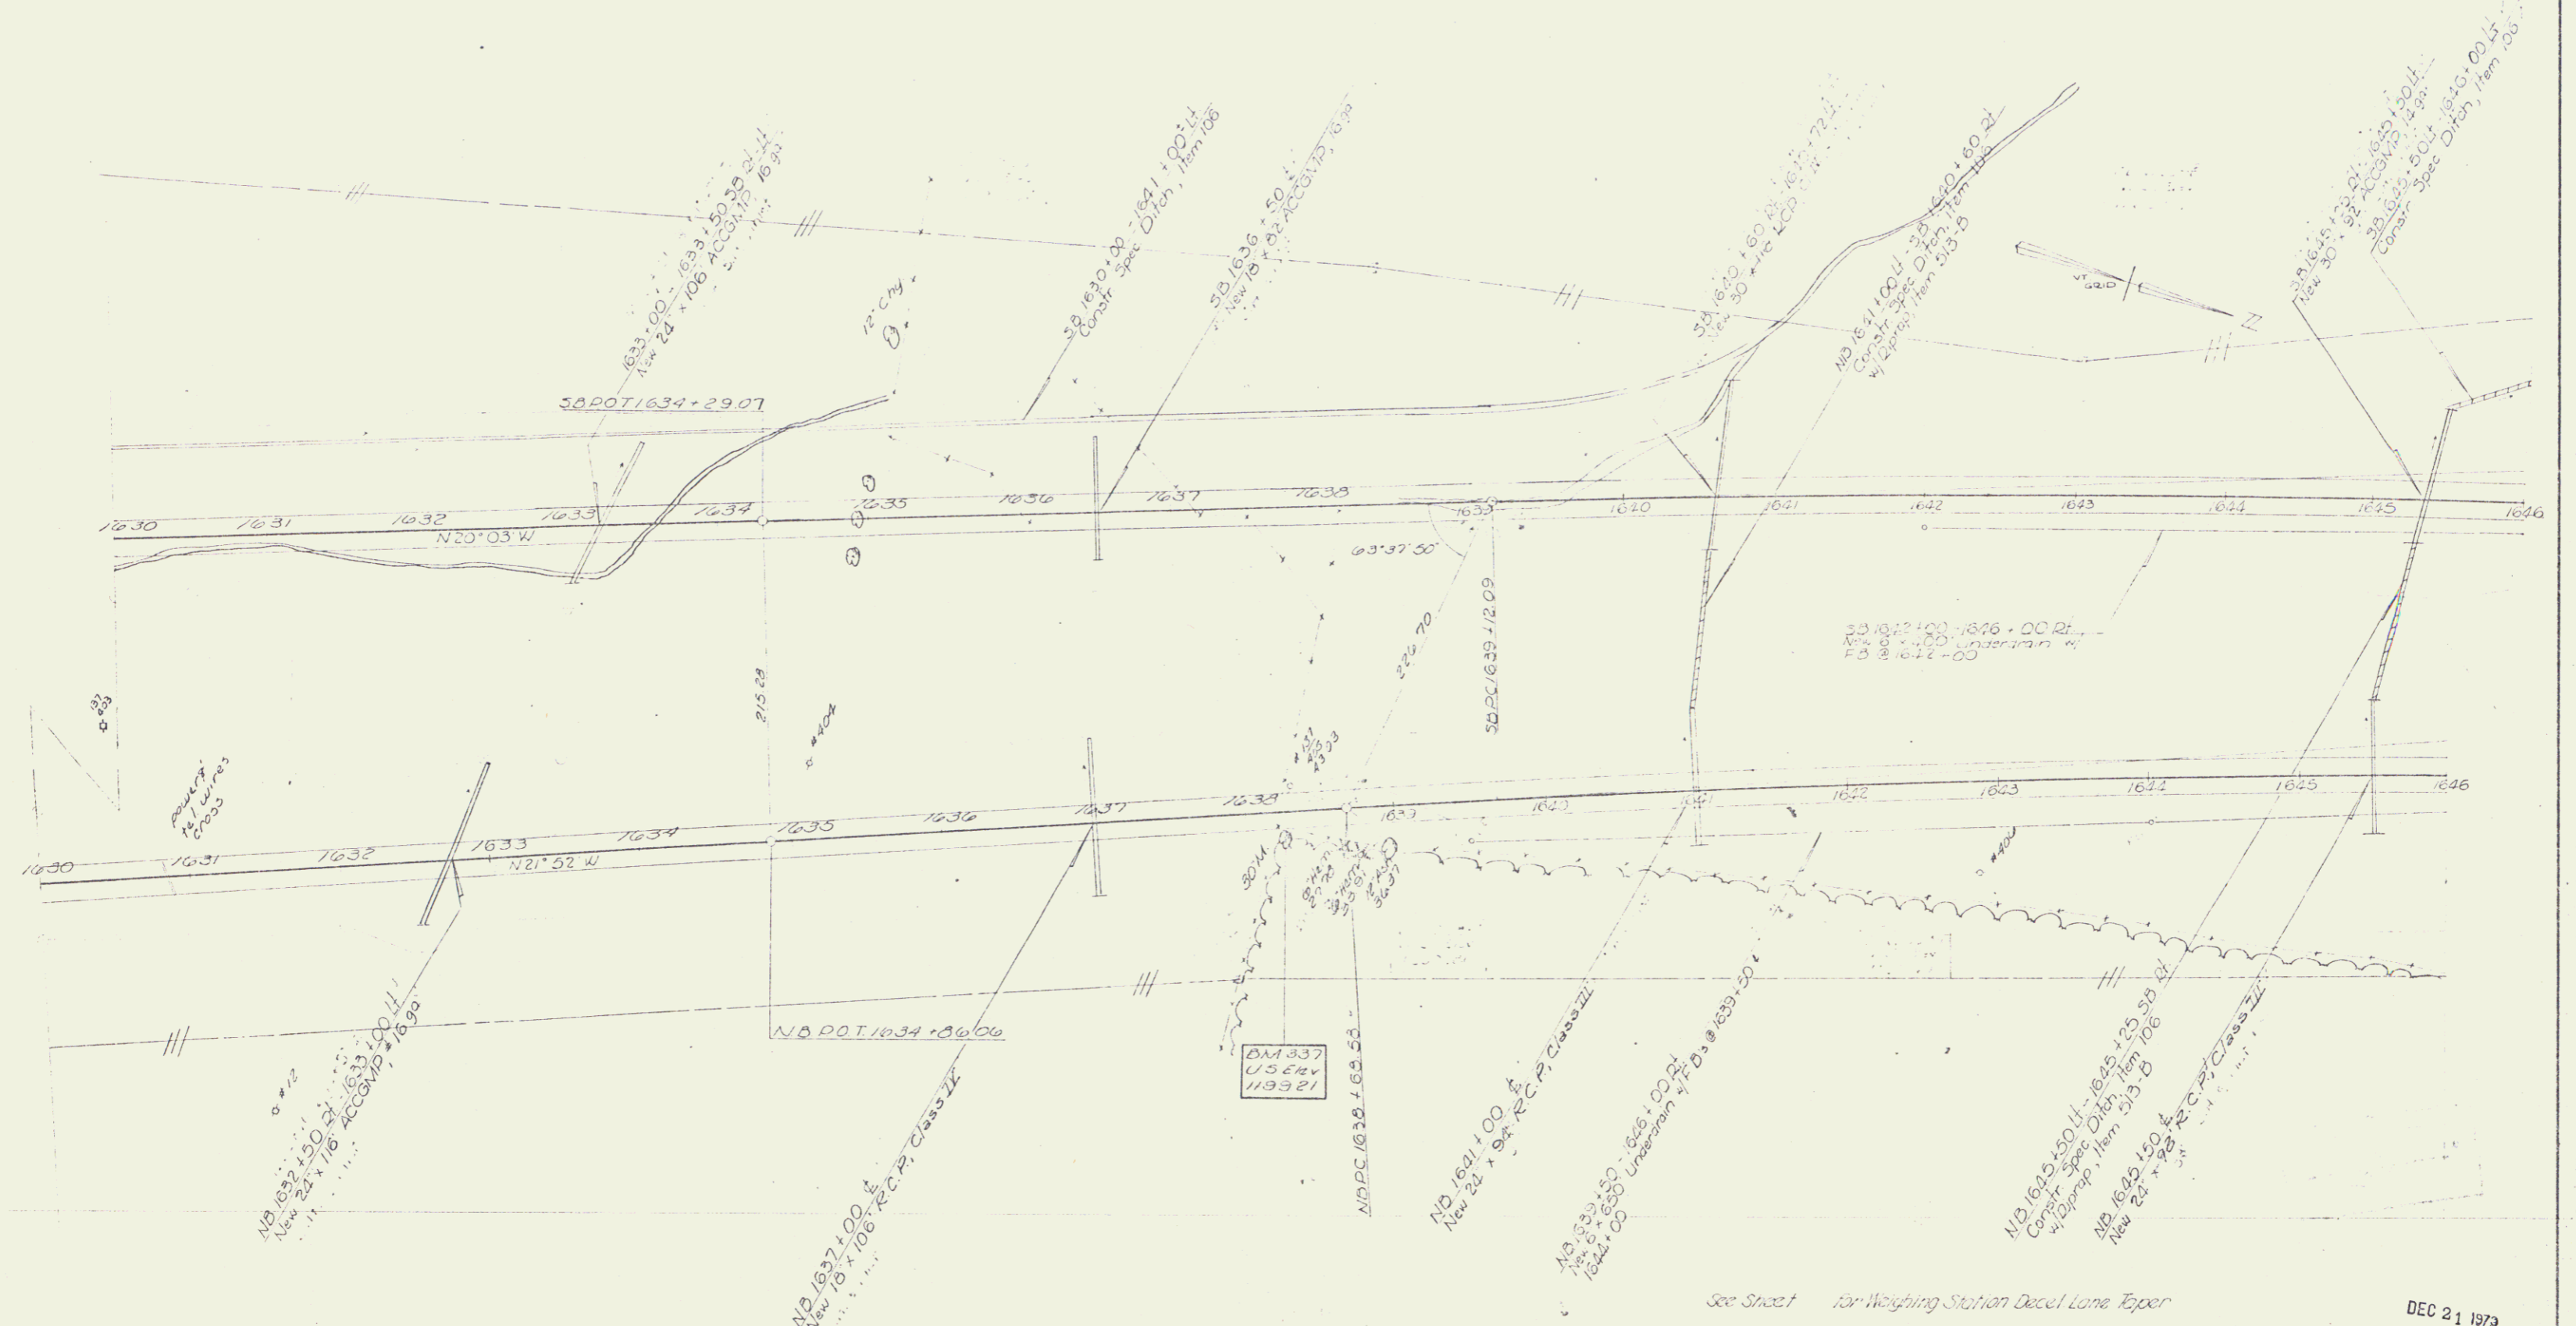

See Sheet 1 for Weighing Station Decel Lane Report

DEC 21 1973

SURVEYED BY *Jawst* DATE *5/6/73*
 DRAWN BY *L. Clark* DATE *5/6/73*
 TRACED BY *L. Clark* DATE *5/6/73*
 ROYALTON, DETHEL
 RANDOLPH
 PROJ. NO. 49-109(127)
 SHEET *97* OF *102*

CONTROL OF ACCESS COMPLETE ON THIS SHEET