


MUCK EXCAVATION, ITEM 117  
1793+50 - 1801+00 NB

SUBBASE OF SAND, ITEM 202  
SB 1802+00 - 1806+00

PROPERTY LINE FENCE, MOD  
ITEM 533-II  
NB 1790+00 - 1806+00  
SB 1790+00 - 1806+00

SB Curve Data  
 8°21'00" Lt  
 0°15'00" Rt  
 22018.32  
 620.26  
 1340.00  
 7.80  
 N. 1700  
 Do not bank

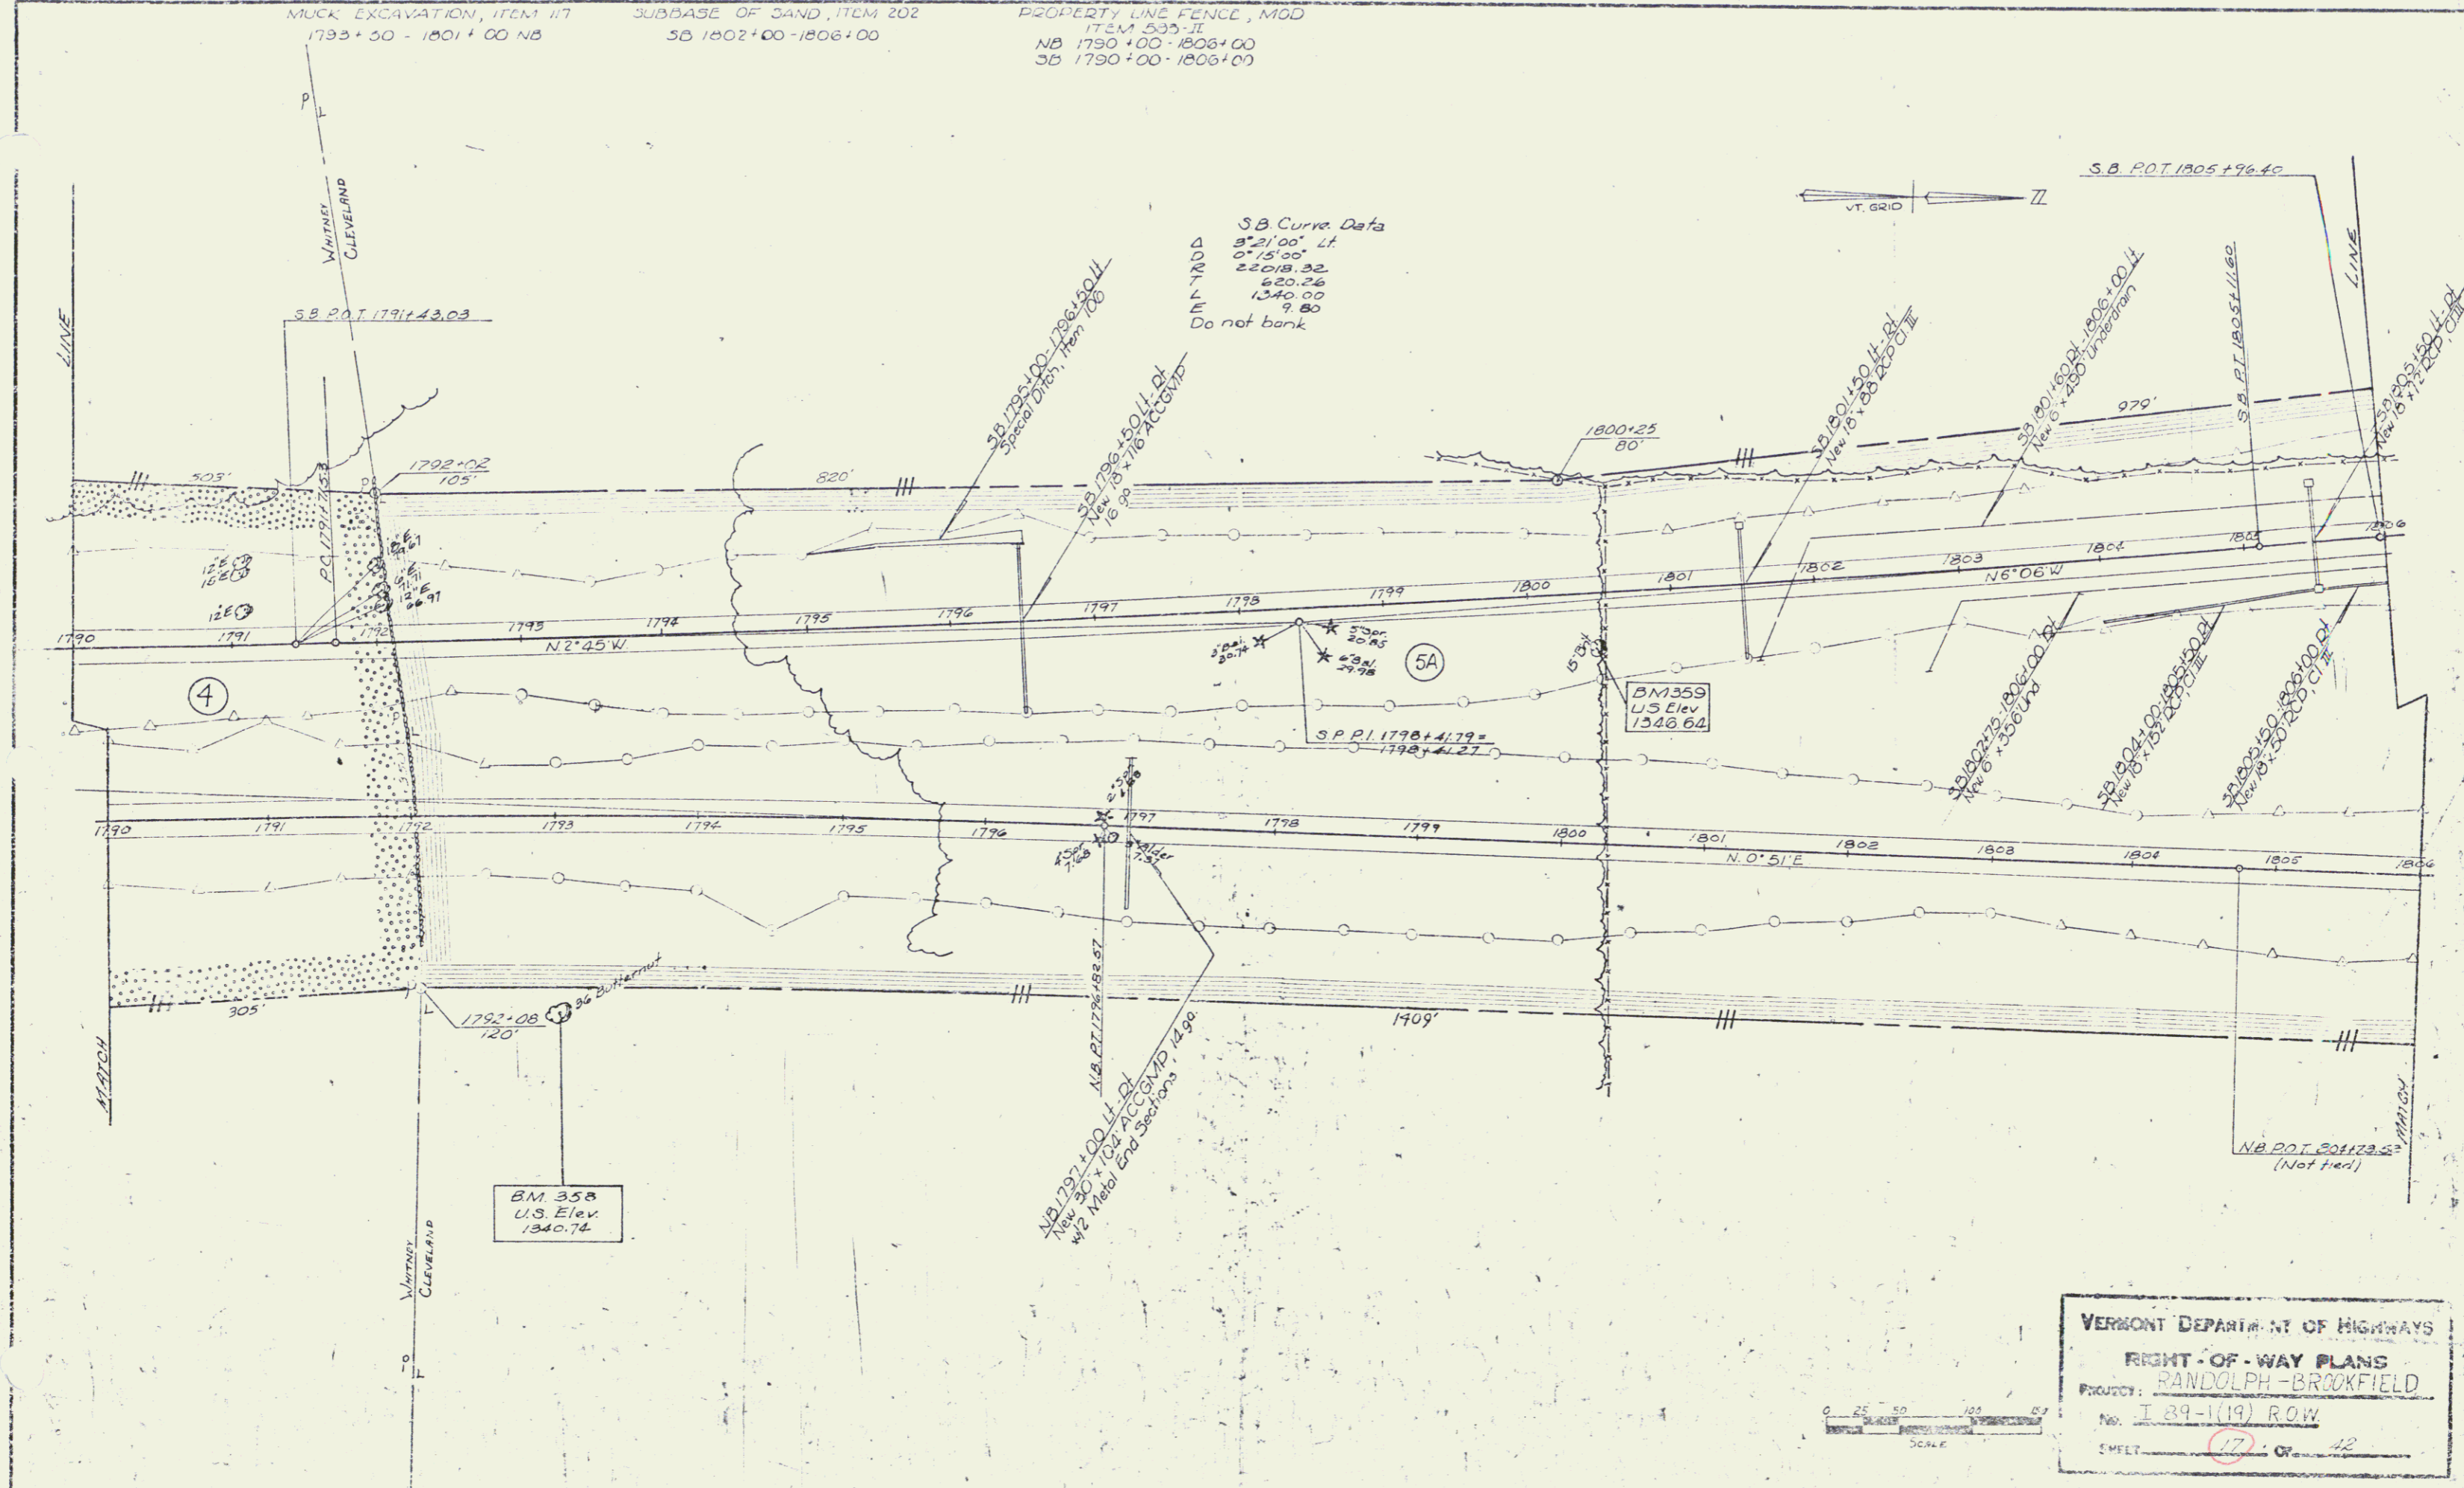

VERMONT DEPARTMENT OF HIGHWAYS  
 RIGHT-OF-WAY PLANS  
 PROJECT: RANDOLPH-BROOKFIELD  
 No. I 89-1(19) ROW  
 SHEET 17 OF 22