


THREE CABLE GUARD RAIL
ITEM 542
NB 1838+00 - 1838+52.21
NB 1838+00 - 1840+54.4

BIT CONC. CURB, ITEM 555 (TYPE I)
NB 1838+00 - NB 1840+00 Lf

DRILLING & BLASTING OF SOLID ROCK
SUBGRADE, ITEM 10
NB 1841+00 - 1854+00

MATCH LINE BETWEEN N.B. & S.B. LANES

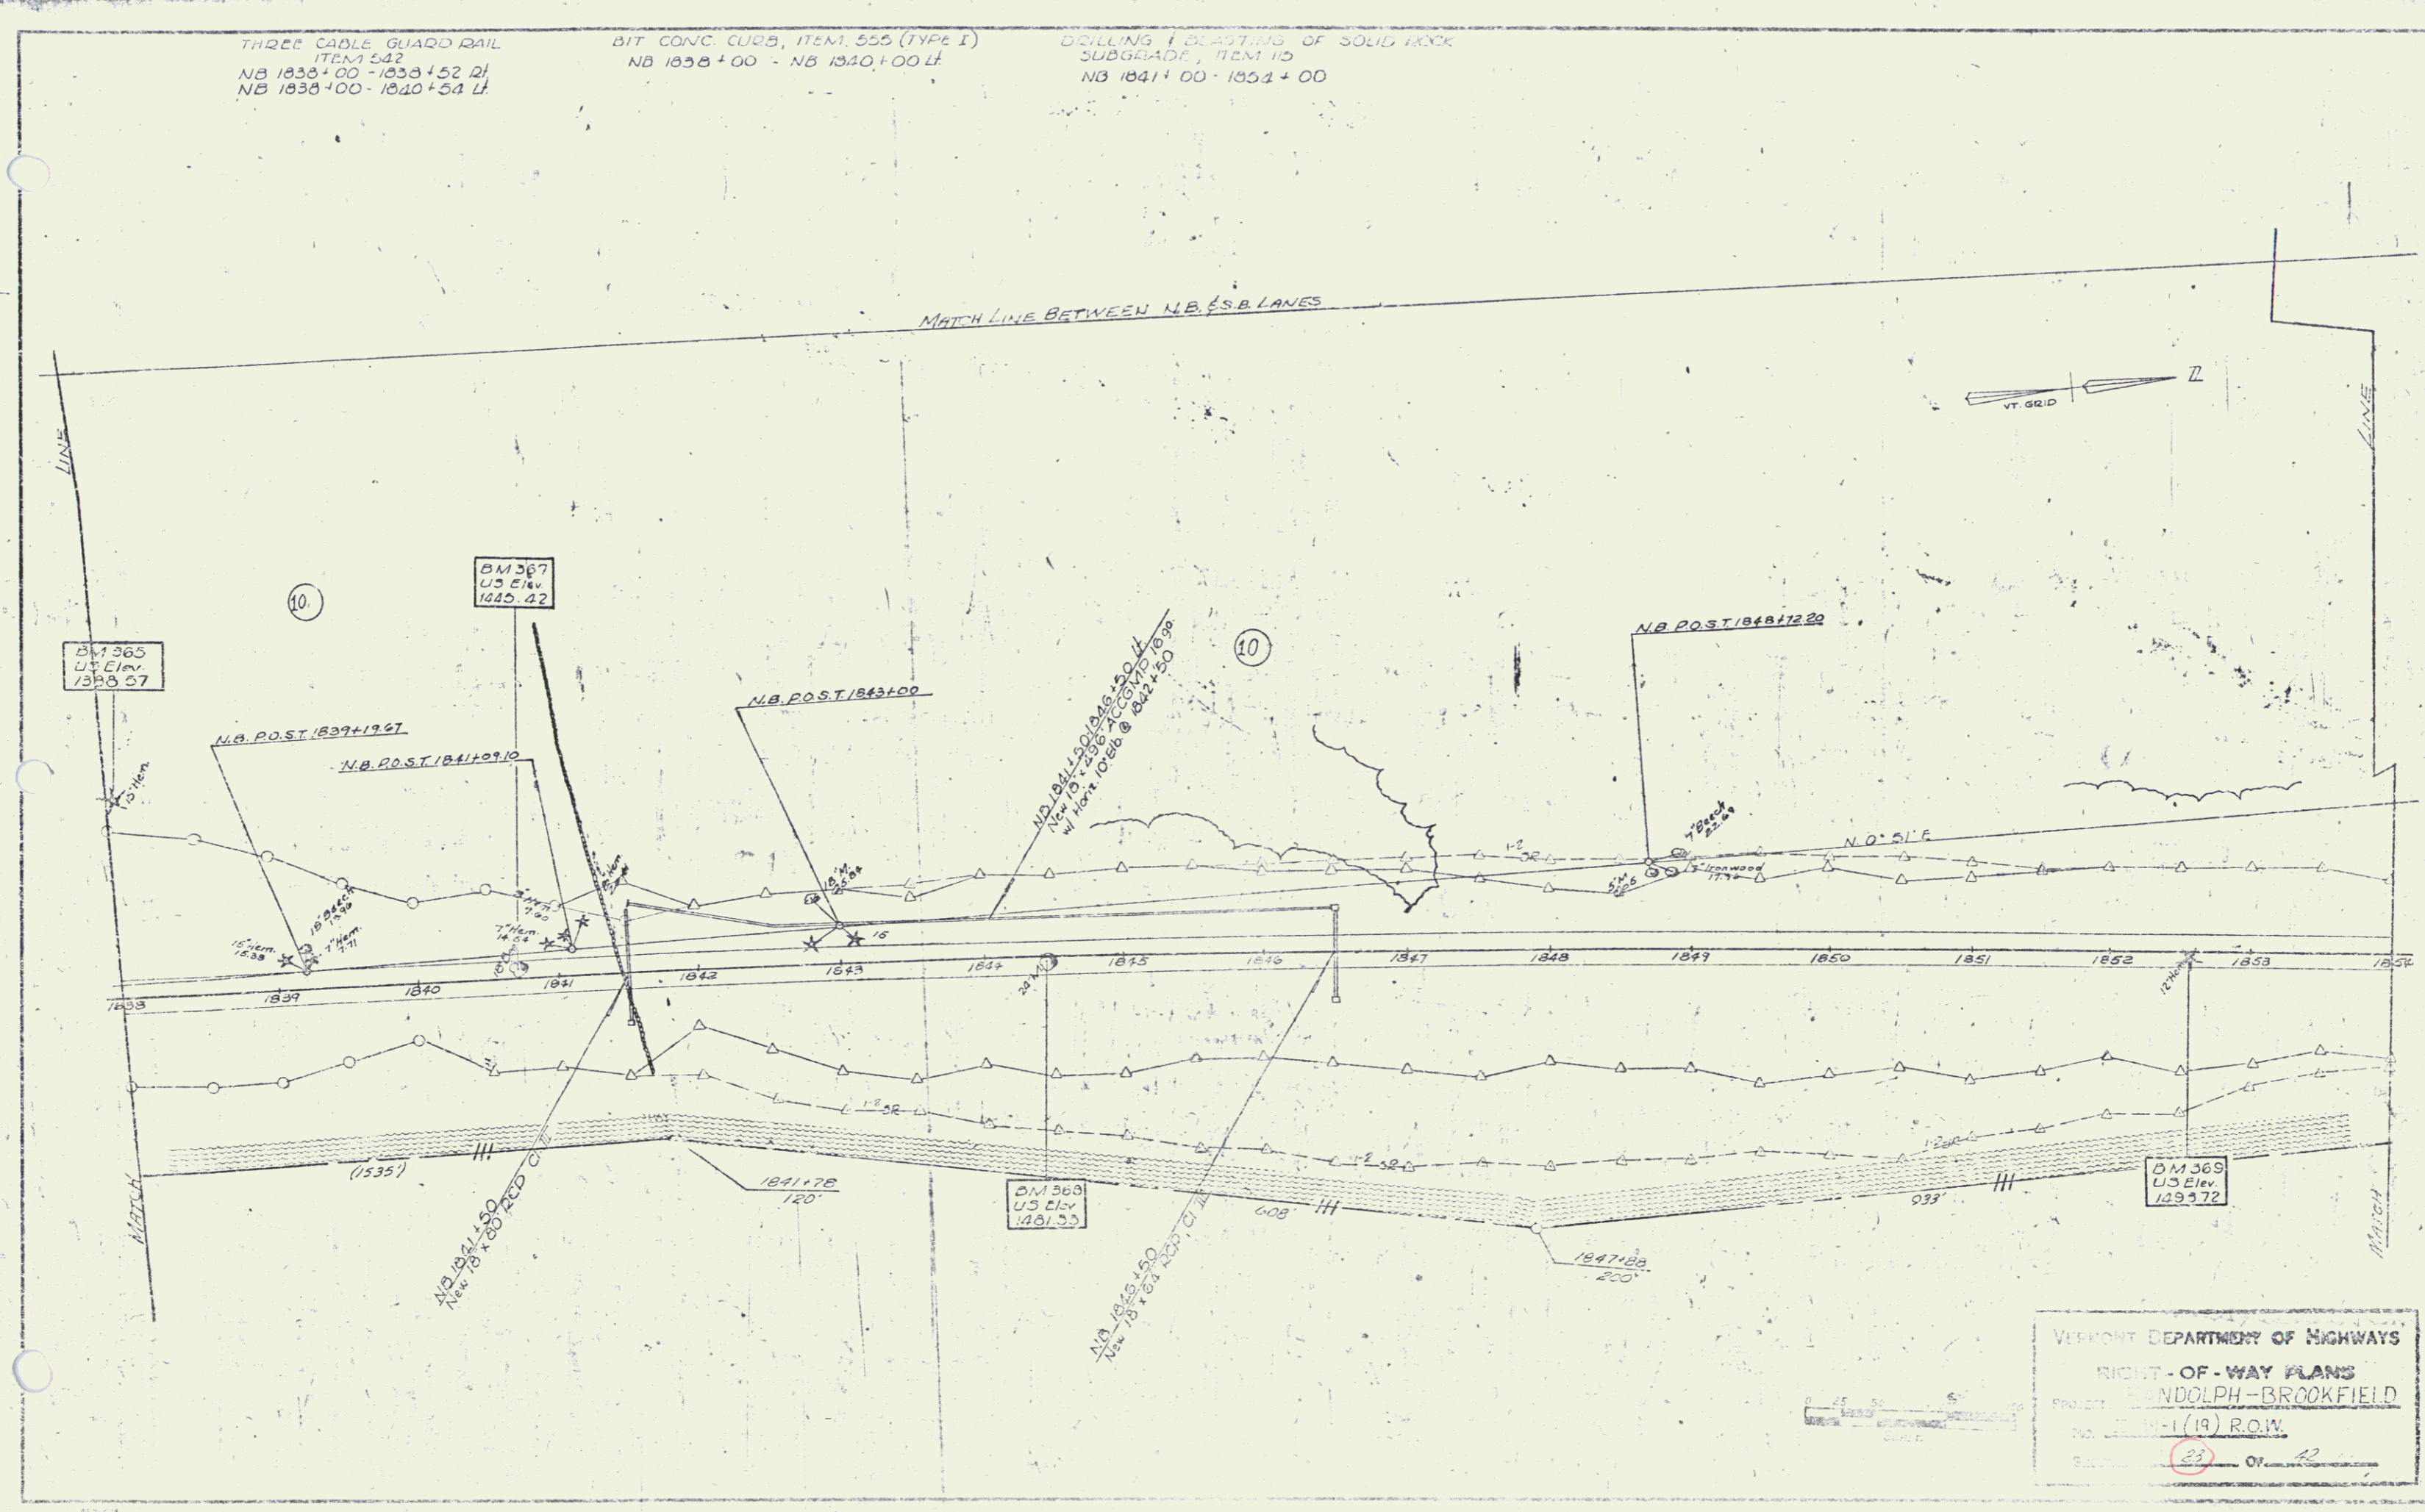

VERMONT DEPARTMENT OF HIGHWAYS
RIGHT-OF-WAY PLANS
PROJECT RANDOLPH-BROOKFIELD
NO. 1841-1 (19) R.O.W.
SHEET 22 OF 22