


INDEX OF SHEETS

| | | | |
|--------------|---|----------|---|
| SHEET NO. 1. | Title Sheet | 127-128. | SHEET #3144 Channel Sections |
| 2. | Alignment Sheet | 129. | 90'x205' COMPLP NB POT 2052+20 (Sunset Brook) |
| 3. | Typical Sections-Interstate | 130. | SHEET 1 Boring Logs |
| 4. | Quantity Sheets | 131-135. | SHEET 2 90'x205' COMPLP Details |
| 5. | Drainage and Items Sheets | 136. | SHEET 3-7 Channel Sections |
| 6. | Underdrains and Items Sheets | 137. | 4-51 Slope to Solid Rock Excavation-3/10/65 |
| 7-10. | Underdrains and Items Sheets | 138. | 8-1 Banking Details-3/10/65 |
| 11. | Underdrains and Items Sheets | 139. | 8-5 Typical Slope Grating-3/10/65 |
| 12-20. | Underdrains and Items Sheets | 140. | 8-6 Muck Excavation-3/10/65 |
| 21-33. | Right of Way Detail Sheets | 141. | 8-10 Embankment on a Slope-3/10/65 |
| 34-41. | Plan and Profile Sheets | 142. | 8-11 Use of Cadastre in Shattered Rock Subgrade-3/10/65 |
| 42-45. | Relocation of Existing Water Supply Main | 143. | 8-12 Side Road Intersection-3/10/65 |
| 46-49. | BRIDGE SERIES SK-100 TR 24 & 26 OVER I 89 NB 1809+00 | 144. | D-6 70' W/Grate for Ho in Ditches-12/15/65 |
| 50-53. | BR-100 Plan & Elevation NB Lane 1509+30 | 145. | D-2 65M Precast Walls-Underdrains-3/25/67 |
| 54-57. | BR-101 Quantity Sheet | 146. | D-3 Jute Mattings-5/12/67 |
| 58-61. | BR-102 Preliminary Sheet | 147. | D-4 Pipe Slopes, Metal End Sections, etc.-8/1/68 |
| 62-65. | BR-103 Boring Logs | 148. | D-5 10' Top for Iron Inlets-3/10/65 |
| 66-69. | BR-104 Superstructure Details | 149. | D-11 Details of Grates & Co. (5/10/65) |
| 70-73. | BR-105 Abutment No. 1 over NB | 150. | D-16 3' Top Inlet Trunk II |
| 74-77. | BR-106 Abutment No. 2 over NB | 151. | D-17 Asph. Ctd. Corr. Galv. Rod. Pipe Vertical River-1/7/68 |
| 78-81. | BR-107 Reinforcing Schedule | 152. | E-31 Fed. and Const. Sign-4/21/67 |
| 82-85. | BR-108 Plan & Elevation SB Lane 1510+30 | 153. | E-32 Road Const. Approach Sign-11/1/67 |
| 86-89. | BR-109 Preliminary Information | 154. | E-34 Bridge Const. Approach Sign-3/3/67 |
| 90-93. | BR-110 Superstructure Details over SB | 155. | F-1 Property Line fence-3/22/69 |
| 94-97. | BR-111 Abutment No. 1 over SB | 156-157. | G-2a to G-2c Two Cable Guard Rails-3/10/65 |
| 98-101. | BR-112 Abutment No. 2 over SB | 158. | G-4 Wood Marker Posts, Plank Cords Rail-6/30/65 |
| 102-105. | BR-113 Preliminary Information | 159. | J-1 Erection of Project Markers-3/10/65 |
| 106-109. | BRIDGE SERIES 200 SA 46 OVER I 89 SB 1907+25 NB 1900+00 | 160. | K-1 102'x210' COMPLP NB POT 1723+60 |
| 110. | BR-200 Plan & Elevation SA 46 OVER SB | 161. | SCB-01-05 - 2/18/65 |
| 111. | BR-201 Quantity Sheet NB & SB | 162. | SCB-02-05 - 2/18/65 |
| 112. | BR-202 Preliminary Information | 163. | SCB-03-05 - 2/18/65 |
| 113. | BR-203 Boring Logs NB & SB | 164. | SCB-04-05 - 2/18/65 |
| 114. | BR-204 Superstructure Details SA 6 OVER SB | 165. | SCB-05-05 - 2/18/65 |
| 115. | BR-205 Abutment No. 1 over SB | 166. | SCB-06-05 - 2/18/65 |
| 116. | BR-206 Abutment No. 2 over SB | 167. | SCB-07-05 - 2/18/65 |
| 117. | BR-207 Reinforcing Schedule | 168. | SCB-08-05 - 2/18/65 |
| 118. | BR-208 Plan & Elevation I 89 NB over SA 46 | 169. | SCB-09-05 - 2/18/65 |
| 119. | BR-209 Preliminary Information SB over SA 46 | 170. | SCB-10-05 - 2/18/65 |
| 120. | BR-210 Superstructure Details-NB | 171. | SCB-11-05 - 2/18/65 |
| 121. | BR-211 Abutment #1 NB | 172. | SCB-12-05 - 2/18/65 |
| 122. | BR-212 Abutment #2 NB | 173-174. | SB 188-189 |
| 123. | BR-213 Approach Slabs #1&2 NB | 175-176. | SB 190-191 |
| 124. | BR-214 Reinforcing Schedule | 177-178. | SB 192-193 |
| 125. | 102'x210' COMPLP NB POT 1723+60 | 179-180. | SB 194-195 |
| 126. | SHEET 1 Boring Logs | 181-182. | SB 196-197 |
| 127. | SHEET 2 102' COMPLP Details | 183-184. | SB 198-199 |


STATE OF VERMONT
DEPARTMENT OF HIGHWAYS
PROPOSED IMPROVEMENT
INTERSTATE PROJECT

TOWNS OF RANDOLPH-BROOKFIELD
COUNTY OF ORANGE
INTERSTATE ROUTE 89
WHITE RIVER JCT.-MONTPELIER ROAD

BEGINNING AT A POINT 3.360 MILES SOUTHERLY FROM THE RANDOLPH-BROOKFIELD TOWN LINE AND EXTENDING NORTHERLY 6.650 MILES.
LENGTH OF ROADWAY 35,075.32 FEET 6.643 MILES
LENGTH OF BRIDGES 34.50 FEET 0.007 MILES
LENGTH OF PROJECT 35,109.82 FEET 6.650 MILES

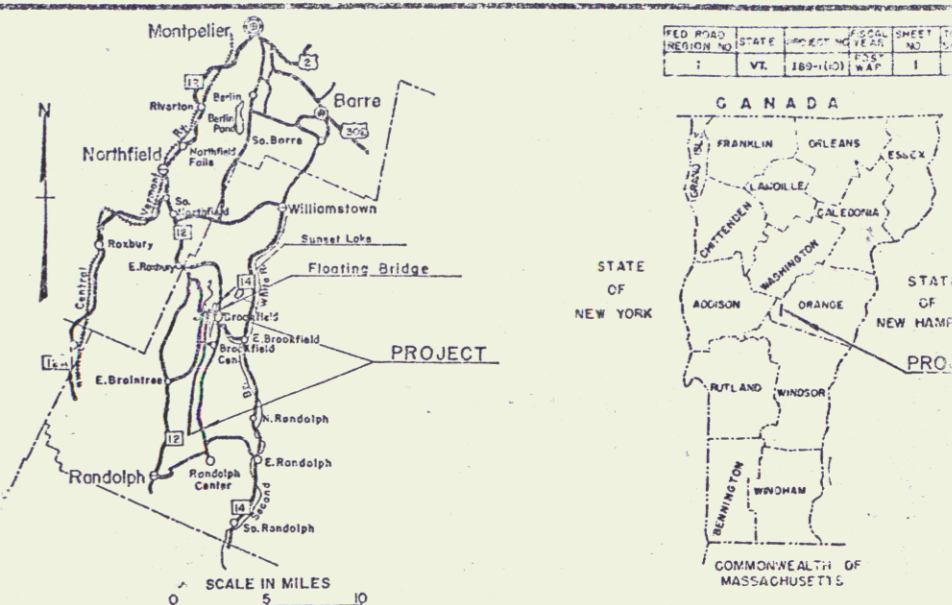

STATION 1900-2055

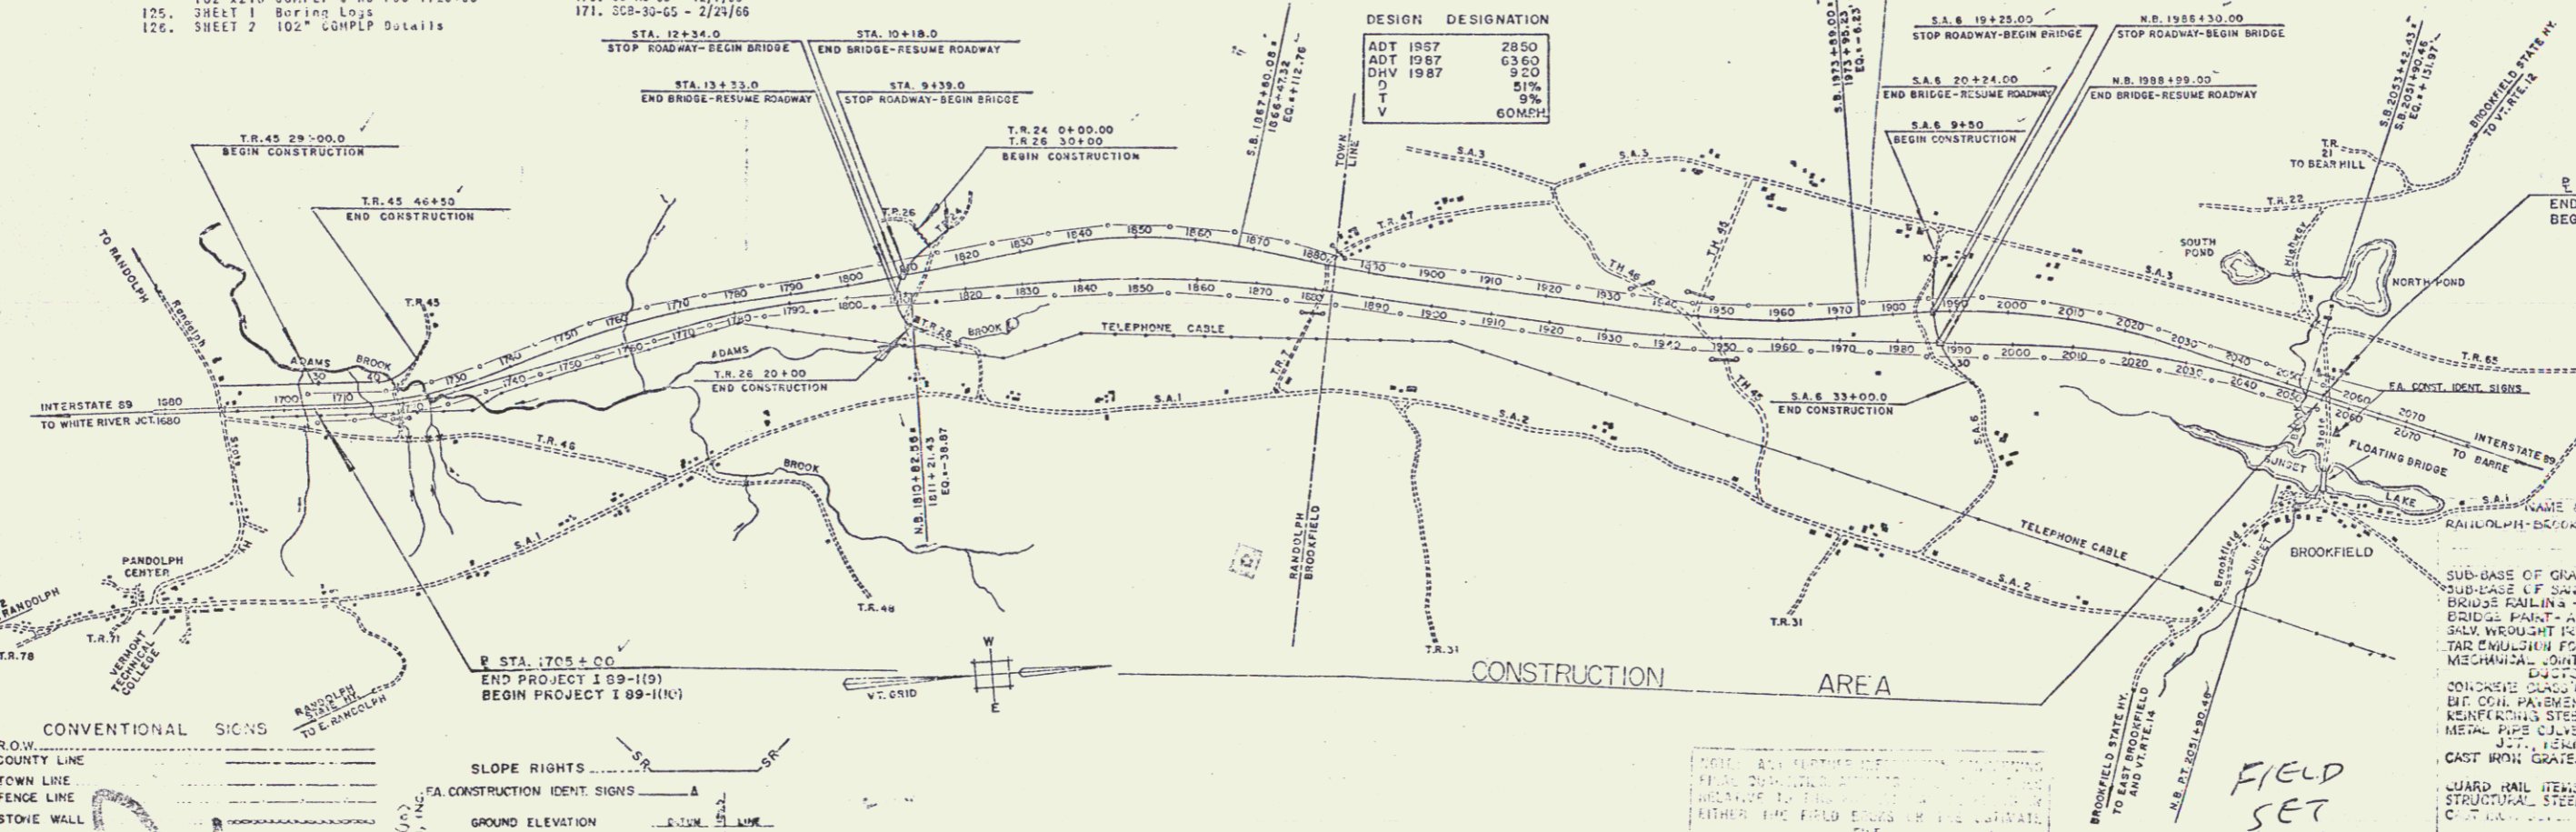

CONVENTIONAL SIGNS

SLOPE RIGHTS

FA CONSTRUCTION IDENT. SIGNS

CURVE DATA

SCALE IN FEET
0 500 1000 2000 3000

STATE HIGHWAYS, STATE AID ROADS AND TOWN ROADS ARE NOT IN THE CONSTRUCTION AREA, EXCEPT AS NOTED ABOVE.
FOR RIGHT-OF-WAY DETAILS, SEE RIGHT-OF-WAY PLANS FOR THIS PROJECT.

MAR 18 1974

| | | | | |
|---|--|--|--|--|
| APPROVED <i>[Signature]</i> DISTRICT ENGINEER DATE 4/8/65 | APPROVED <i>[Signature]</i> DISTRICT ENGINEER DATE 4/19/65 | APPROVED <i>[Signature]</i> DISTRICT ENGINEER DATE 4/15/65 | APPROVED <i>[Signature]</i> DISTRICT ENGINEER DATE 4/15/65 | APPROVED <i>[Signature]</i> DISTRICT ENGINEER DATE 4/15/65 |
|---|--|--|--|--|

THESE PLANS ARE SUBJECT TO SUCH REVISIONS AS MAY BE REQUIRED BY THE BUREAU OF PUBLIC ROADS OR THE COMMISSIONER OF HIGHWAYS.
CONSTRUCTION IS TO BE CARRIED ON IN ACCORDANCE WITH THESE PLANS AND THE STANDARD SPECIFICATIONS FOR HIGHWAY AND BRIDGE CONSTRUCTION DATED APRIL 1954 AS APPROVED BY THE BUREAU OF PUBLIC ROADS ON OCTOBER 10, 1954, INCLUDING ALL SUBSEQUENT APPROVED REVISIONS AND SUCH REVISED SPECIFICATIONS AND SPECIAL PROVISIONS AS ARE INCORPORATED IN THESE PLANS.

DEPARTMENT OF TRANSPORTATION
BUREAU OF PUBLIC ROADS

PROJECT I NO. 89-1101
STAGE I CONSTRUCTION
SHEET 1 163 SHEETS

CONTRACTOR - L. B. DEFELICE & SONS, INC. CONTRACT DATE - JUNE 29, 1964
NORTH HAMPSHIRE, CONN. - JULY 24, 1964
PRACTICE NAME - DEFELICE & SONS, INC. - DEC. 10, 1964
RECORD PLANS - 163 SHEETS
RECORD DATE - DEC. 2, 1964

CONSTRUCTION AREA
FIELD SET