
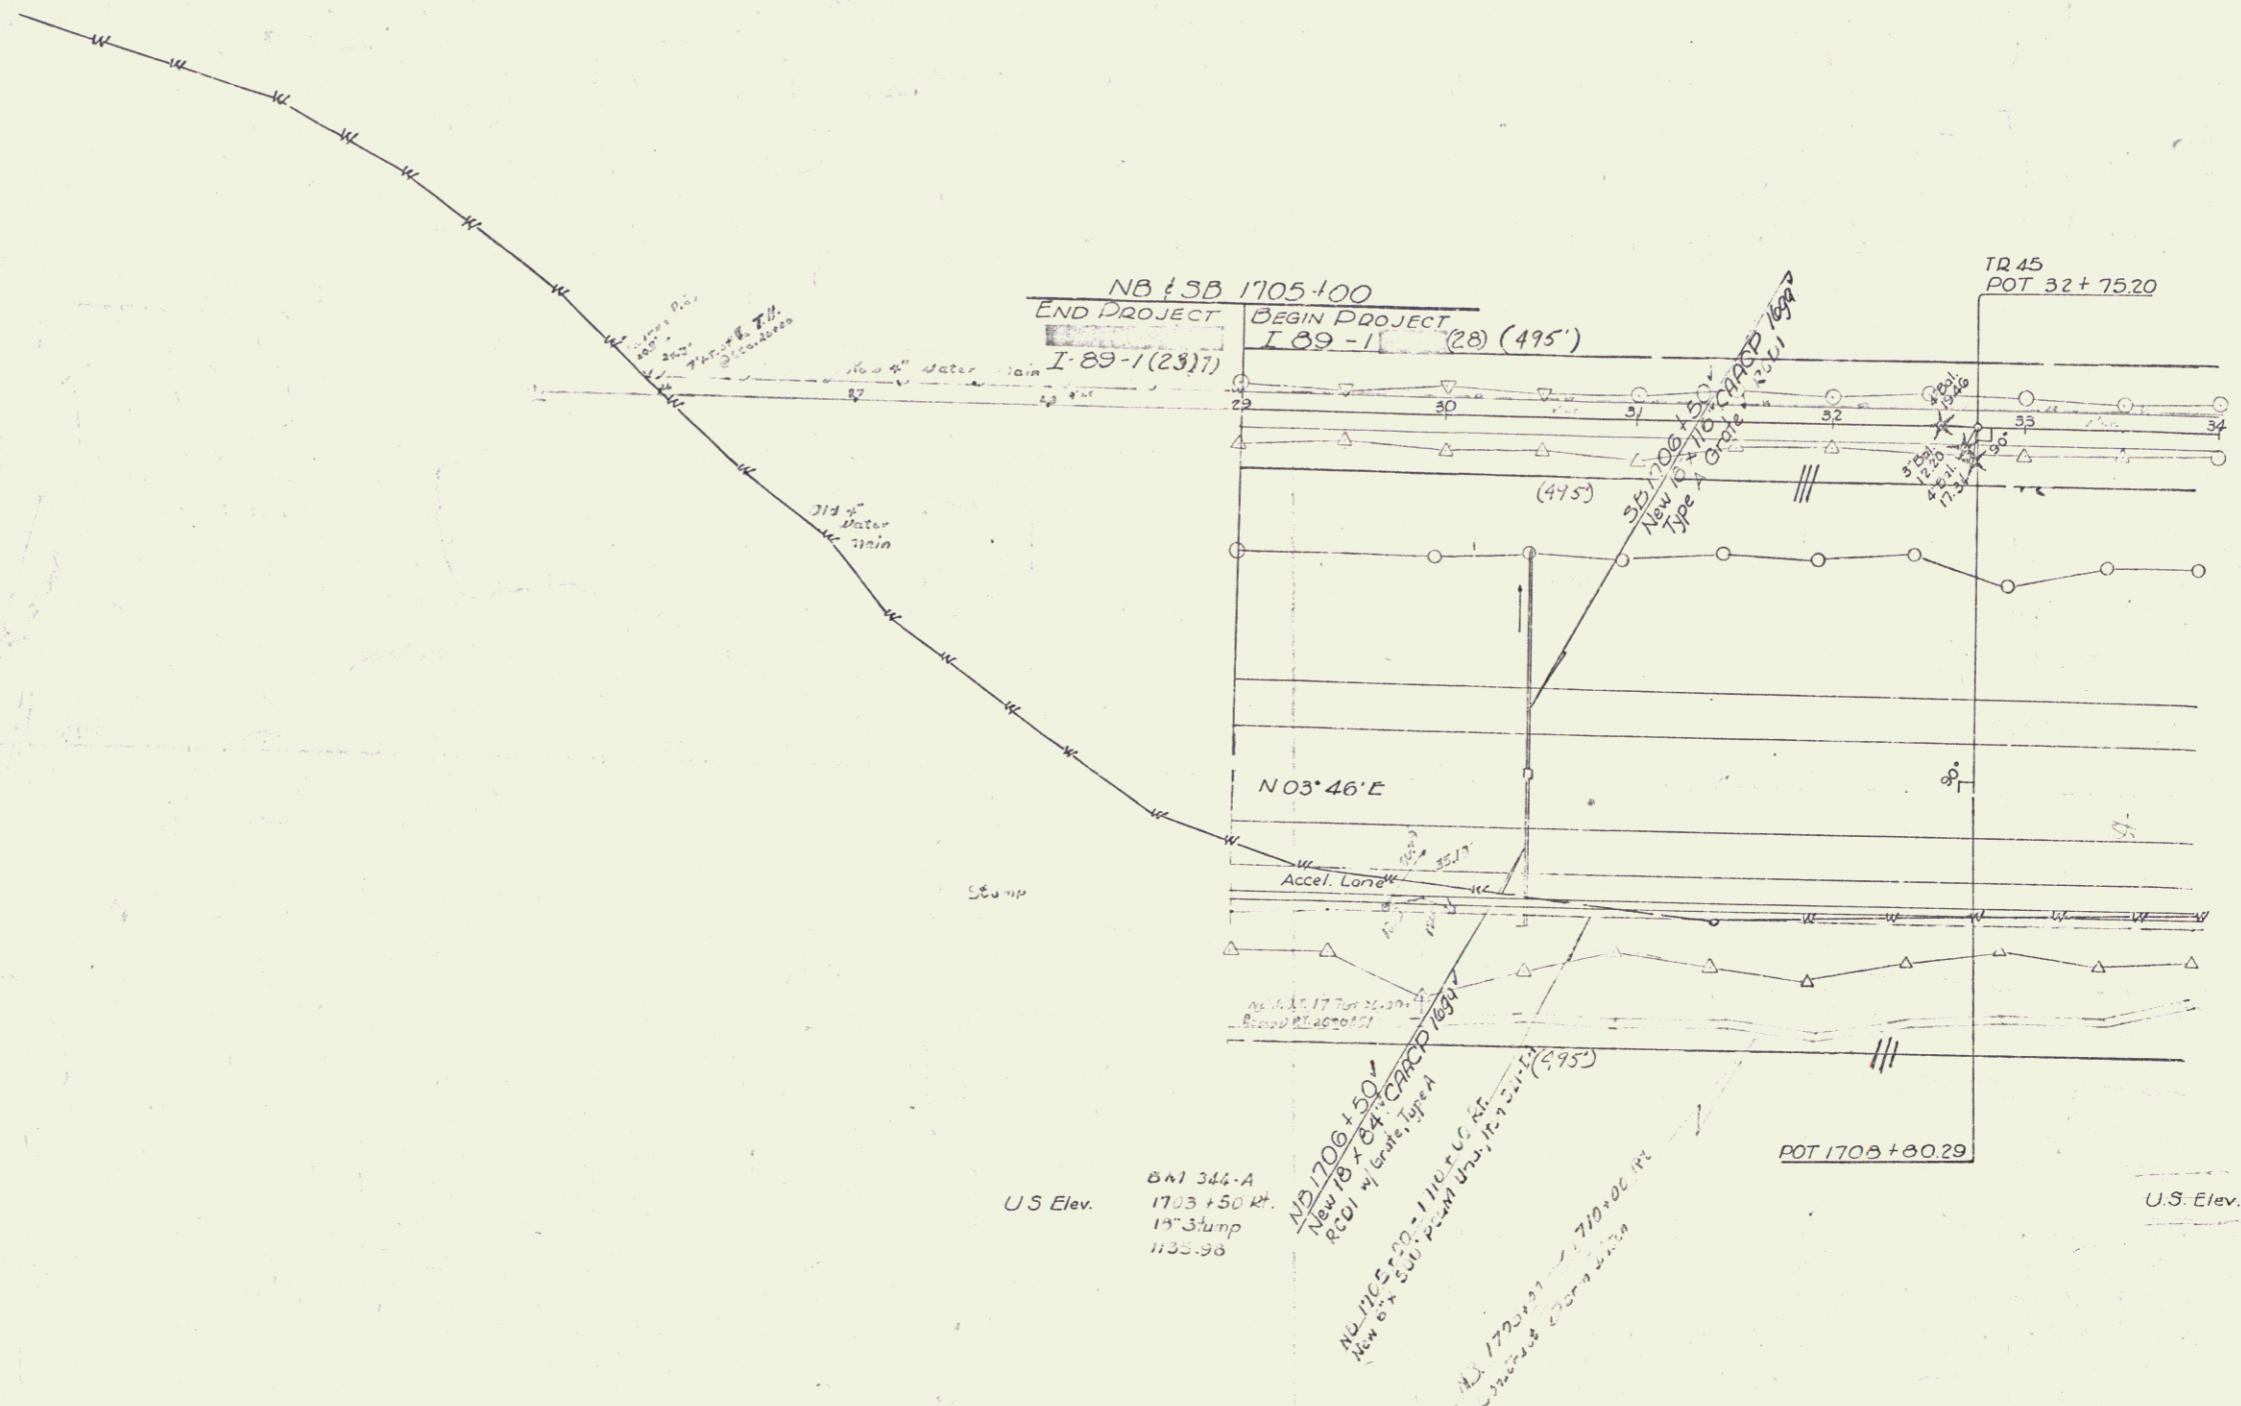


Randolph Brookfield I 89
Sta 1705 - 2055

PROPERTY LINE FENCE, MOD
ITEM 563-II
NB 1705+00 - 1710+00 RT
SB 1705+00 - 1710+00 LT

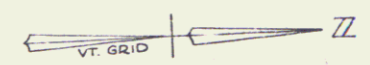


U.S. Elev. 6A1 344-A
1705+50 RT
15' stump
1133.30

U.S. Elev.

FIELD SET

Stage 2 Construction
RANDOLPH-BROOKFIELD

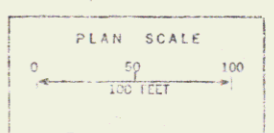

Control of Access is complete on this Sheet

Sheet 26 of 155 Sheets