


DRILLING AND BLASTING OF  
SOLID ROCK SUBGRADE  
ITEM 115  
S.B. 1742+00: 17513+500

PROPERTY LINE FENCE  
MOD. ITEM 583-II  
N.B. 1742+00: 1750+00  
S.B. 1742+00: 1758+00

P/L FENCE TO BE ERECTED PRIOR  
TO CONSTRUCTION  
SB+NB 1742+00 - 1746+74 R.F. 1:16

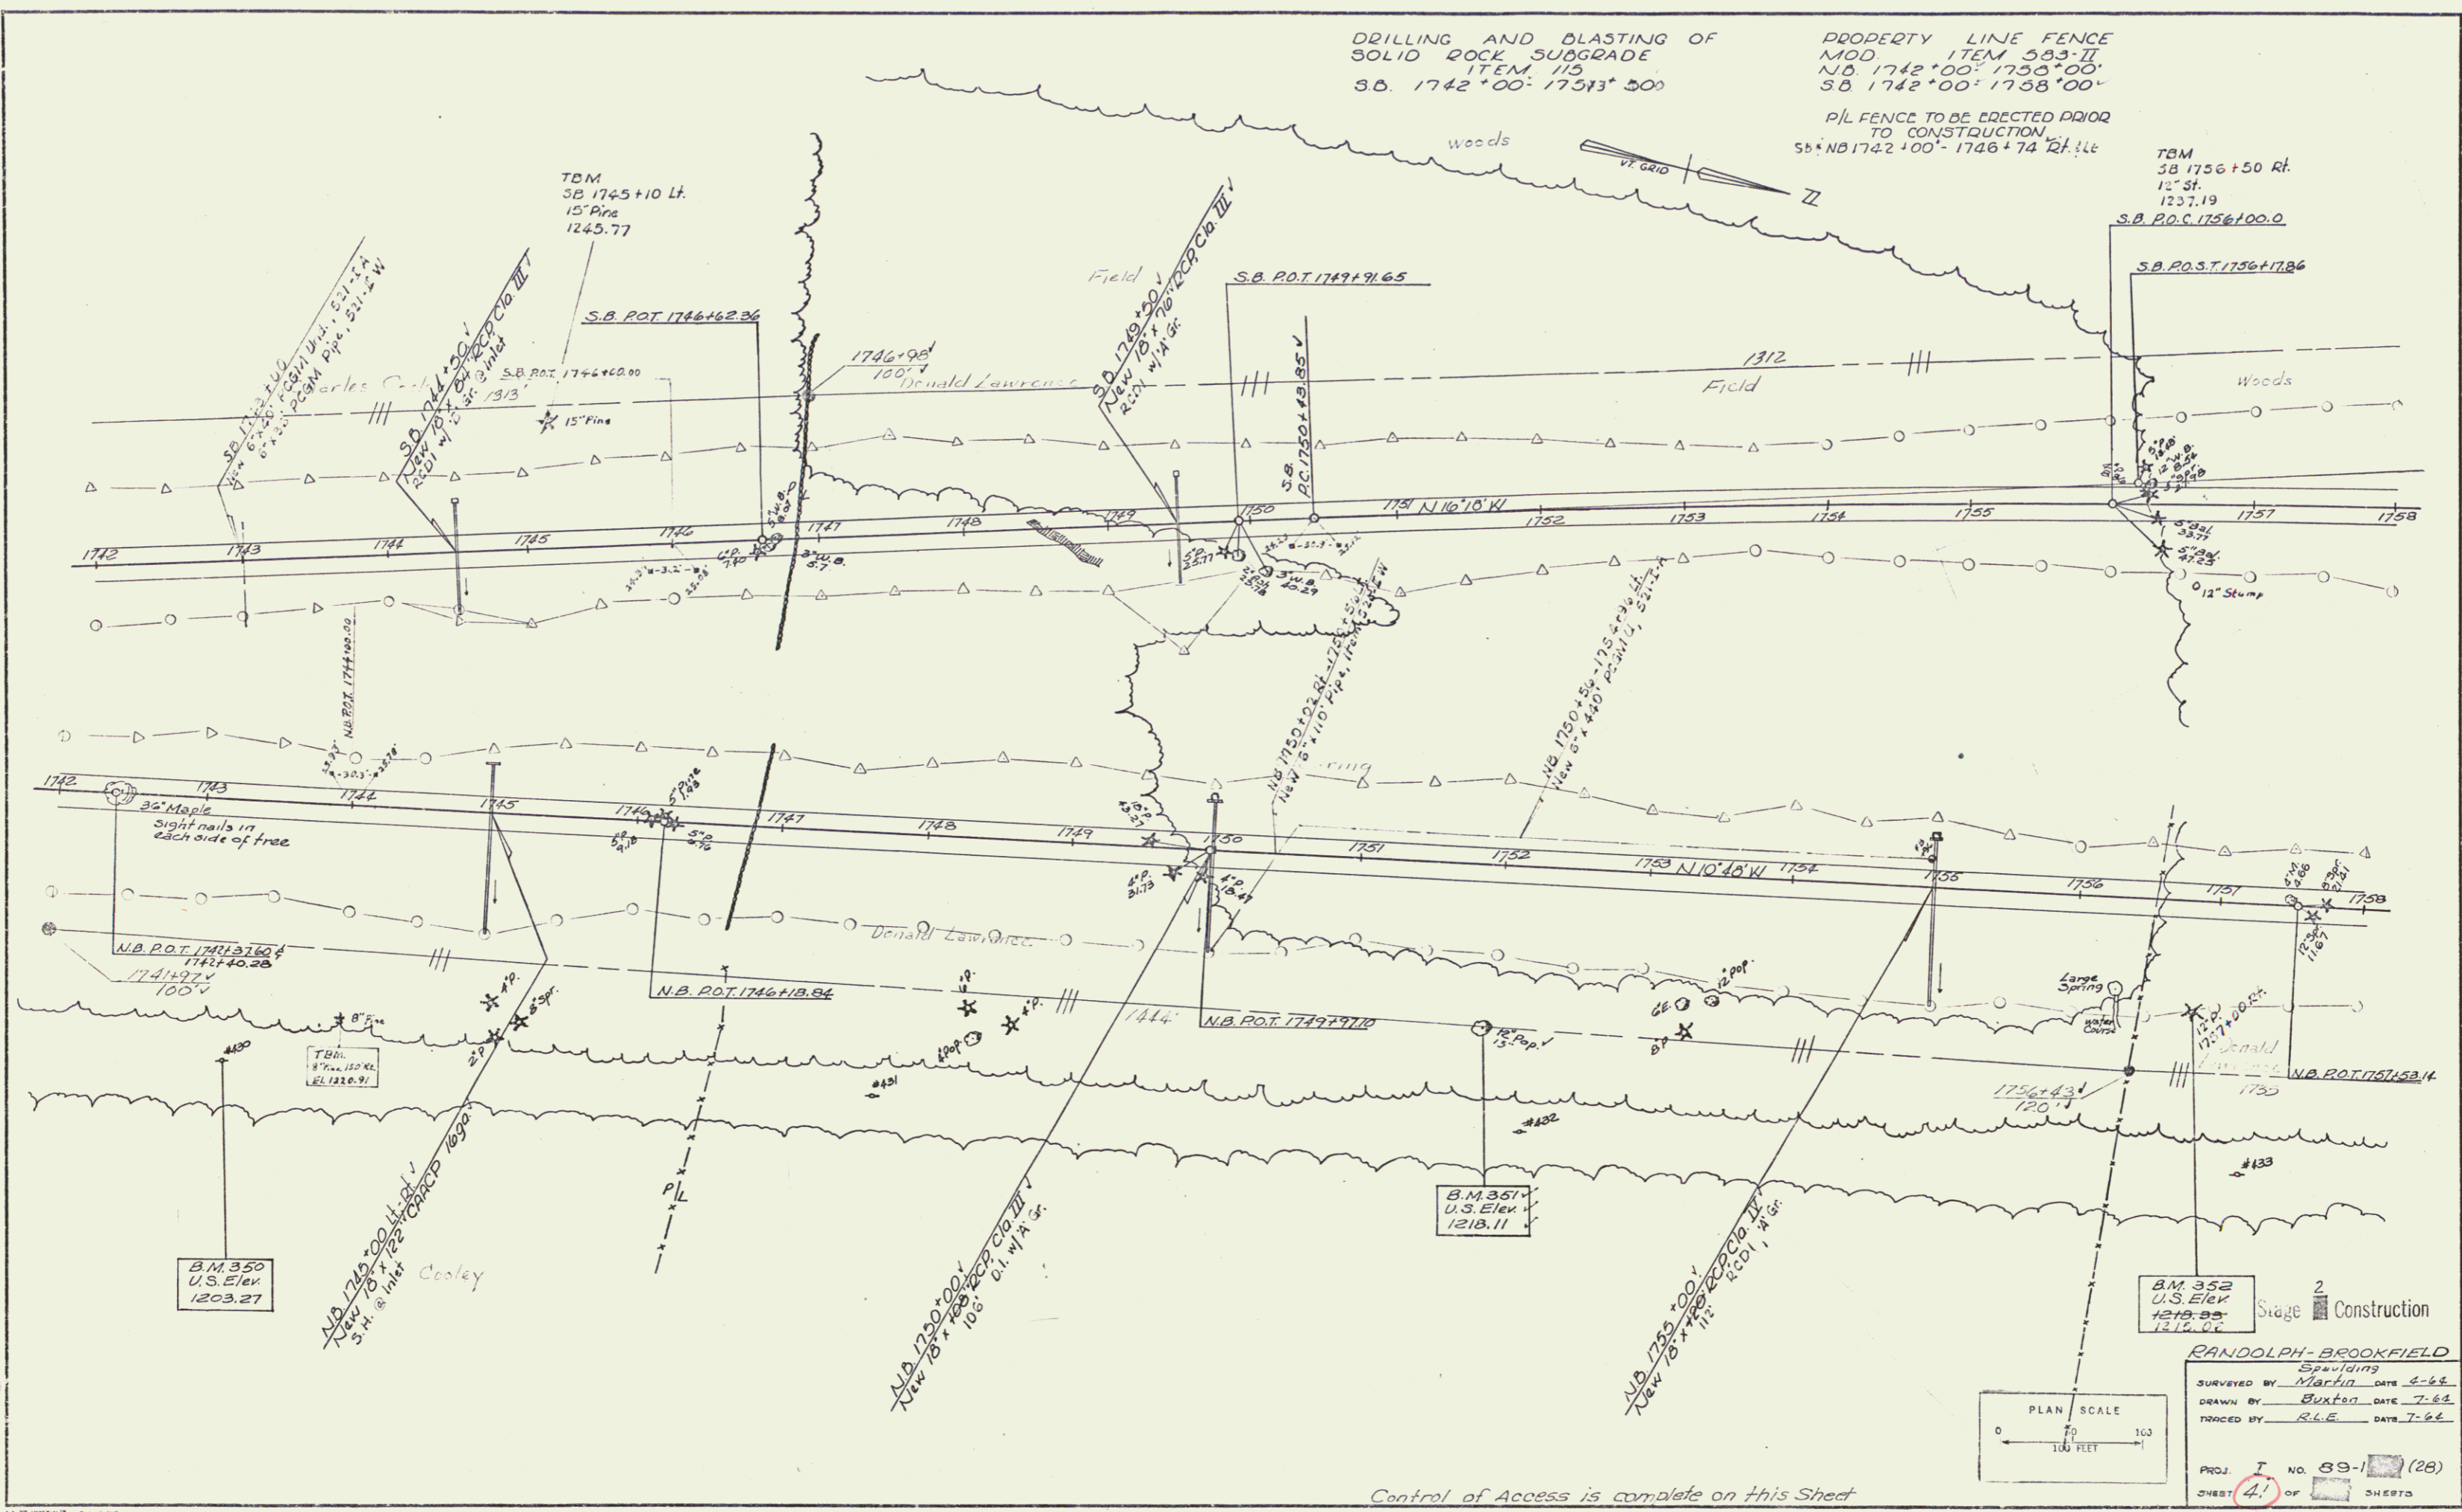

TBM  
SB 1756+50 Rt.  
12' 3"  
1237.19

S.B. P.O.C. 1756+100.0


S.B. P.O.S. 1756+1786

B.M. 350  
U.S. Elev.  
1203.27

B.M. 351  
U.S. Elev.  
1218.11

B.M. 352  
U.S. Elev.  
1218.85  
1218.62

Stage 2 Construction

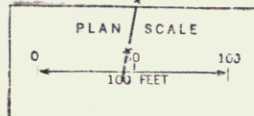

RANDOLPH-BROOKFIELD  
Sponsored by  
SURVEYED BY W. J. Buxton DATE 4-66  
DRAWN BY R.L.E. DATE 7-66  
TRACED BY R.L.E. DATE 7-66

PROJ. I NO. 89-1 (28)  
SHEET 41 OF SHEETS

Control of Access is complete on this Sheet

Sheet 41 of 155 Sheets

46