
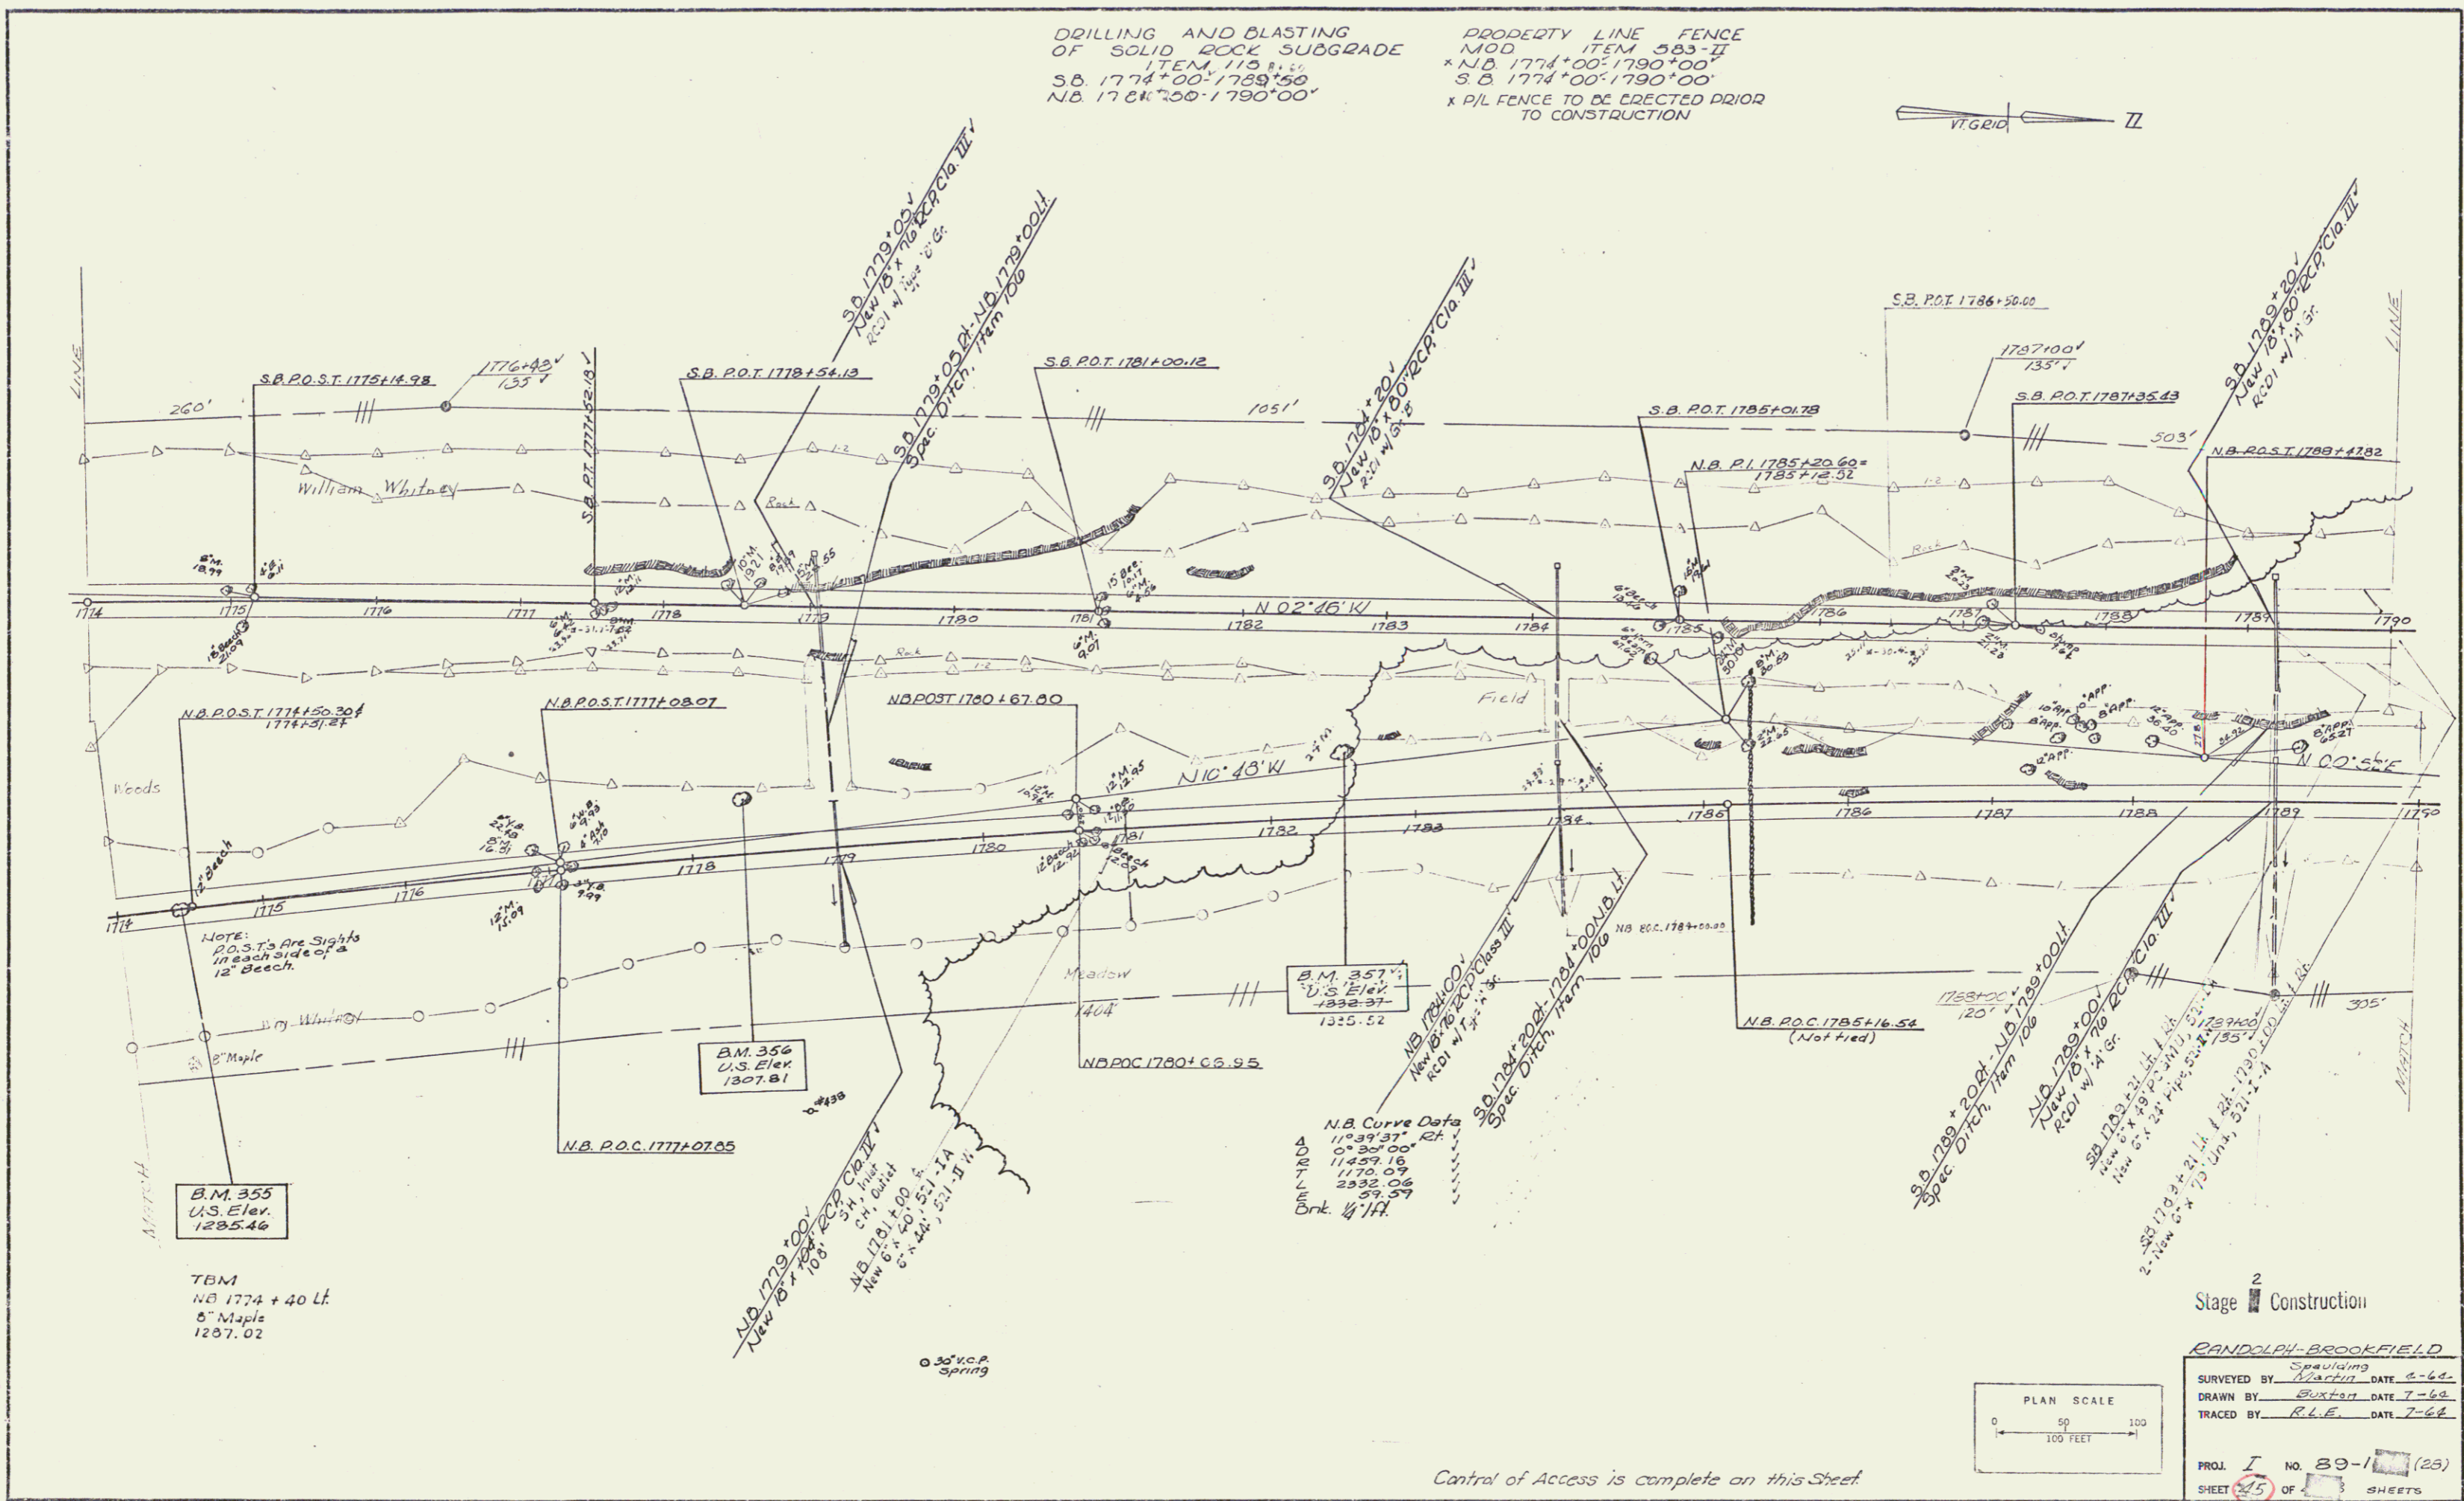


DRILLING AND BLASTING
OF SOLID ROCK SUBGRADE
ITEM 113 B.1.1
S.B. 1774+00-1789+50
N.B. 1780+00-1790+00

PROPERTY LINE FENCE
MOD. ITEM 583-II
* N.B. 1774+00-1790+00
S.B. 1774+00-1790+00
* P.I.L. FENCE TO BE ERECTED PRIOR
TO CONSTRUCTION

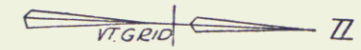

B.M. 355
U.S. Elev.
1285.46

TBM
NB 1774 + 40 Lf.
8" Maple
1287.02


B.M. 356
U.S. Elev.
1307.81

B.M. 357
U.S. Elev.
1332.37
1325.52

N.B. Curve Data
110°39'31" R.H.
0°30'00"
11457.16
1170.09
2332.06
57.57
Dnt. 1/11.

Stage 2 Construction

RANDOLPH-BROOKFIELD
Sculding
SURVEYED BY Martin DATE 6-64
DRAWN BY Buxton DATE 7-64
TRACED BY R.L.E. DATE 7-64

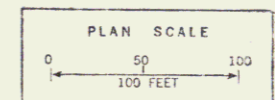

PROJ. I NO. 89-1 (25)
SHEET 25 OF SHEETS

Control of Access is complete on this Sheet

Sheet 36 of 155 Sheets

48