


* THREE CABLE GUARD RAIL WITH LIGHT STEEL POSTS, ITEM 538
 NB 1838+00 - 1838+54.12
 NB 1838+00 - 1840+54.12
 37' 3"

* TREATED TIMBER CURB, ITEM 558
 NB 1838+00 - NB 1840+00 PL
 NB 1838+00 - 1839+13 Rt.

DRILLING & BLASTING OF SOLID ROCK SUBGRADE, ITEM 115
 NB 1841+00 - 1854+00

PROPERTY LINE FENCE, MOD., ITEM 583-II
 1850+00 - 1854+00 NB RT.
 (P/L Fence to be erected prior to Construction)

* = Stage 2 Construction

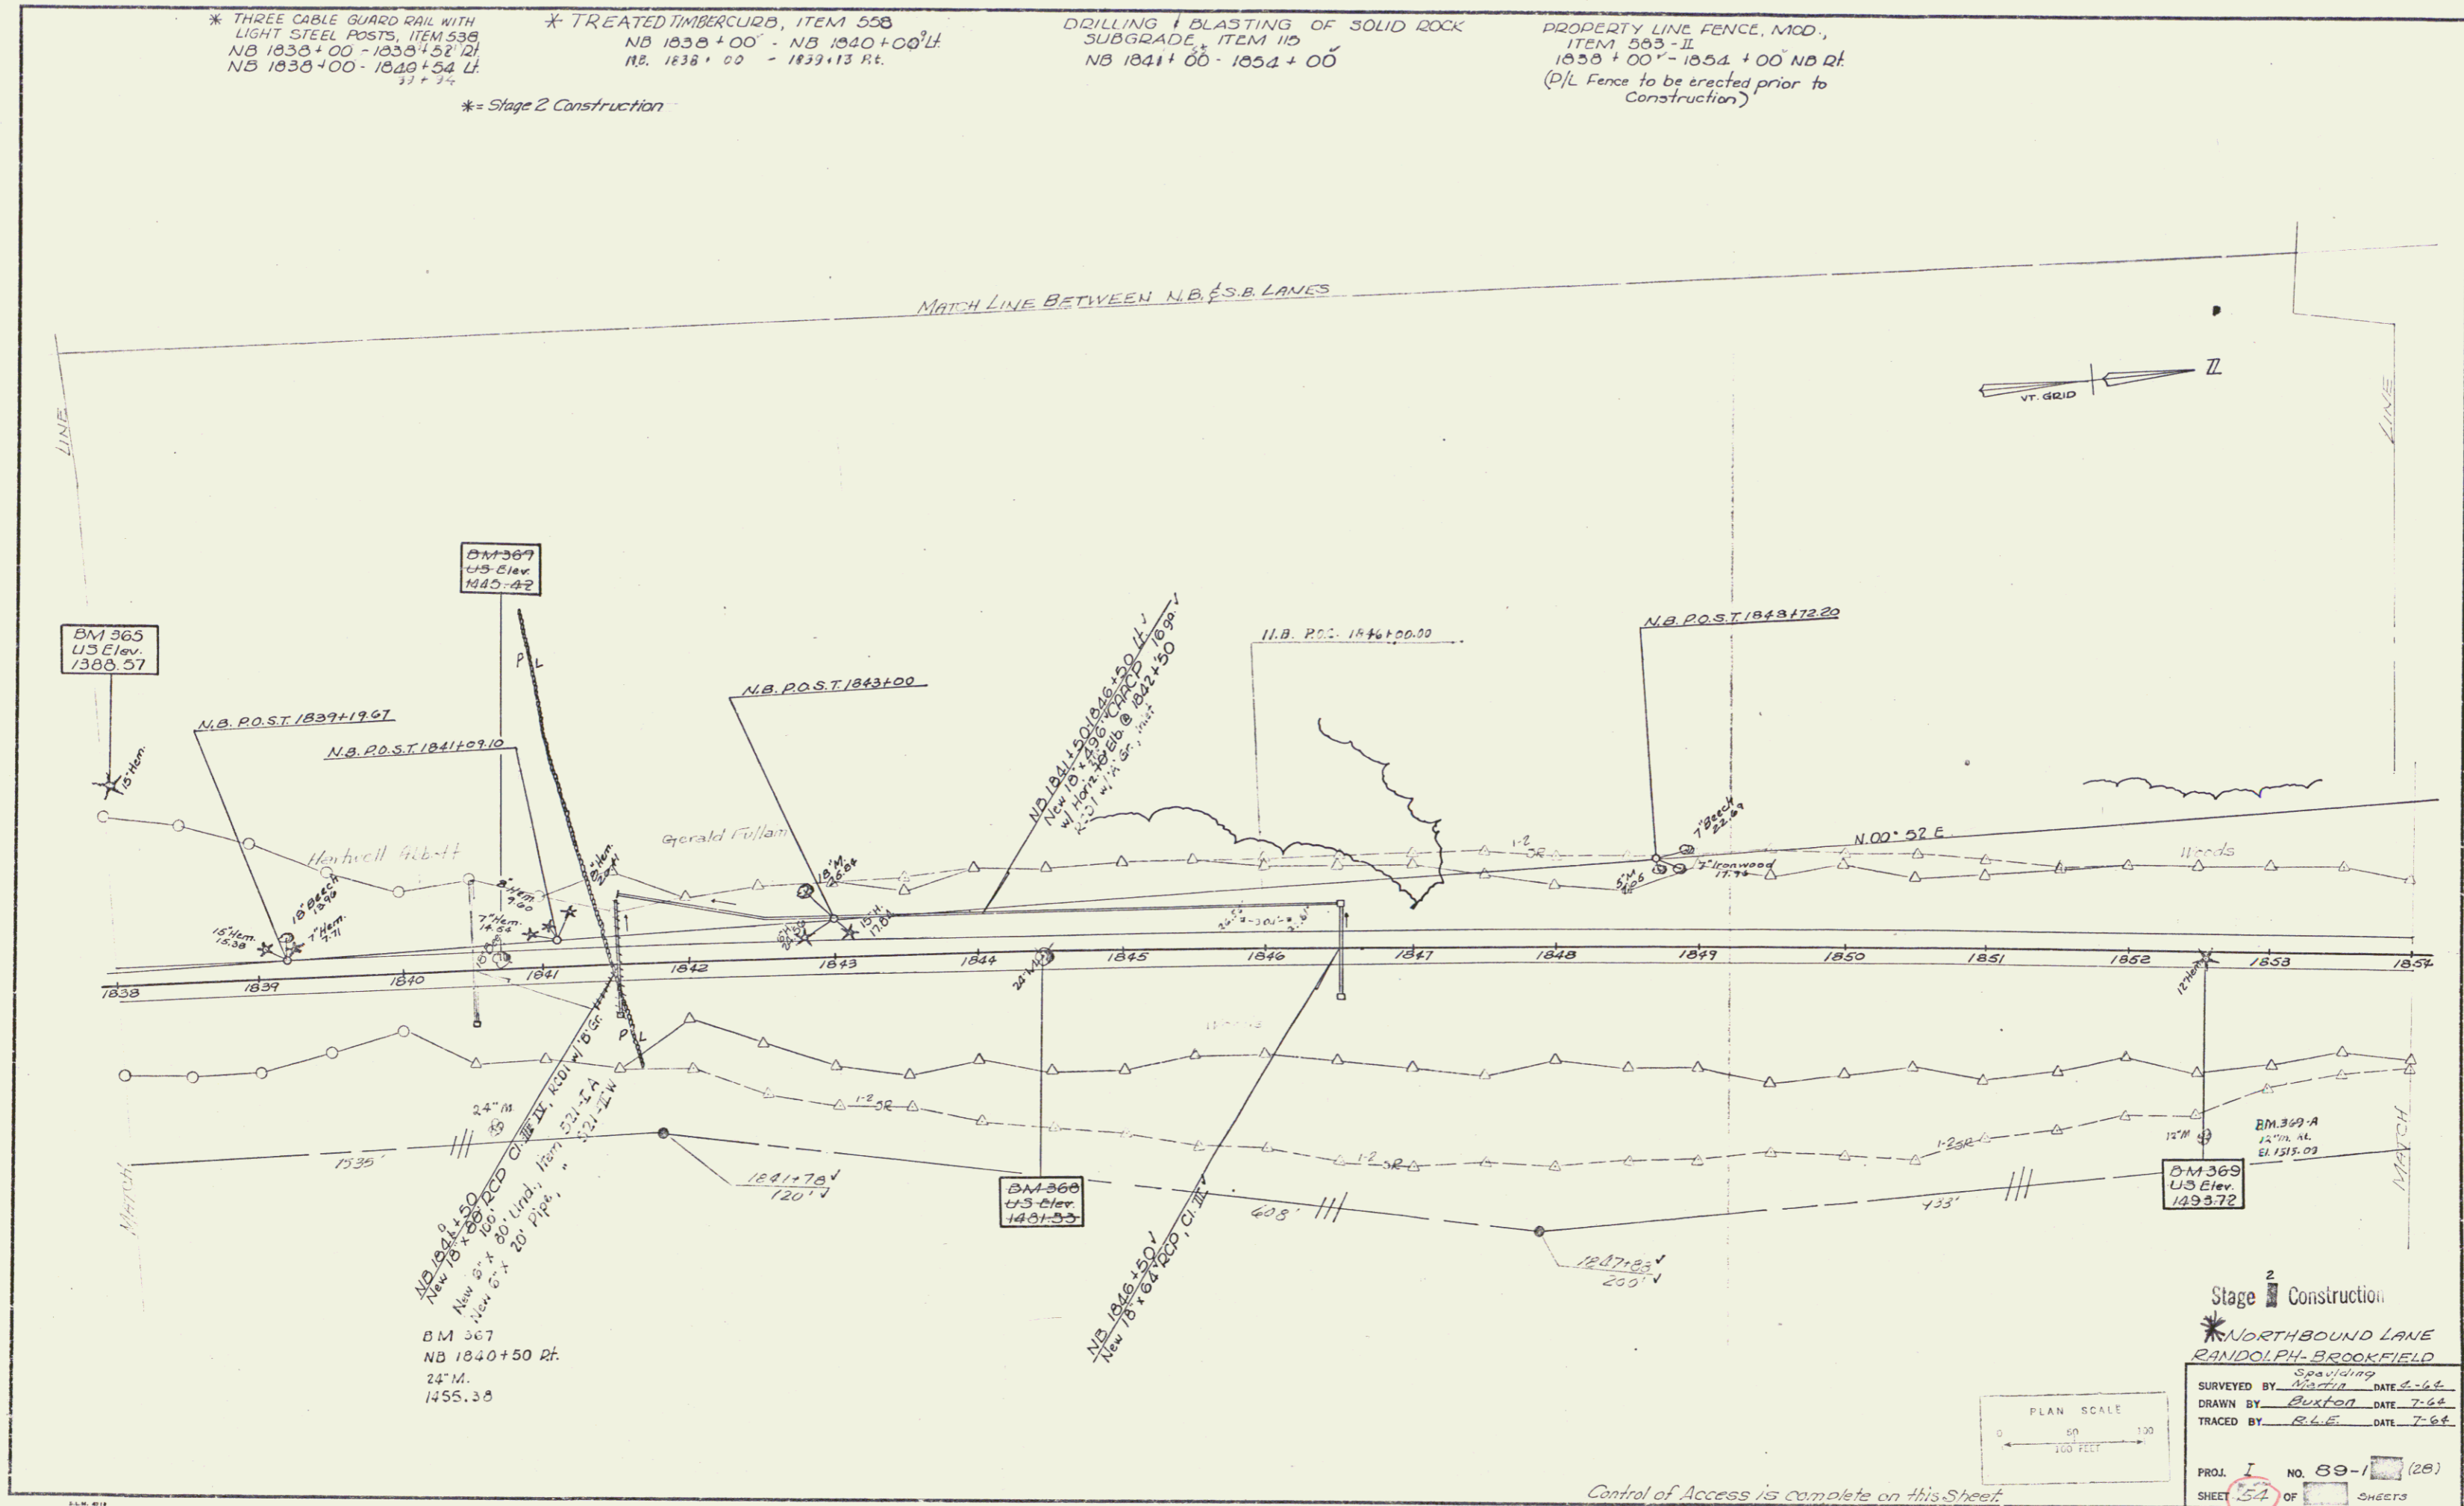

Stage 2 Construction
 * NORTHBOUND LANE
 RANDOLPH-BROOKFIELD
 SURVEYED BY *Ward* DATE 6-66
 DRAWN BY *Buxton* DATE 7-66
 TRACED BY *R.L.E.* DATE 7-66
 PROJ. I NO. 89-1 (28)
 SHEET 54 OF SHEETS
 Scale 46 of 155 Sheets

Control of Access is Complete on this Sheet.