
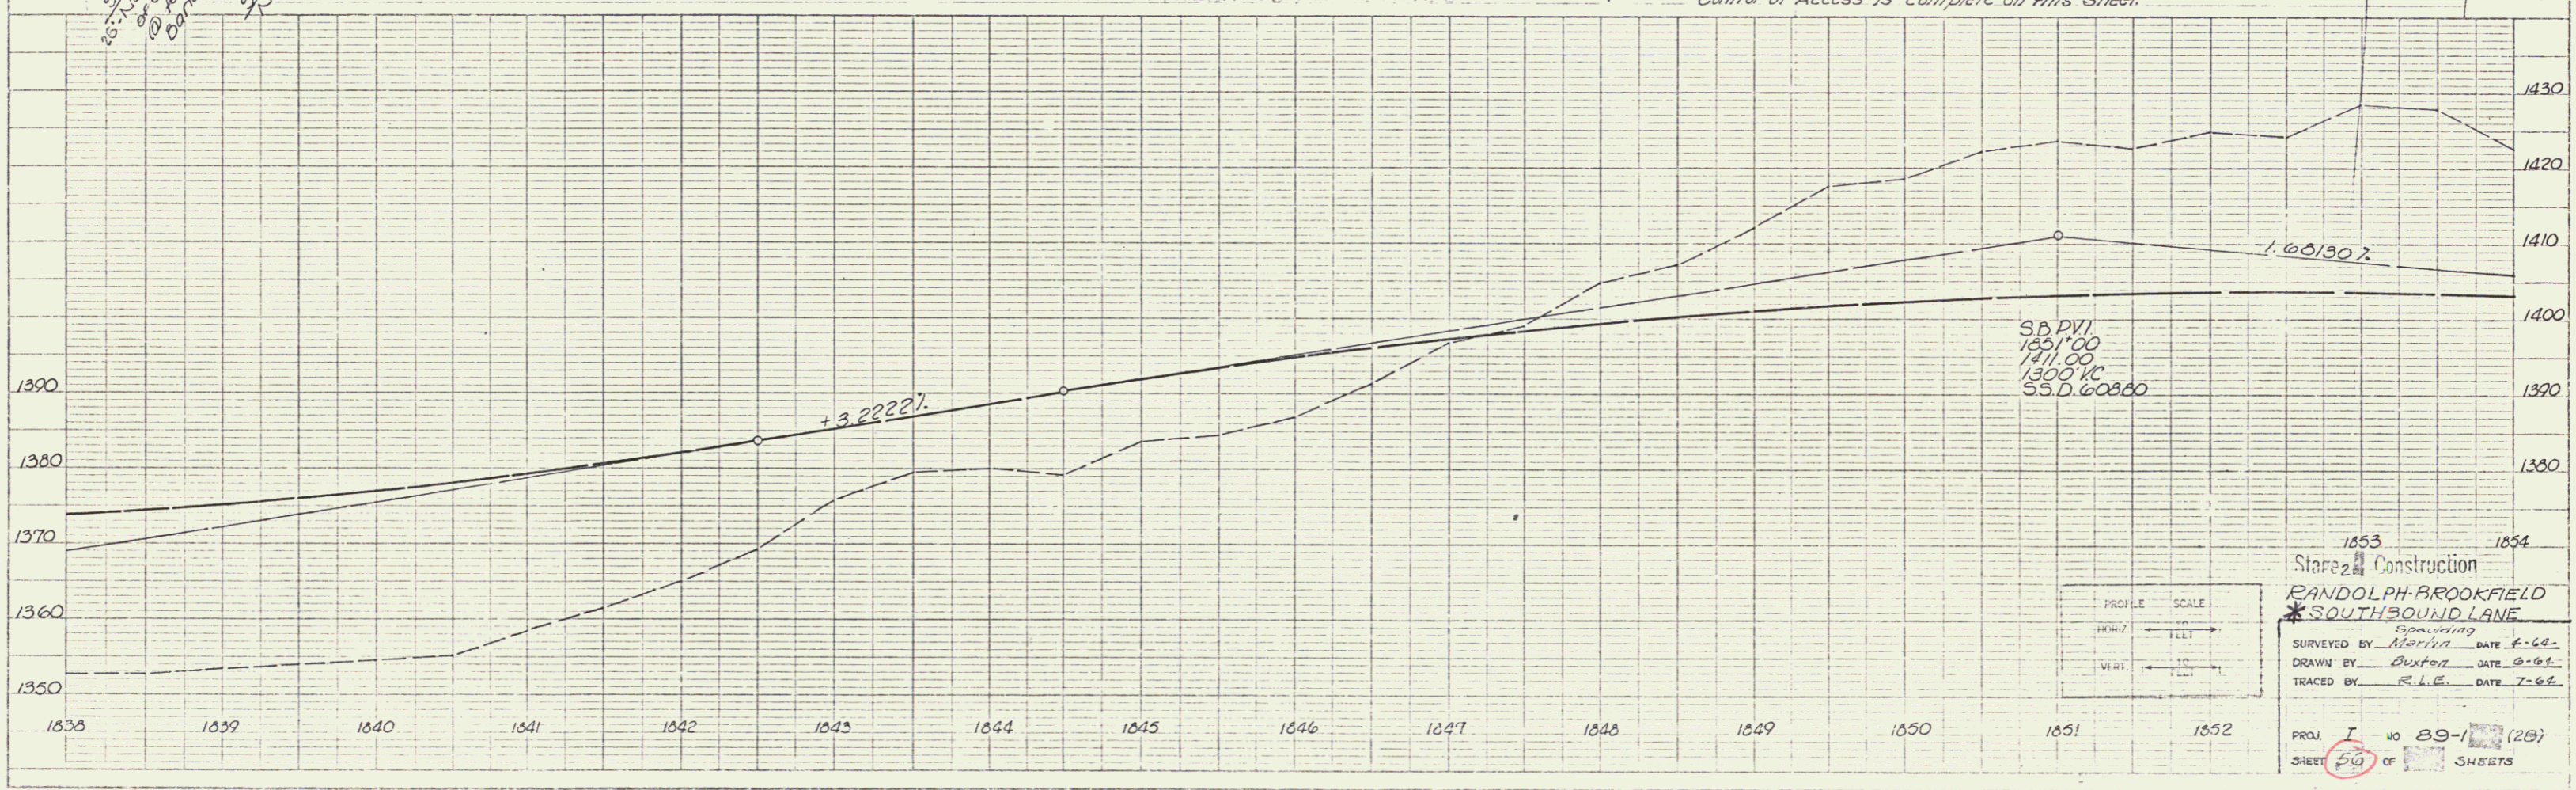


PLAN
 SHEET NO. 54
 PROJECT NO. 89-1 (28)

DATE
 8/66
 SHERIDAN

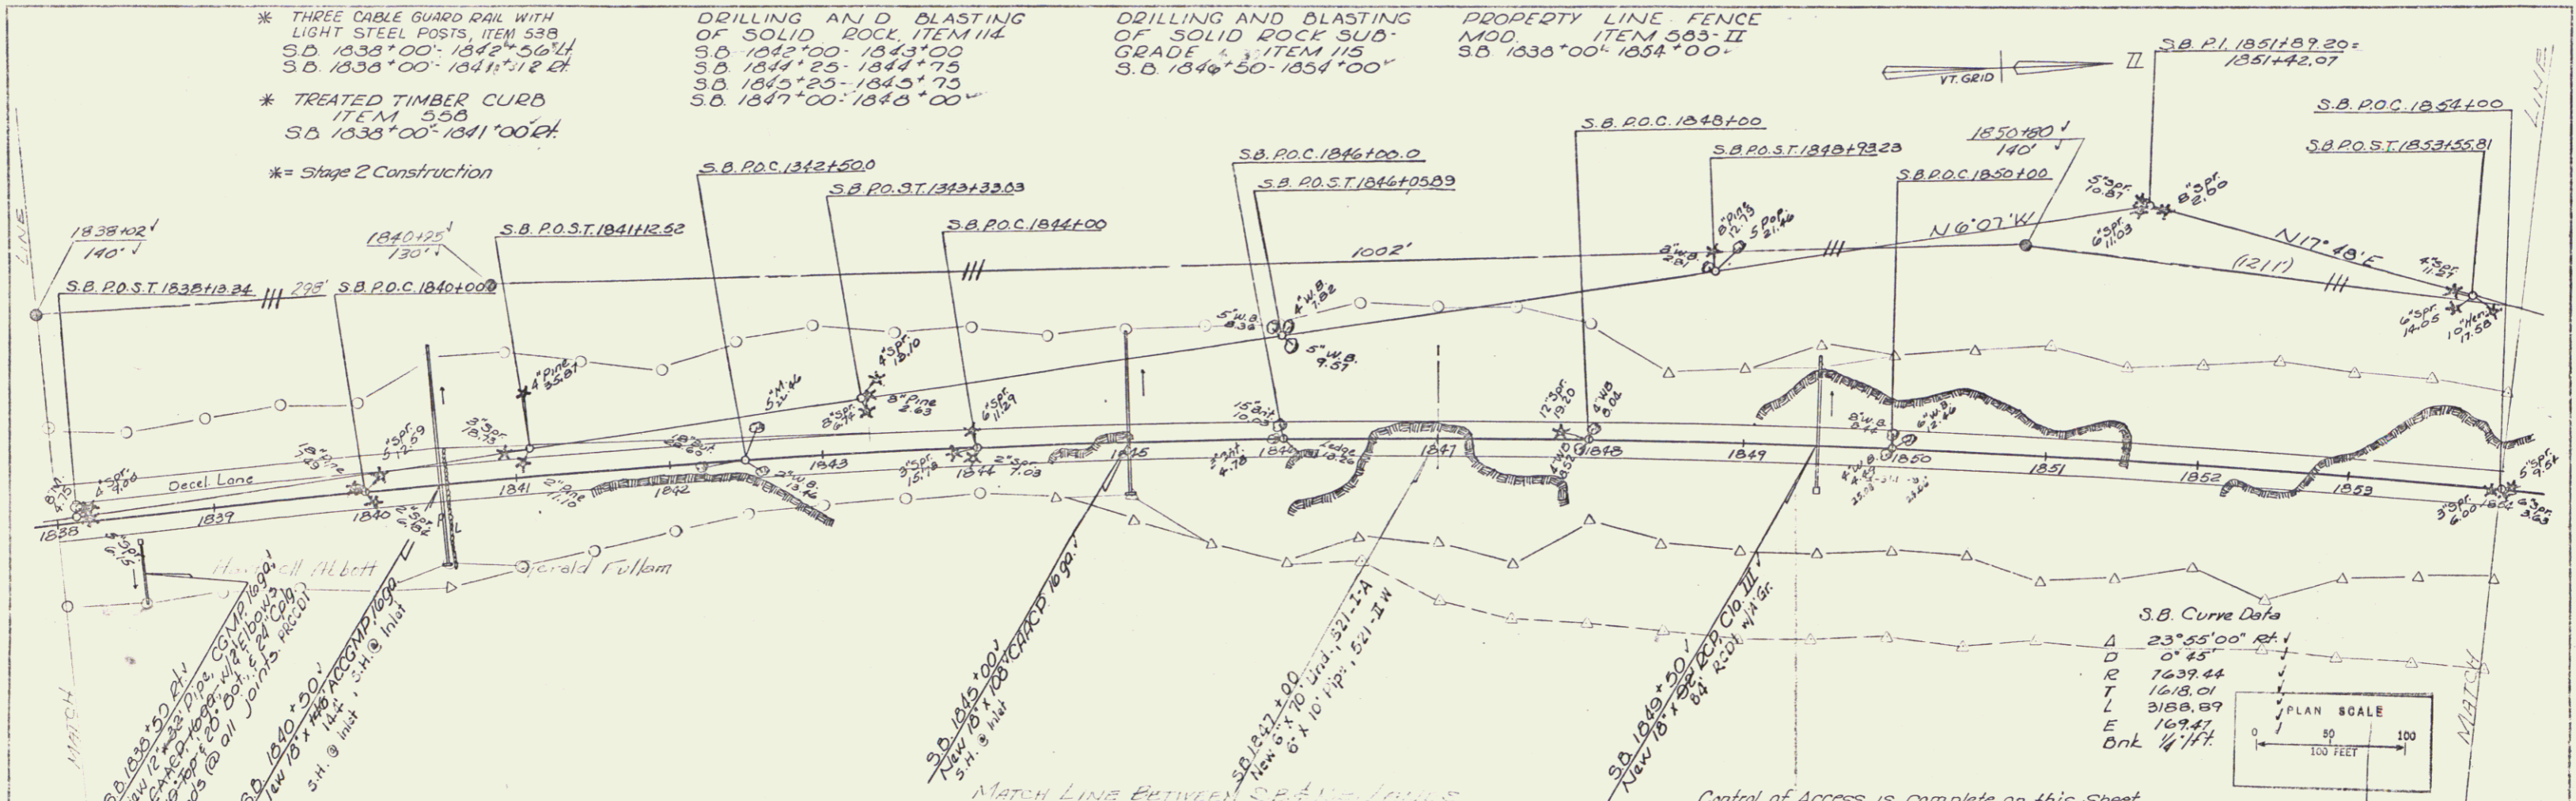

S.B. Curve Data

A	23°55'00" Rt.
D	0'45"
R	7639.44
T	1618.01
L	3188.89
E	169.47
Dist	1/4 MI

PROFILE SCALE

HORIZ.	1" = 20'
VERT.	1" = 10'

1853 Construction 1854
 Stare 2 Construction
 RANDOLPH-BROOKFIELD
 *SOUTHQUIN LANE
 Surveyed by Merita DATE 6-66
 DRAWN BY Buxton DATE 8-66
 TRACED BY R.L.E. DATE 7-66
 PROJ. I NO. 89-1 (28)
 SHEET 54 OF 58 SHEETS

NOTES
 1. SEE PLAN SHEET 53 FOR PREVIOUS WORK
 2. SEE SHEET 55 FOR FURTHER DETAILS

Sheet 54 of 58 Sheets
 54