
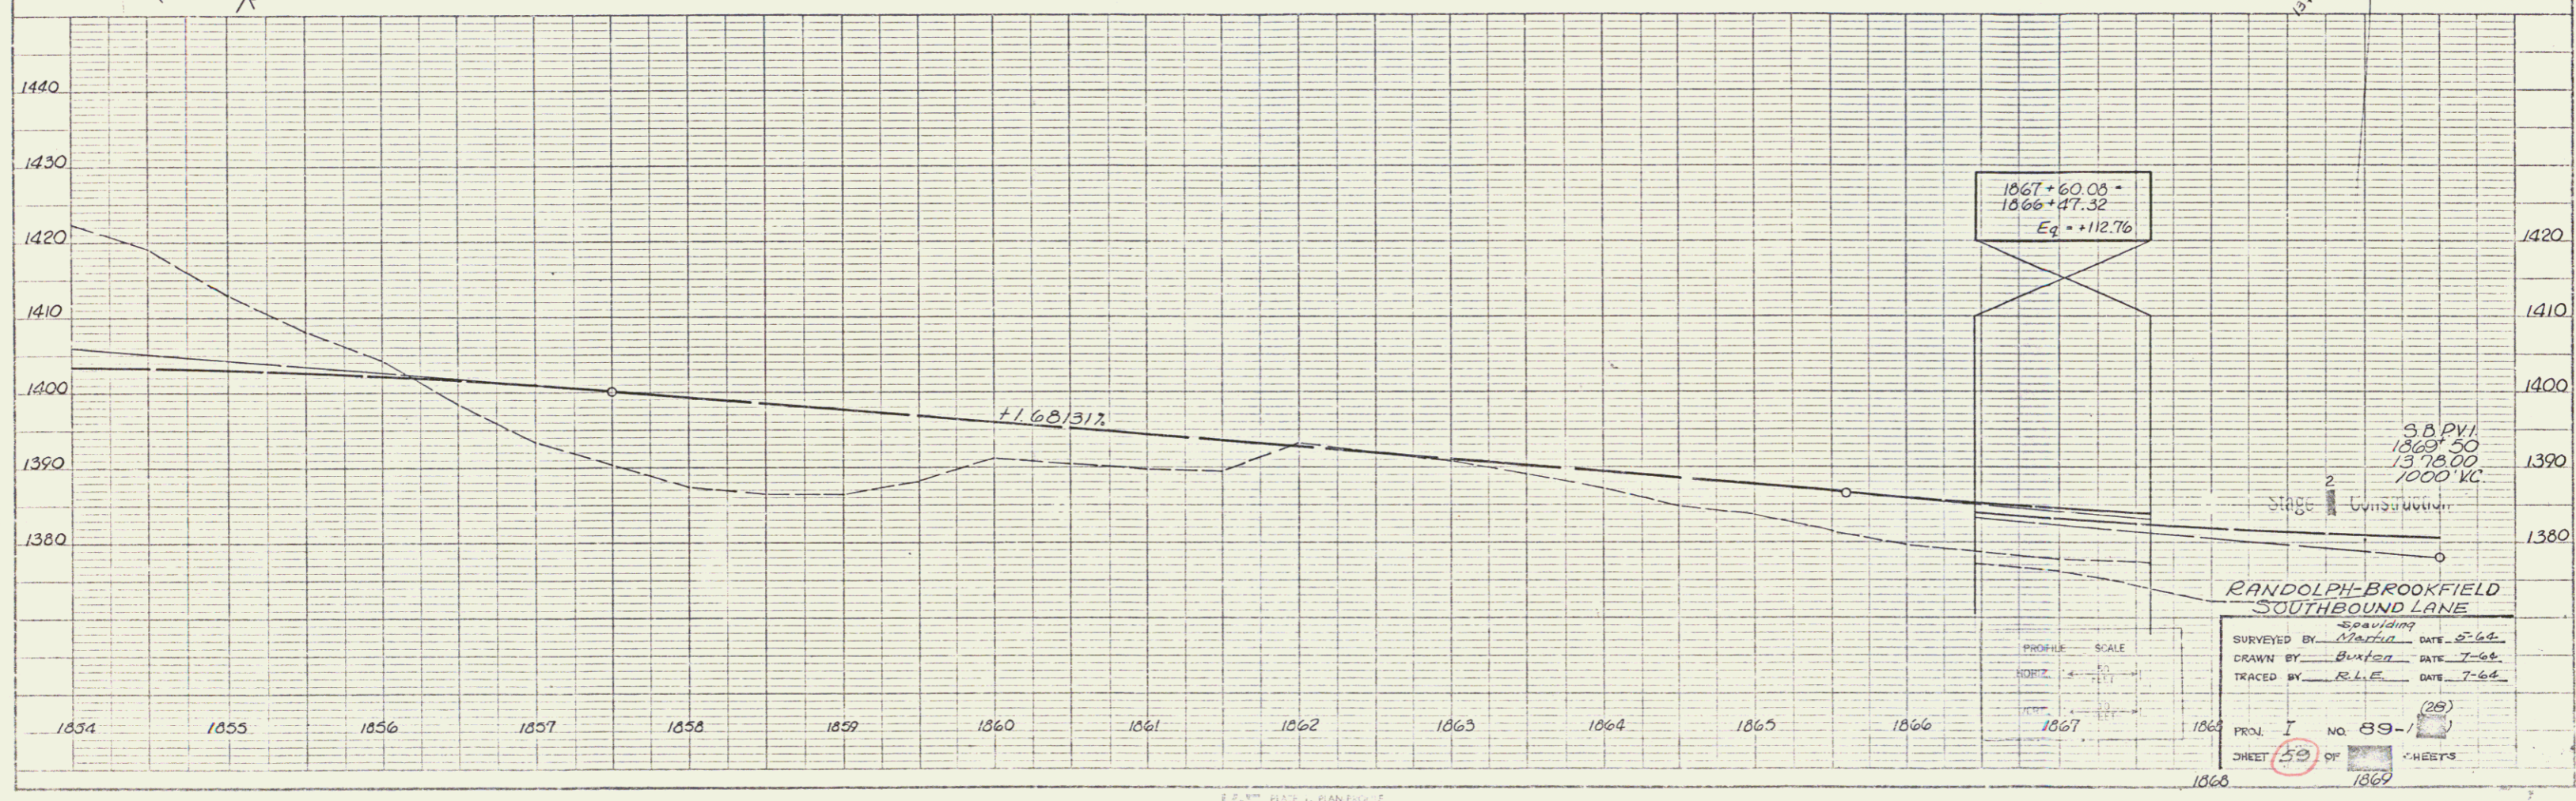


\* THREE CABLE GUARD RAIL WITH LIGHT STEEL POSTS, ITEM 53B  
S.B. 1857+00-1860+52 Lt.  
\* = Stage 2 Construction

DRILLING AND BLASTING OF SOLID ROCK ITEM 114  
S.B. 1858+50-1859+50  
S.B. 1867+50-1868+00

DRILLING AND BLASTING OF SOLID ROCK SUBGRADE ITEM 115  
S.B. 1854+00-1856+50  
S.B. 1860+90-1863+50

PROPERTY LINE FENCE MOD. ITEM 503-II  
S.B. 1854+00-1869+00

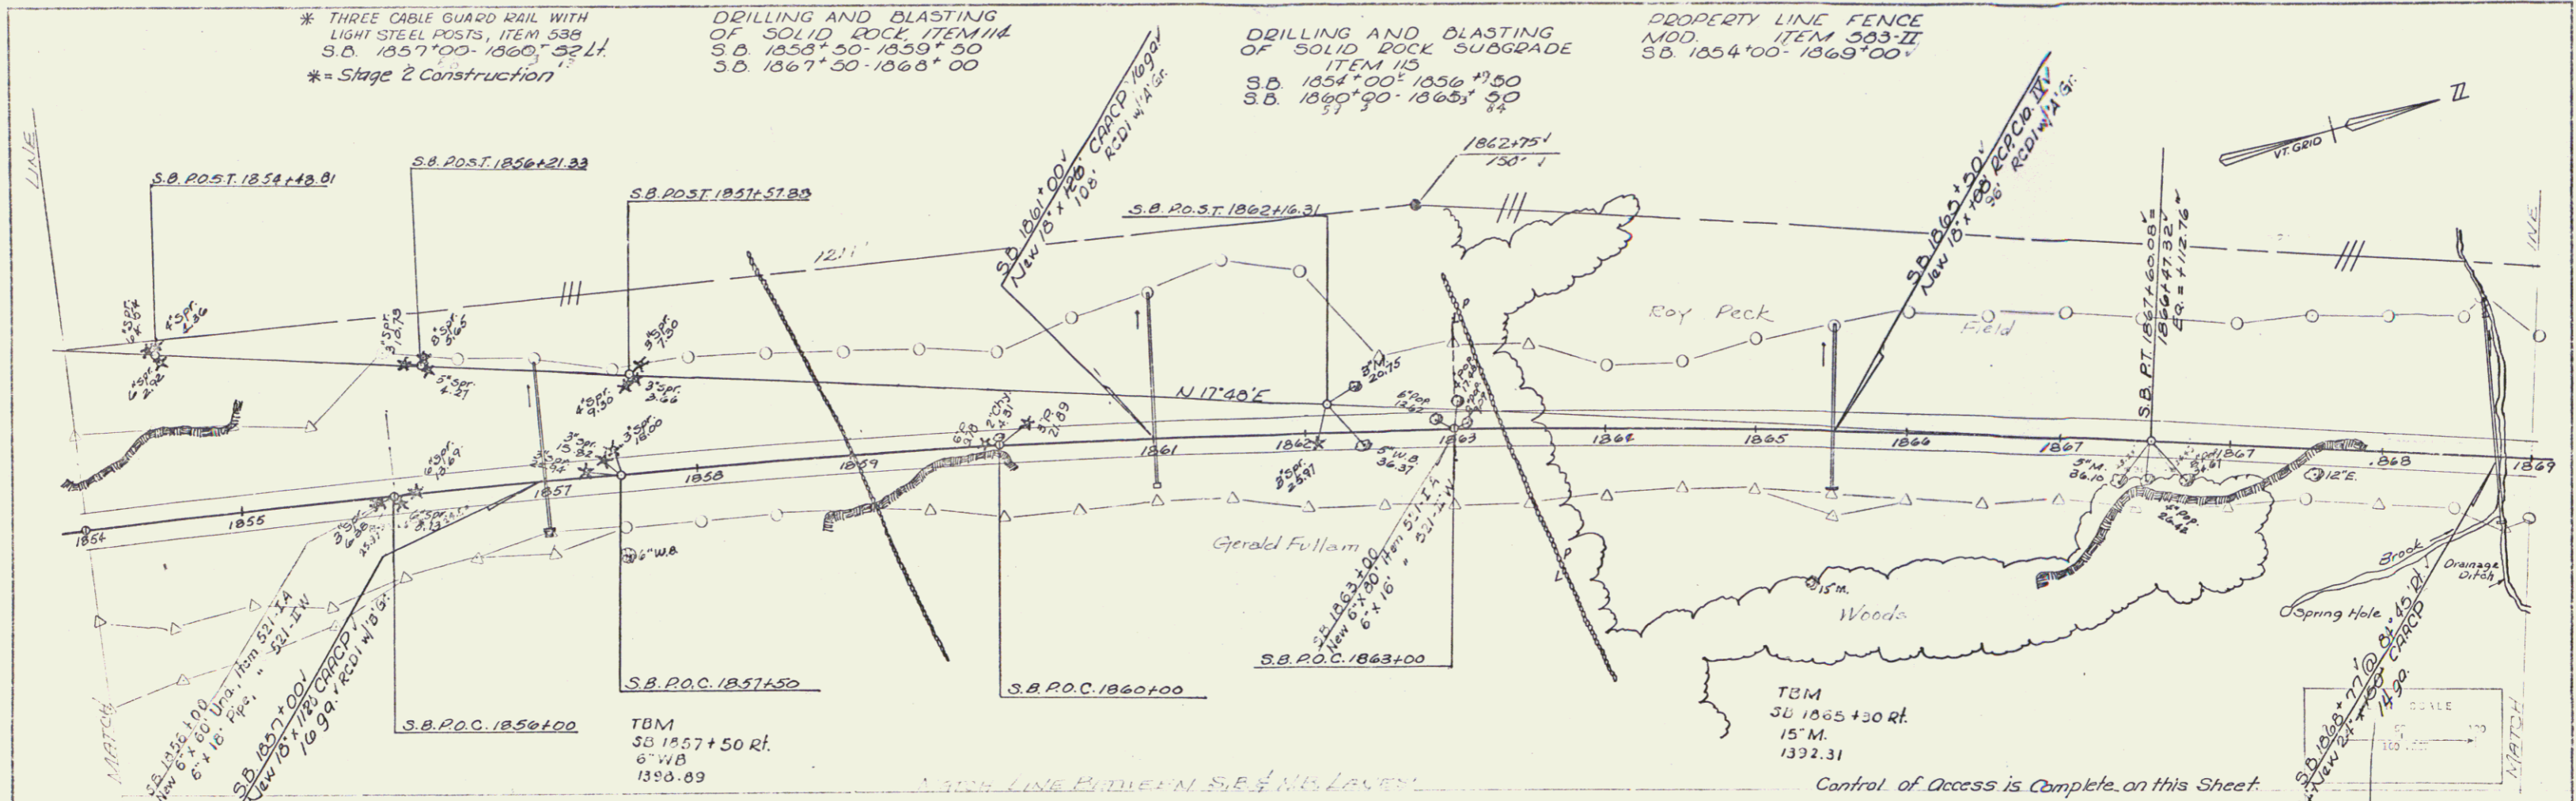

1867+60.00 =  
1866+47.32  
Eg = +112.76

RANDOLPH-BROOKFIELD  
SOUTHBOUND LANE

SURVEYED BY *Martin* DATE *5-64*  
DRAWN BY *Burton* DATE *7-64*  
TRACED BY *R.L.E.* DATE *7-64*

PROJ. I NO. 89-1  
SHEET 59 OF 60 SHEETS