


2+75 4+10

\*STANDARD STEEL BEAM GUARD RAIL WITH STEEL POSTS MOD ITEM 545-A TRUCK LANE 3+75-11+25 LT. \*STAGE 2 CONSTRUCTION ITEM

\*VERTICAL GRANITE CURB ITEM 556-B R.A. 8+50-11+60 LT. TL. 7+00-10+50 RT. A.A. 12+01-11+51 LT.

\*BITUMINOUS CONCRETE SIDEWALK ITEM 562 R.A. 8+50-11+60 LT. TL. 7+00-10+50 RT.

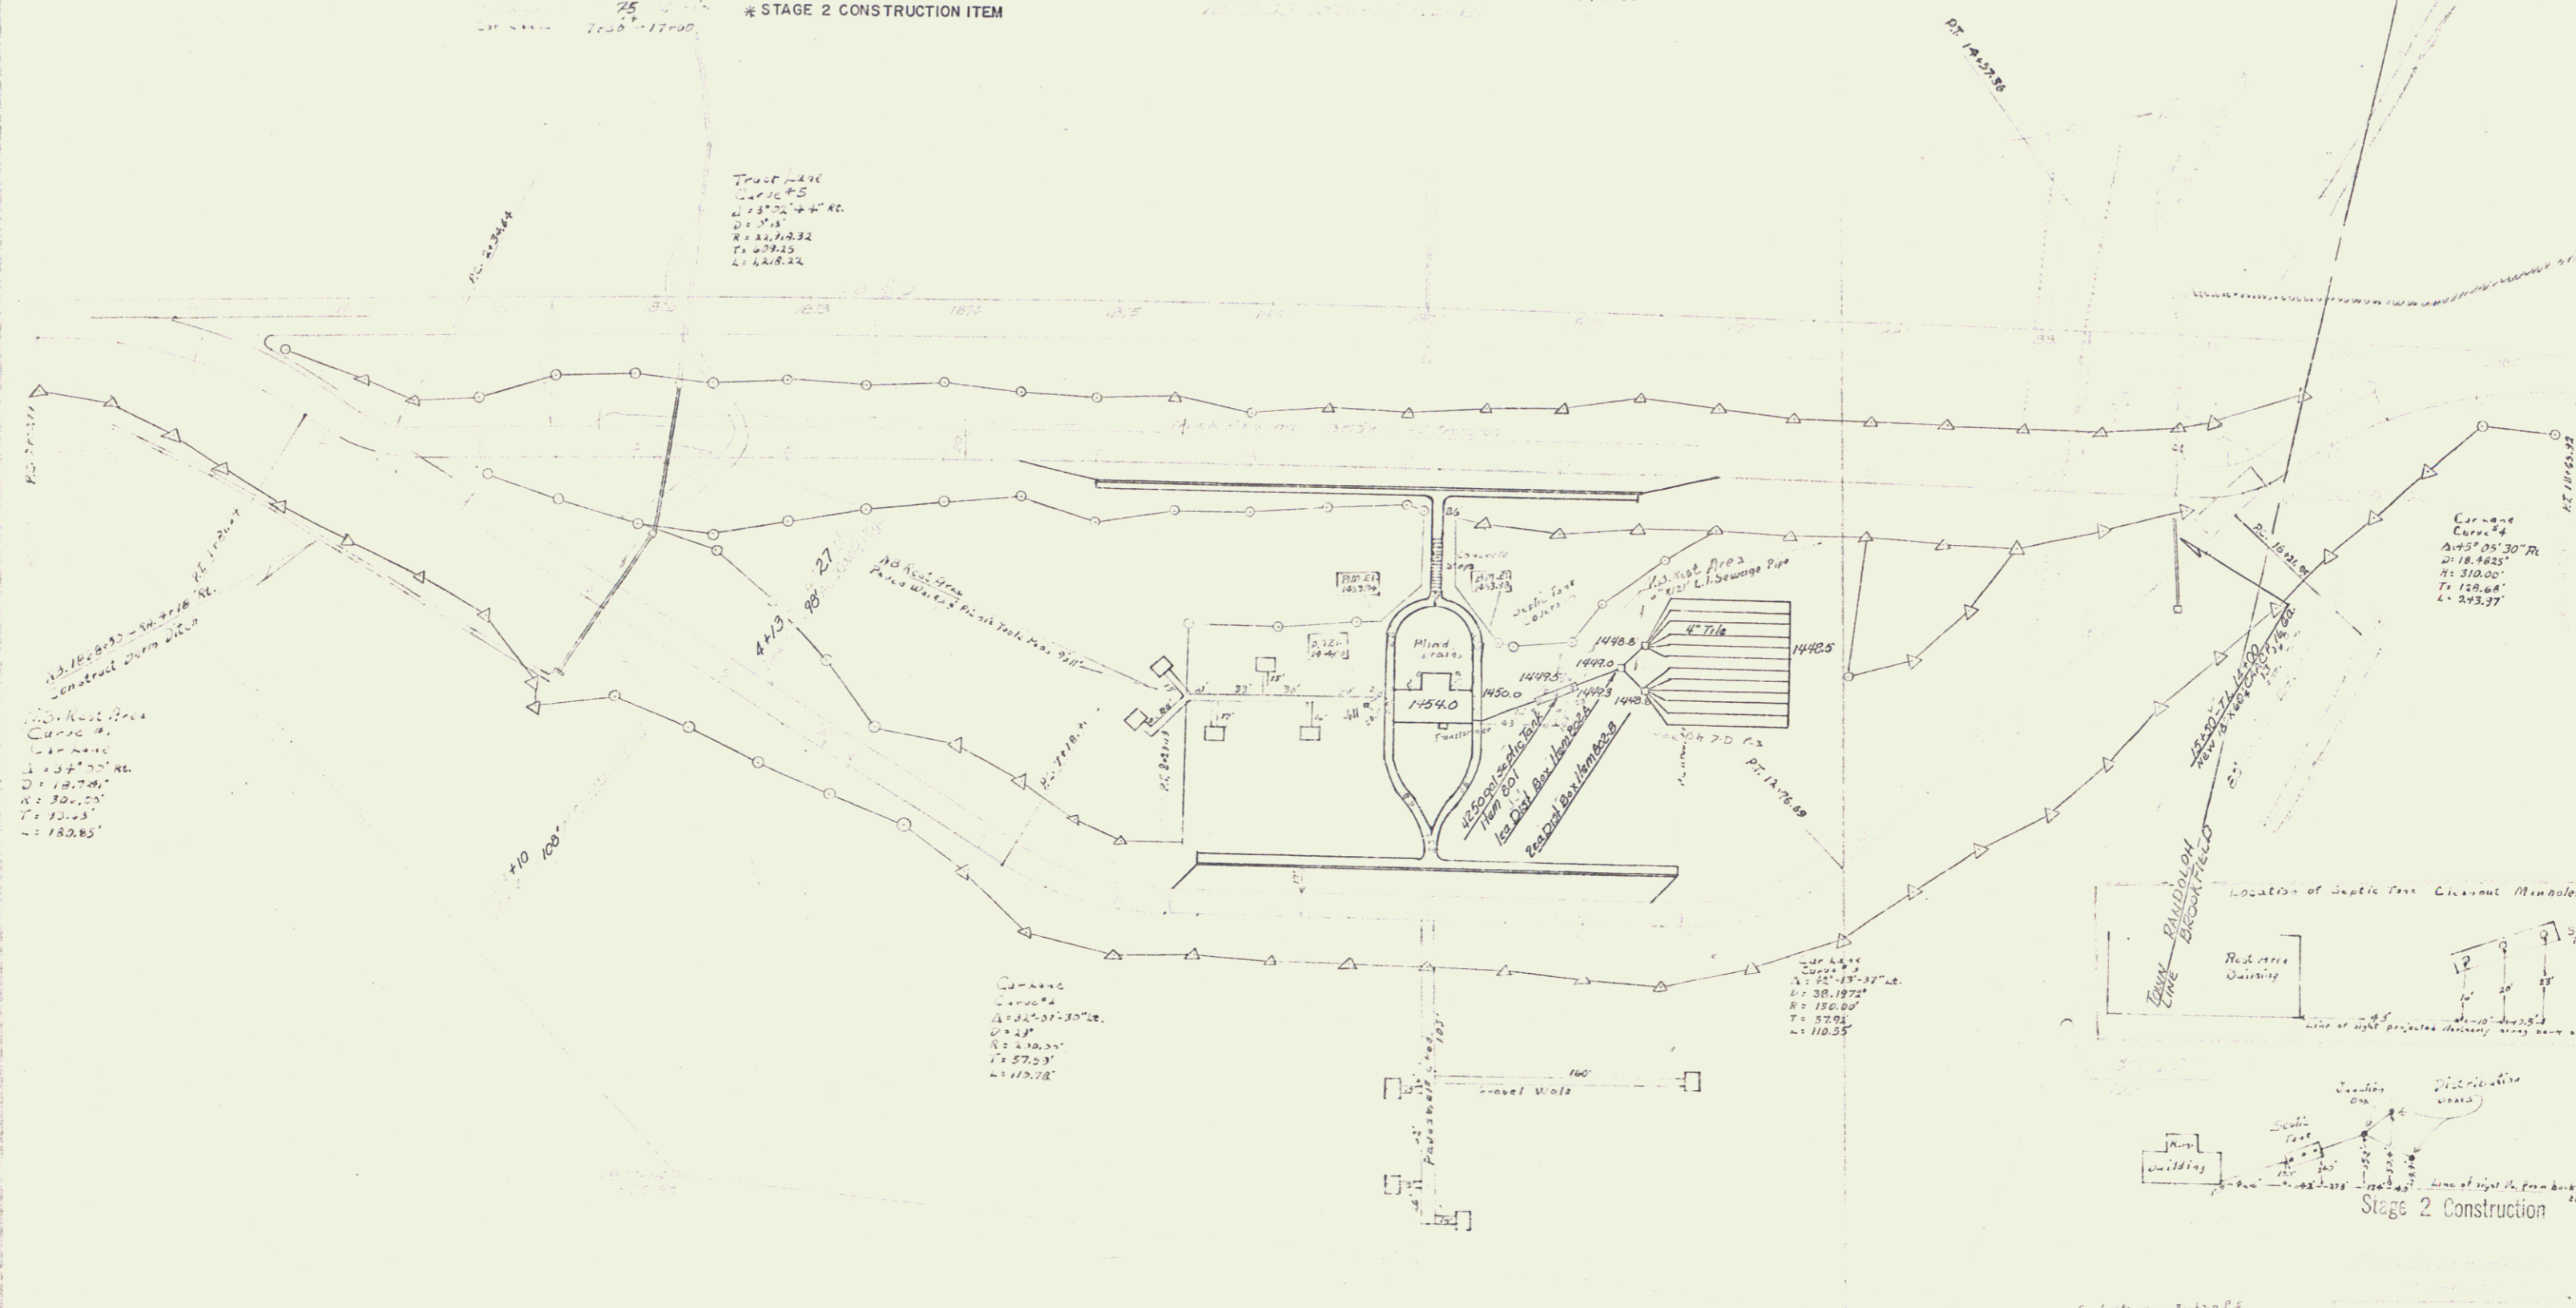


100' Rest Area  
 Curve 1/4  
 L=100.00'  
 Δ=135° 00' 00"  
 R=180.85'

Truck Lane  
 Curve 1/4  
 L=100.00'  
 Δ=135° 00' 00"  
 R=180.85'

Curve 1/4  
 L=100.00'  
 Δ=135° 00' 00"  
 R=180.85'

Curve 1/4  
 L=100.00'  
 Δ=135° 00' 00"  
 R=180.85'

Curve 1/4  
 L=100.00'  
 Δ=135° 00' 00"  
 R=180.85'

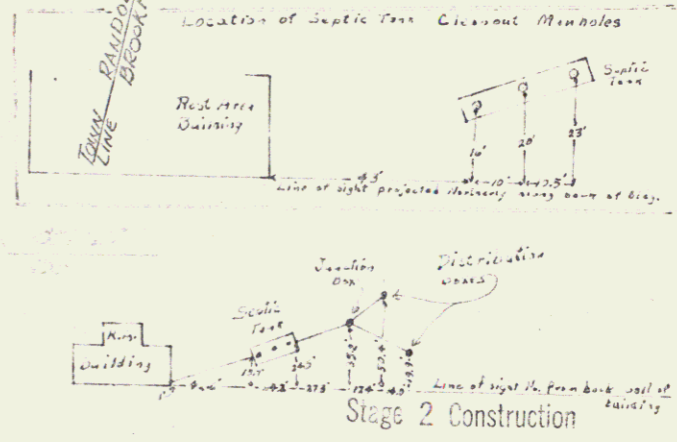

62

54 155 Sheets

58