


* THREE CABLE GUARD RAIL WITH LIGHT STEEL POSTS, ITEM 53B
SB 1914+00-1917+00 Lt.

MUCK EXCAVATION ITEM 117
SB 1907+50-1911+50 Rt.

DRILLING & BLASTING OF SOLID ROCK SUBGRADE, ITEM 115
NB 1901+00-1905+00
SB 1901+00-1905+00 Rt.
NB 1912+00-1917+00
SB 1912+00-1917+00 Lt.
NB 1911+00-1917+00
SB 1914+00-1917+00

PROPERTY LINE FENCE, MOD ITEM 533-II
NB 1901+00-1917+00
SB 1901+00-1917+00 Lt.

*=Stage 2 Construction

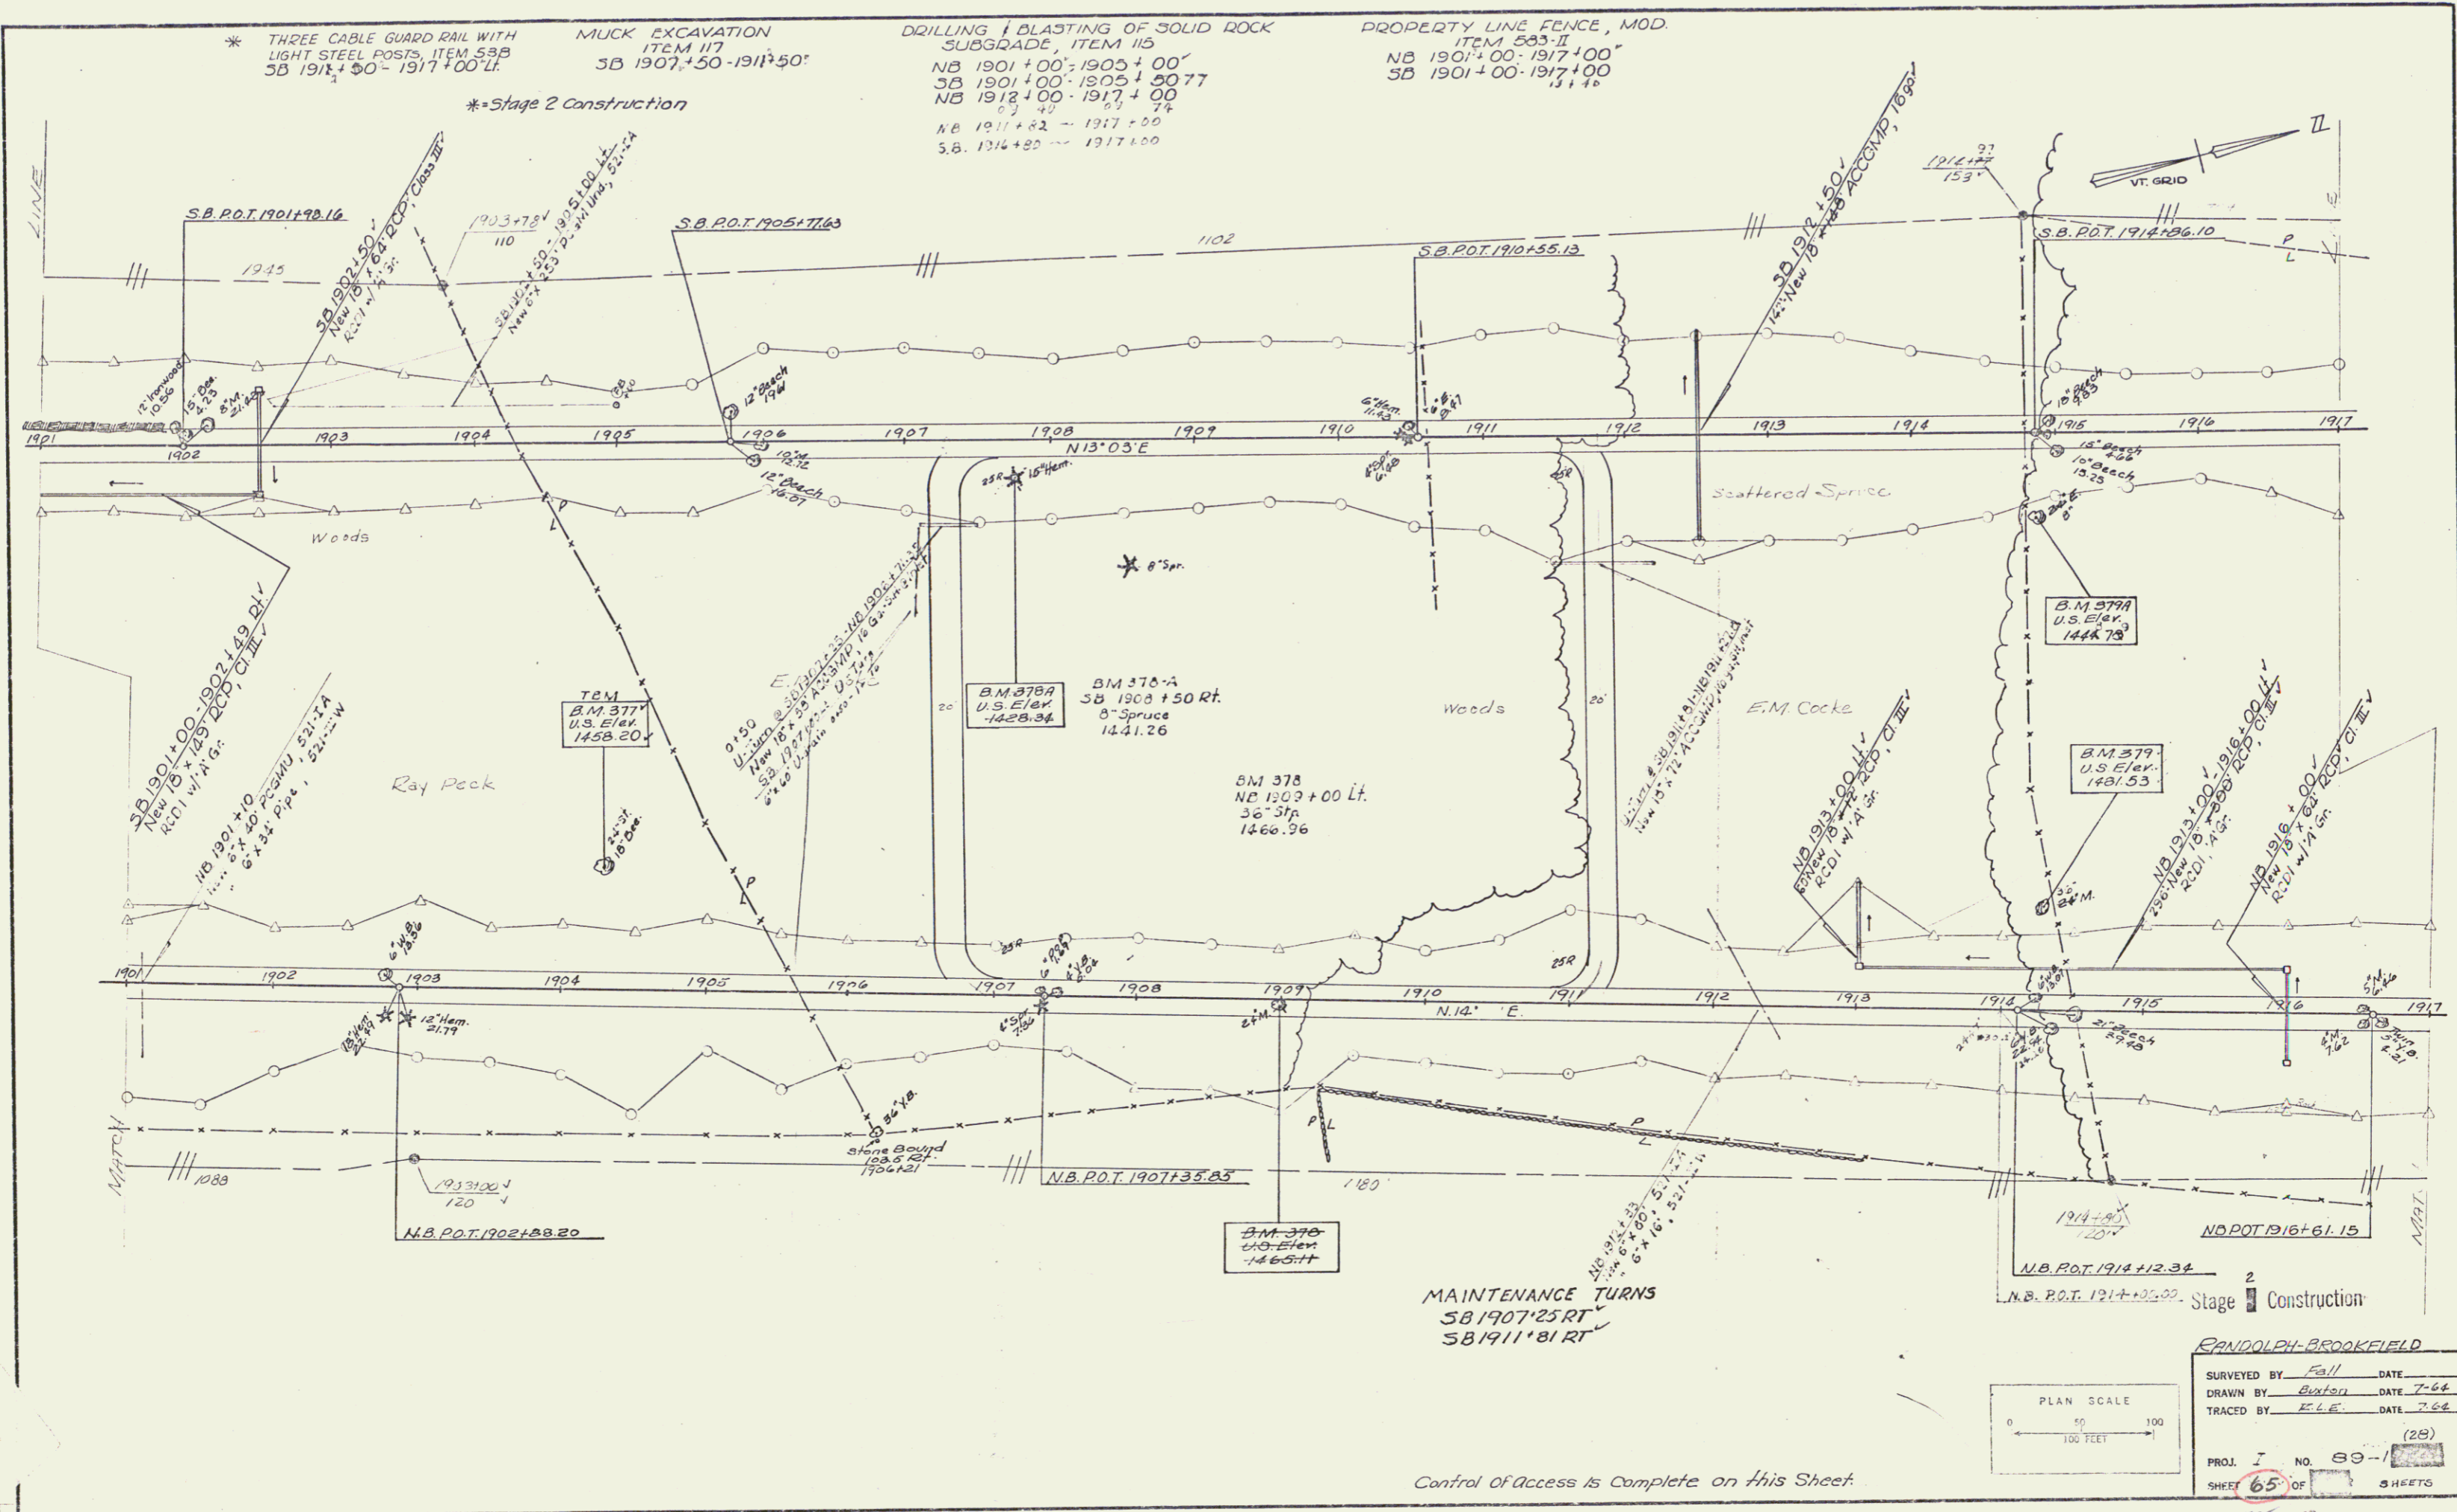

MAINTENANCE TURNS
SB 1907+25 RT
SB 1911+81 RT

RANDOLPH-BROOKFIELD

SURVEYED BY	Fall	DATE	
DRAWN BY	Buxton	DATE	7-64
TRACED BY	K.L.E.	DATE	7-64
PROJ. NO.	89-	(28)	
SHEET	65	OF	8 SHEETS

Control of Access is Complete on this Sheet.

Sheet 58 of 152 Sheets