

* THREE CABLE GUARD RAIL WITH
LIGHT STEEL POSTS, ITEM 530
NB 1955+86-1964+80' Lf
NB 1955+90-1958+14' RT
SB 1956+40-1958+00' B
SB 1956+40-1958+64' Lf


PLANK GUARD RAIL ITEM 540
NB 1949+75 RT (16')

*=Stage 2 Construction

SUBBASE OF SAND, ITEM 202
SB 1952+00-1955+75

DRILLING & BLASTING OF SOLID
ROCK SUBGRADE, ITEM 115
NB 1949+00-1954+00
SB 1950+00-1955+00
SB 1963+00-1965+00
N.B. 1960+34-12+5+00

PROPERTY LINE FENCE, MOD.
ITEM 503-II
NB SB 1949+00-1965+00' Lf & Rt
To be erected prior to construction

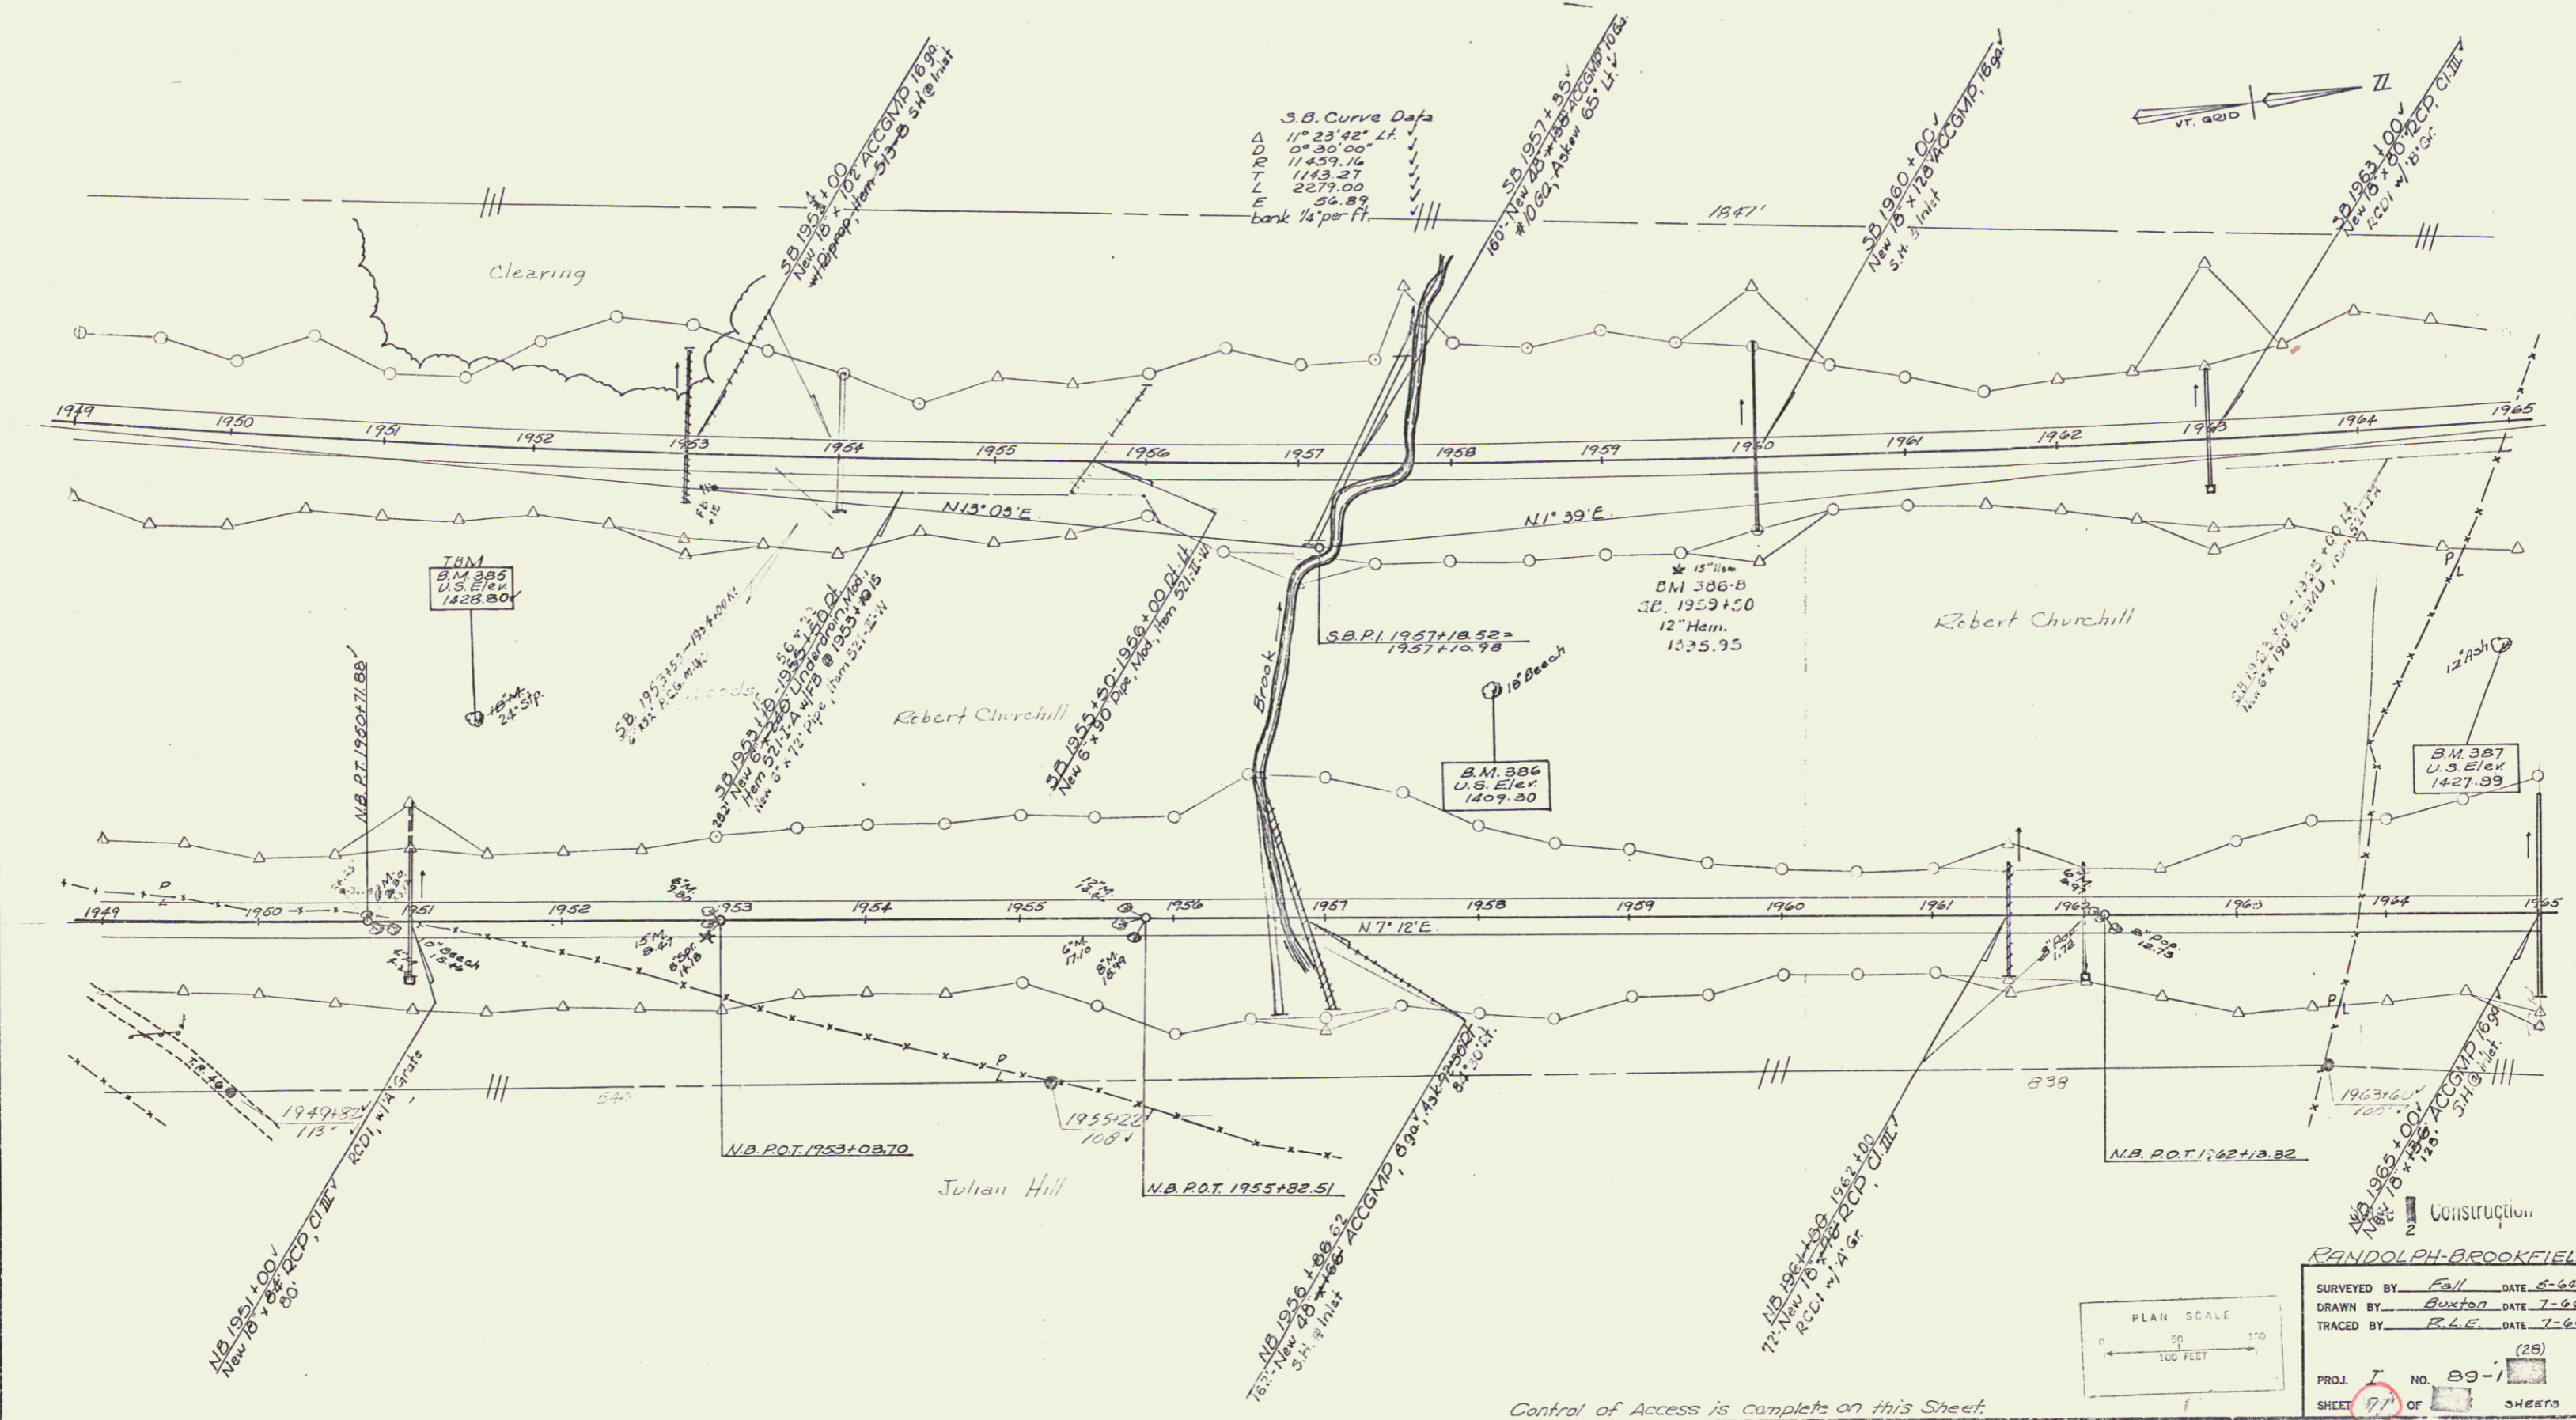

Control of Access is complete on this Sheet.