

* THREE CABLE GUARD RAIL WITH LIGHT STEEL POSTS, ITEM 539-22
 N.B. 1981+00 LT - 1986+16 LT
 N.B. 1982+78 LT - 1988+30 LT
 S.B. 1981+00 LT - 1988+78 LT
 S.B. 1982+40 - 1984+06 RT


Treated Timber Curb
 S.B. 1981+00 - 1982+05 LL

* = Stage 2 Construction

DRILLING AND BLASTING OF SOLID ROCK SUBGRADE ITEM 115
 S.B. 1987+00 - 1997+00
 N.B. 1989+00 - 1997+00 LT
 DRILLING AND BLASTING OF SOLID ROCK, ITEM 114
 S.B. 1990+00 - 1996+50'

PROPERTY LINE FENCE
 N.O.D. ITEM 533-II
 S.B. 1981+00 - 1986+25 LT
 S.B. 1987+50 - 1997+00 LT
 N.B. 1981+00 - 1988+60 LT
 N.B. 1989+50 - 1997+00 RT

Blank Worksheet
 N.B. 1985+72 - 1987+93
 N.B. 1985+87 - 1988+24
 N.B. 1985+83 - 1989+24
 N.B. 1989+25 - 1993+25 RT

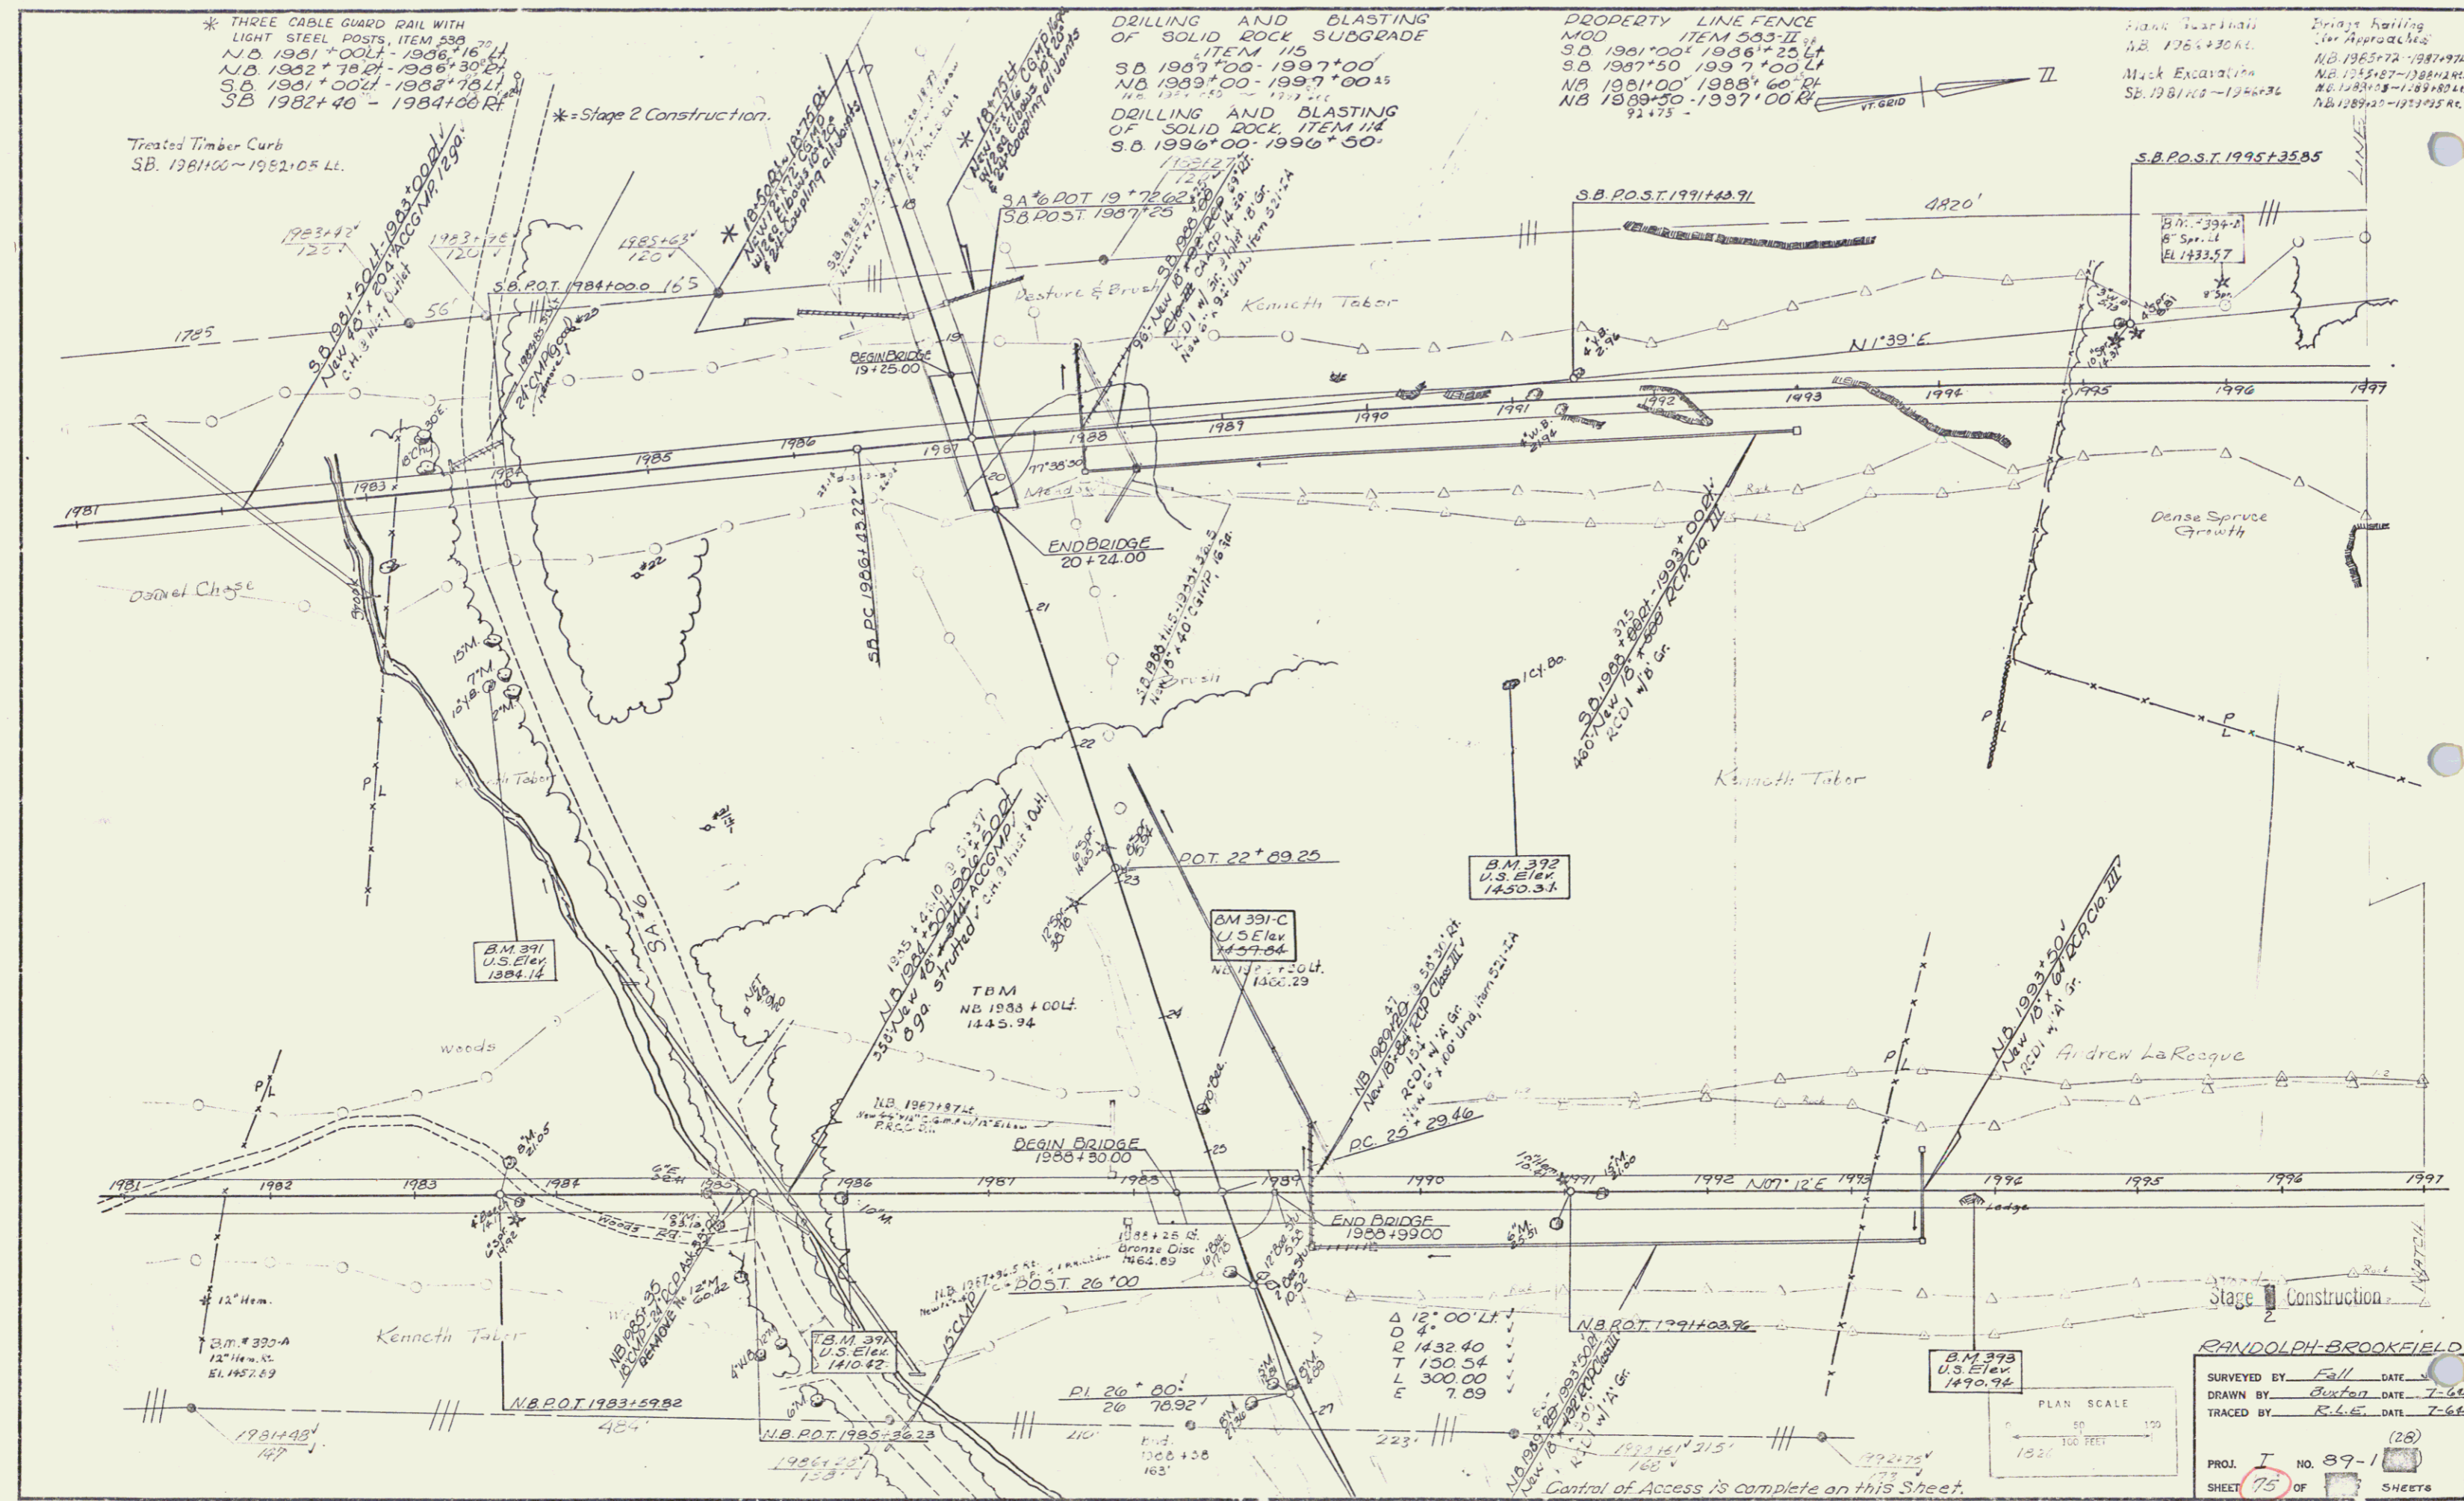

RANDOLPH-BROOKFIELD
 SURVEYED BY Fall DATE 7-66
 DRAWN BY Buxton DATE 7-66
 TRACED BY R.L.E. DATE 7-66
 PROJ. NO. 89-1
 SHEET 75 OF SHEETS
 Sheet 68 of 155 Sheets

65