


\* THREE CABLE GUARD RAIL WITH LIGHT STEEL POSTS, ITEM 538  
 N.B. 2019+00 - 2023+00 R.L.  
 \* = Stage 2 Construction.

DRILLING AND BLASTING OF SOLID ROCK, ITEM 114  
 N.B. 2021+00 - 2022+00  
 SUBBASE OF SAND, ITEM 202  
 N.B. 2015+75 - 2021+75  
 N.B. 2021+00 - 2029+00

PROPERTY LINE FENCE MOD. ITEM 533-II  
 N.B. 2013+00 - 2029+00  
 S.D. 2013+00 - 2029+00  
 DRILLING AND BLASTING OF SOLID ROCK SUBGRADE, ITEM 115  
 N.B. 2013+00 - 2015+05  
 S.D. 2013+00 - 2024+00  
 N.B. 2023+70 - 2029+00

Muck Excavation  
 S.B. 2023+70 - 2029+00  
 N.B. 2026+00 - 2029+00  
 STONE FILL  
 N.B. 2021+00 - 2022+00 R.L.

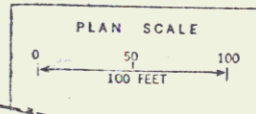

RANDOLPH-BROOKFIELD  
 SURVEYED BY Jewett DATE 5-24  
 DRAWN BY Buxton DATE 7-24  
 TRACED BY R.L.E. DATE 7-24  
 PROJ. I NO. 89-1  
 SHEET 79 OF 129 SHEETS

Control of Access is complete on this Sheet

Sheet 79 of 129 Sheets

67