


Muck Excavation
 N.B. 2029+00 - 2031+00
 N.B. 2031+00 - 2033+00

* TREATED TIMBER CURB
 ITEM 538
 N.B. 2040+00 - 2044+00 RT
 * THREE CABLE GUARD RAIL WITH LIGHT
 STEEL POSTS
 ITEM 538
 N.B. 2029+00 - 2030+60 LT
 N.B. 2029+00 - 2031+00 RT
 N.B. 2033+00 - 2044+00 RT

DRILLING AND BLASTING
 OF SOLID ROCK SUBGRADE
 ITEM 115
 S.B. 2029+00 - 2030+00
 S.B. 2033+00 - 2039+50
 N.B. 2031+00 - 2030+25
 N.B. 2031+22 - 2037+12

PROPERTY LINE FENCE
 MOD. ITEM 583-II
 N.B. 2029+00 - 2043+00
 S.B. 2029+00 - 2043+00
 SUBBASE OF SAND
 ITEM 202
 N.B. 2029+00 - 2030+25
 N.B. 2032+00 - 2037+00

* Stage II Construction

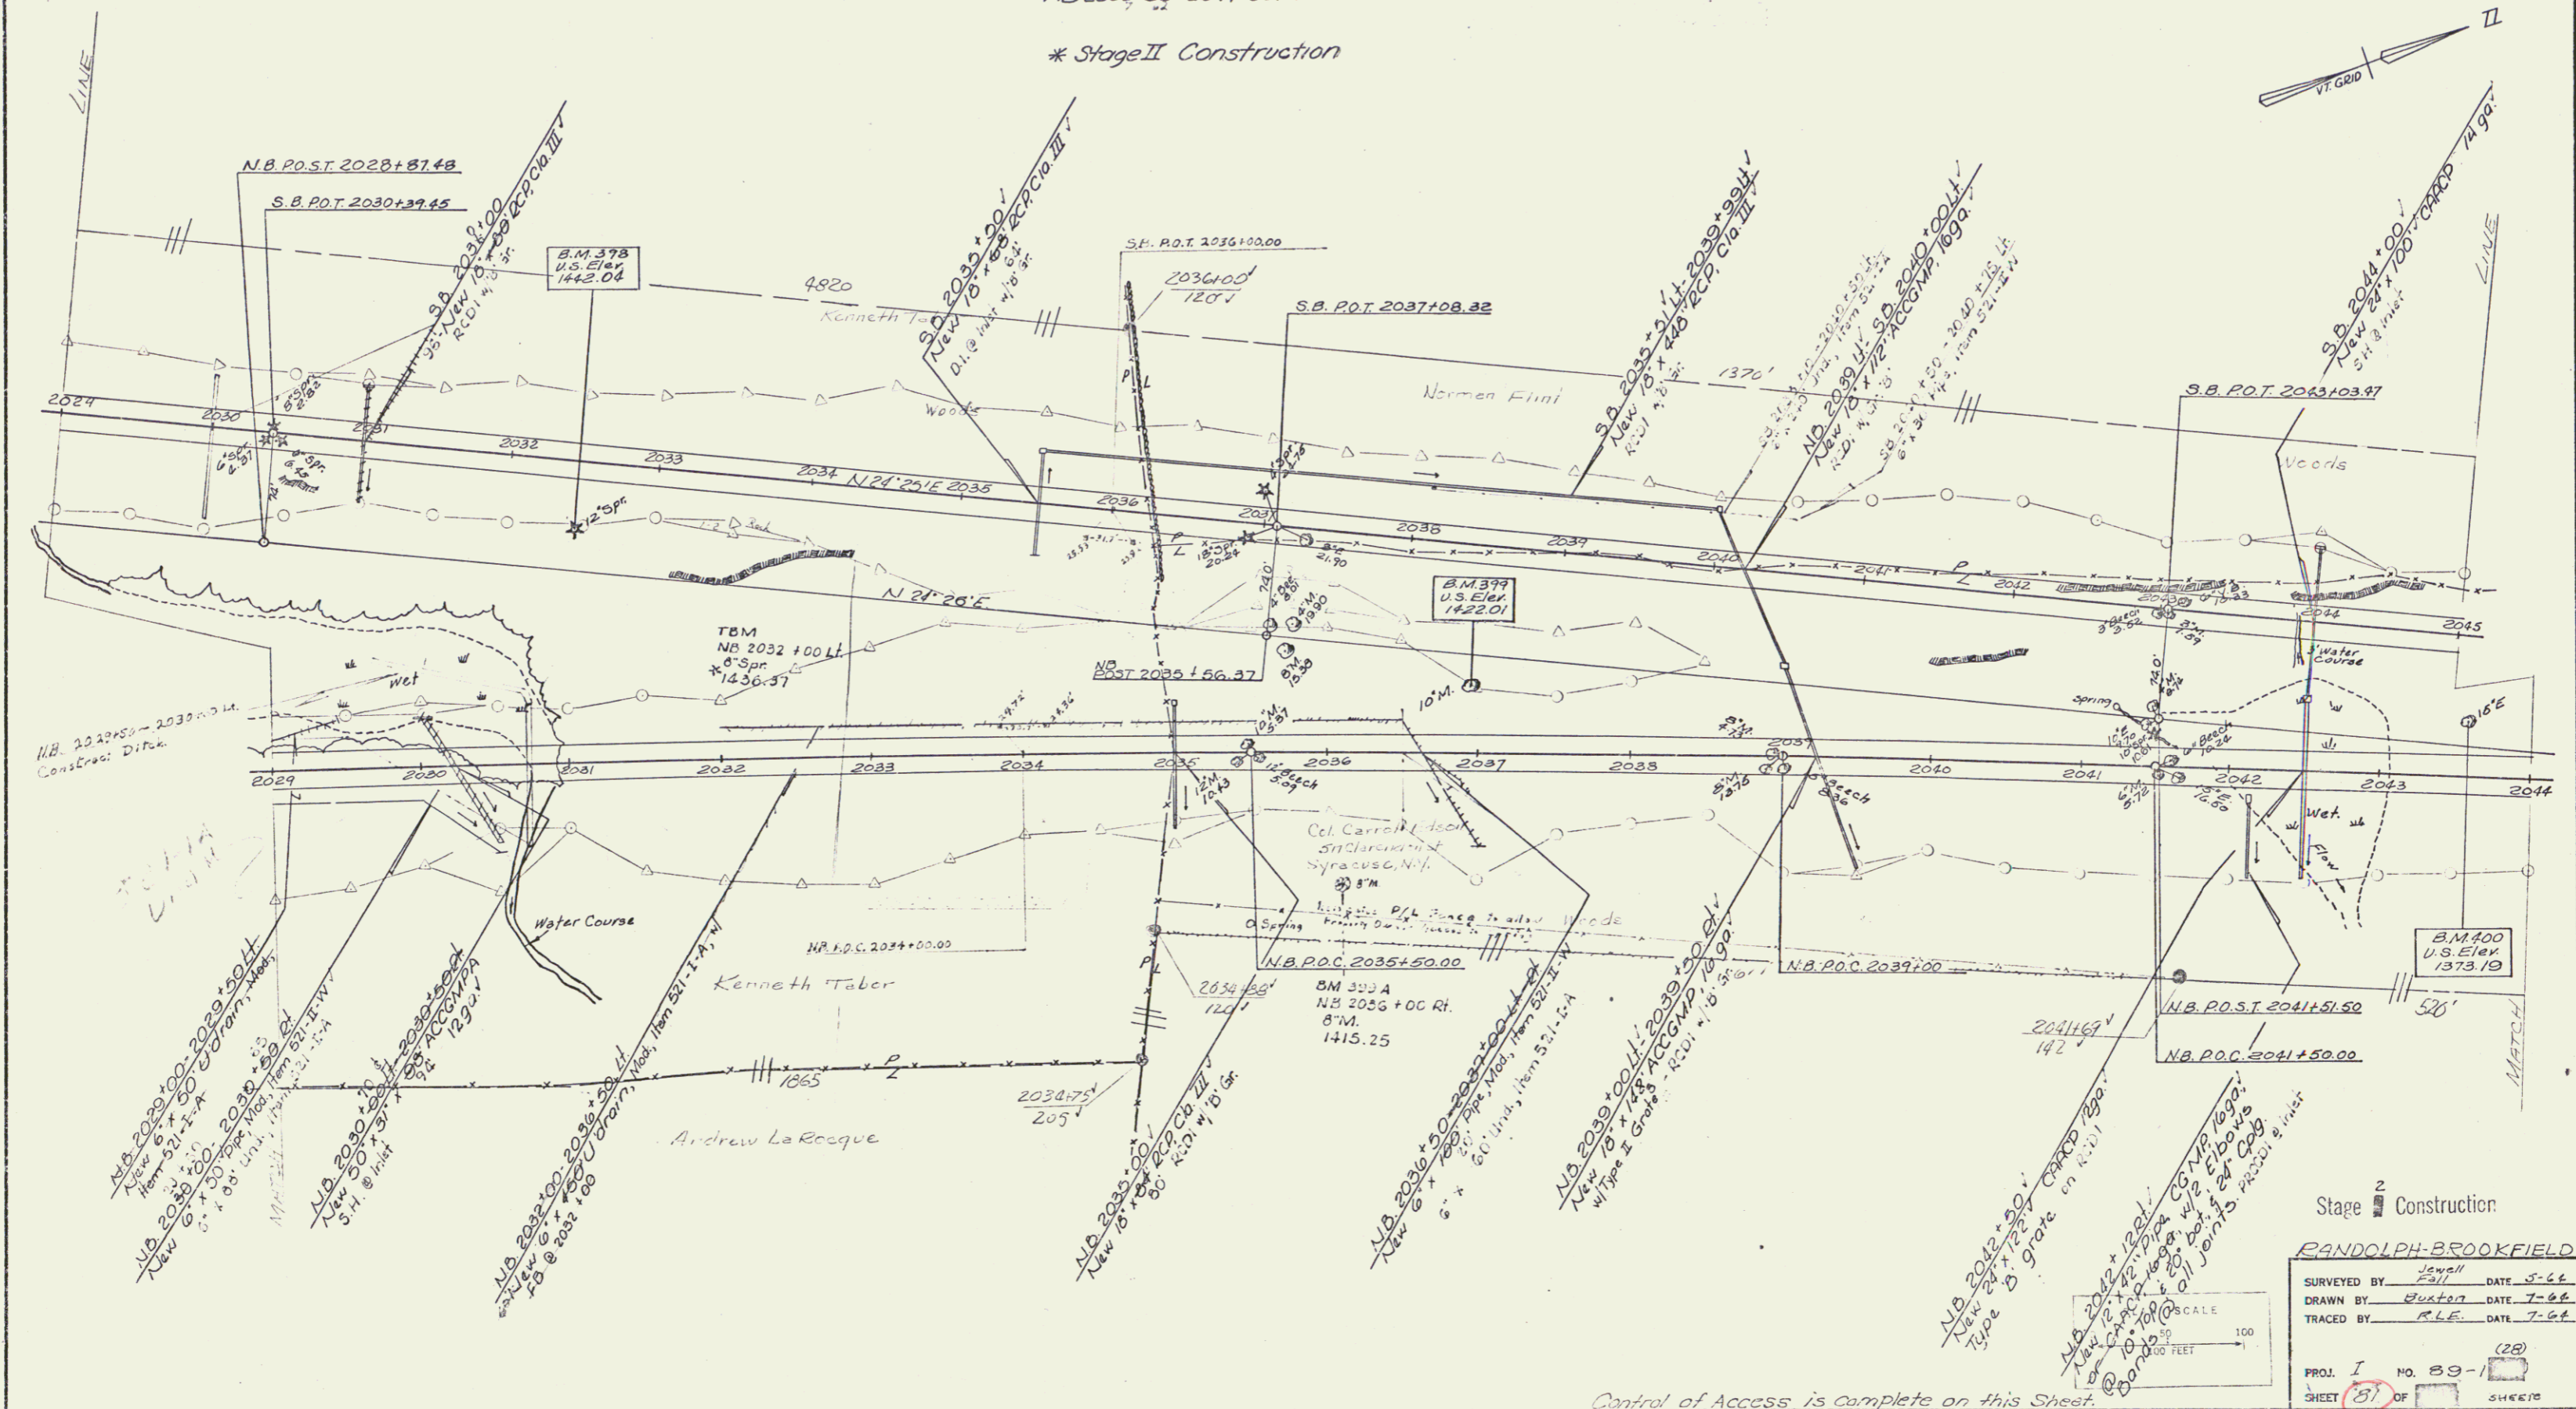

Control of Access is complete on this Sheet.

Stage II Construction

RANDOLPH-BROOKFIELD

SURVEYED BY Jeyell DATE 5-64
 DRAWN BY Buxton DATE 7-64
 TRACED BY R.L.E. DATE 7-64

PROJ. I NO. 89-1
 SHEET 87 OF 155 SHEETS

Sheet 87 of 155 Sheets