


* THREE CABLE GUARD RAIL WITH LIGHT STEEL POSTS, ITEM 533
NB 2044+00 RT - 2045+00 RT
NB 2051+00 - 2053+10 RT
SB 2052+00 - 2053+00 RT

MUCK EXCAVATION
ITEM 117
SB 2051+50-2052+50
NB 2045+00 - 2048+00
NB 2049+75 - 2051+50 *Stage 2 Construction
NB 2052+64 - 2053+75

* TREATED TIMBER CURB Item 558
NB 2044+00 - 2045+00 RT

PROPERTY LINE FENCE, MOD.
ITEM 533-II
NB 2045+00 - 2055+00
SB 2045+00 - 2055+00

MAINTENANCE TURN
SB 2050+00 RT
+1+30

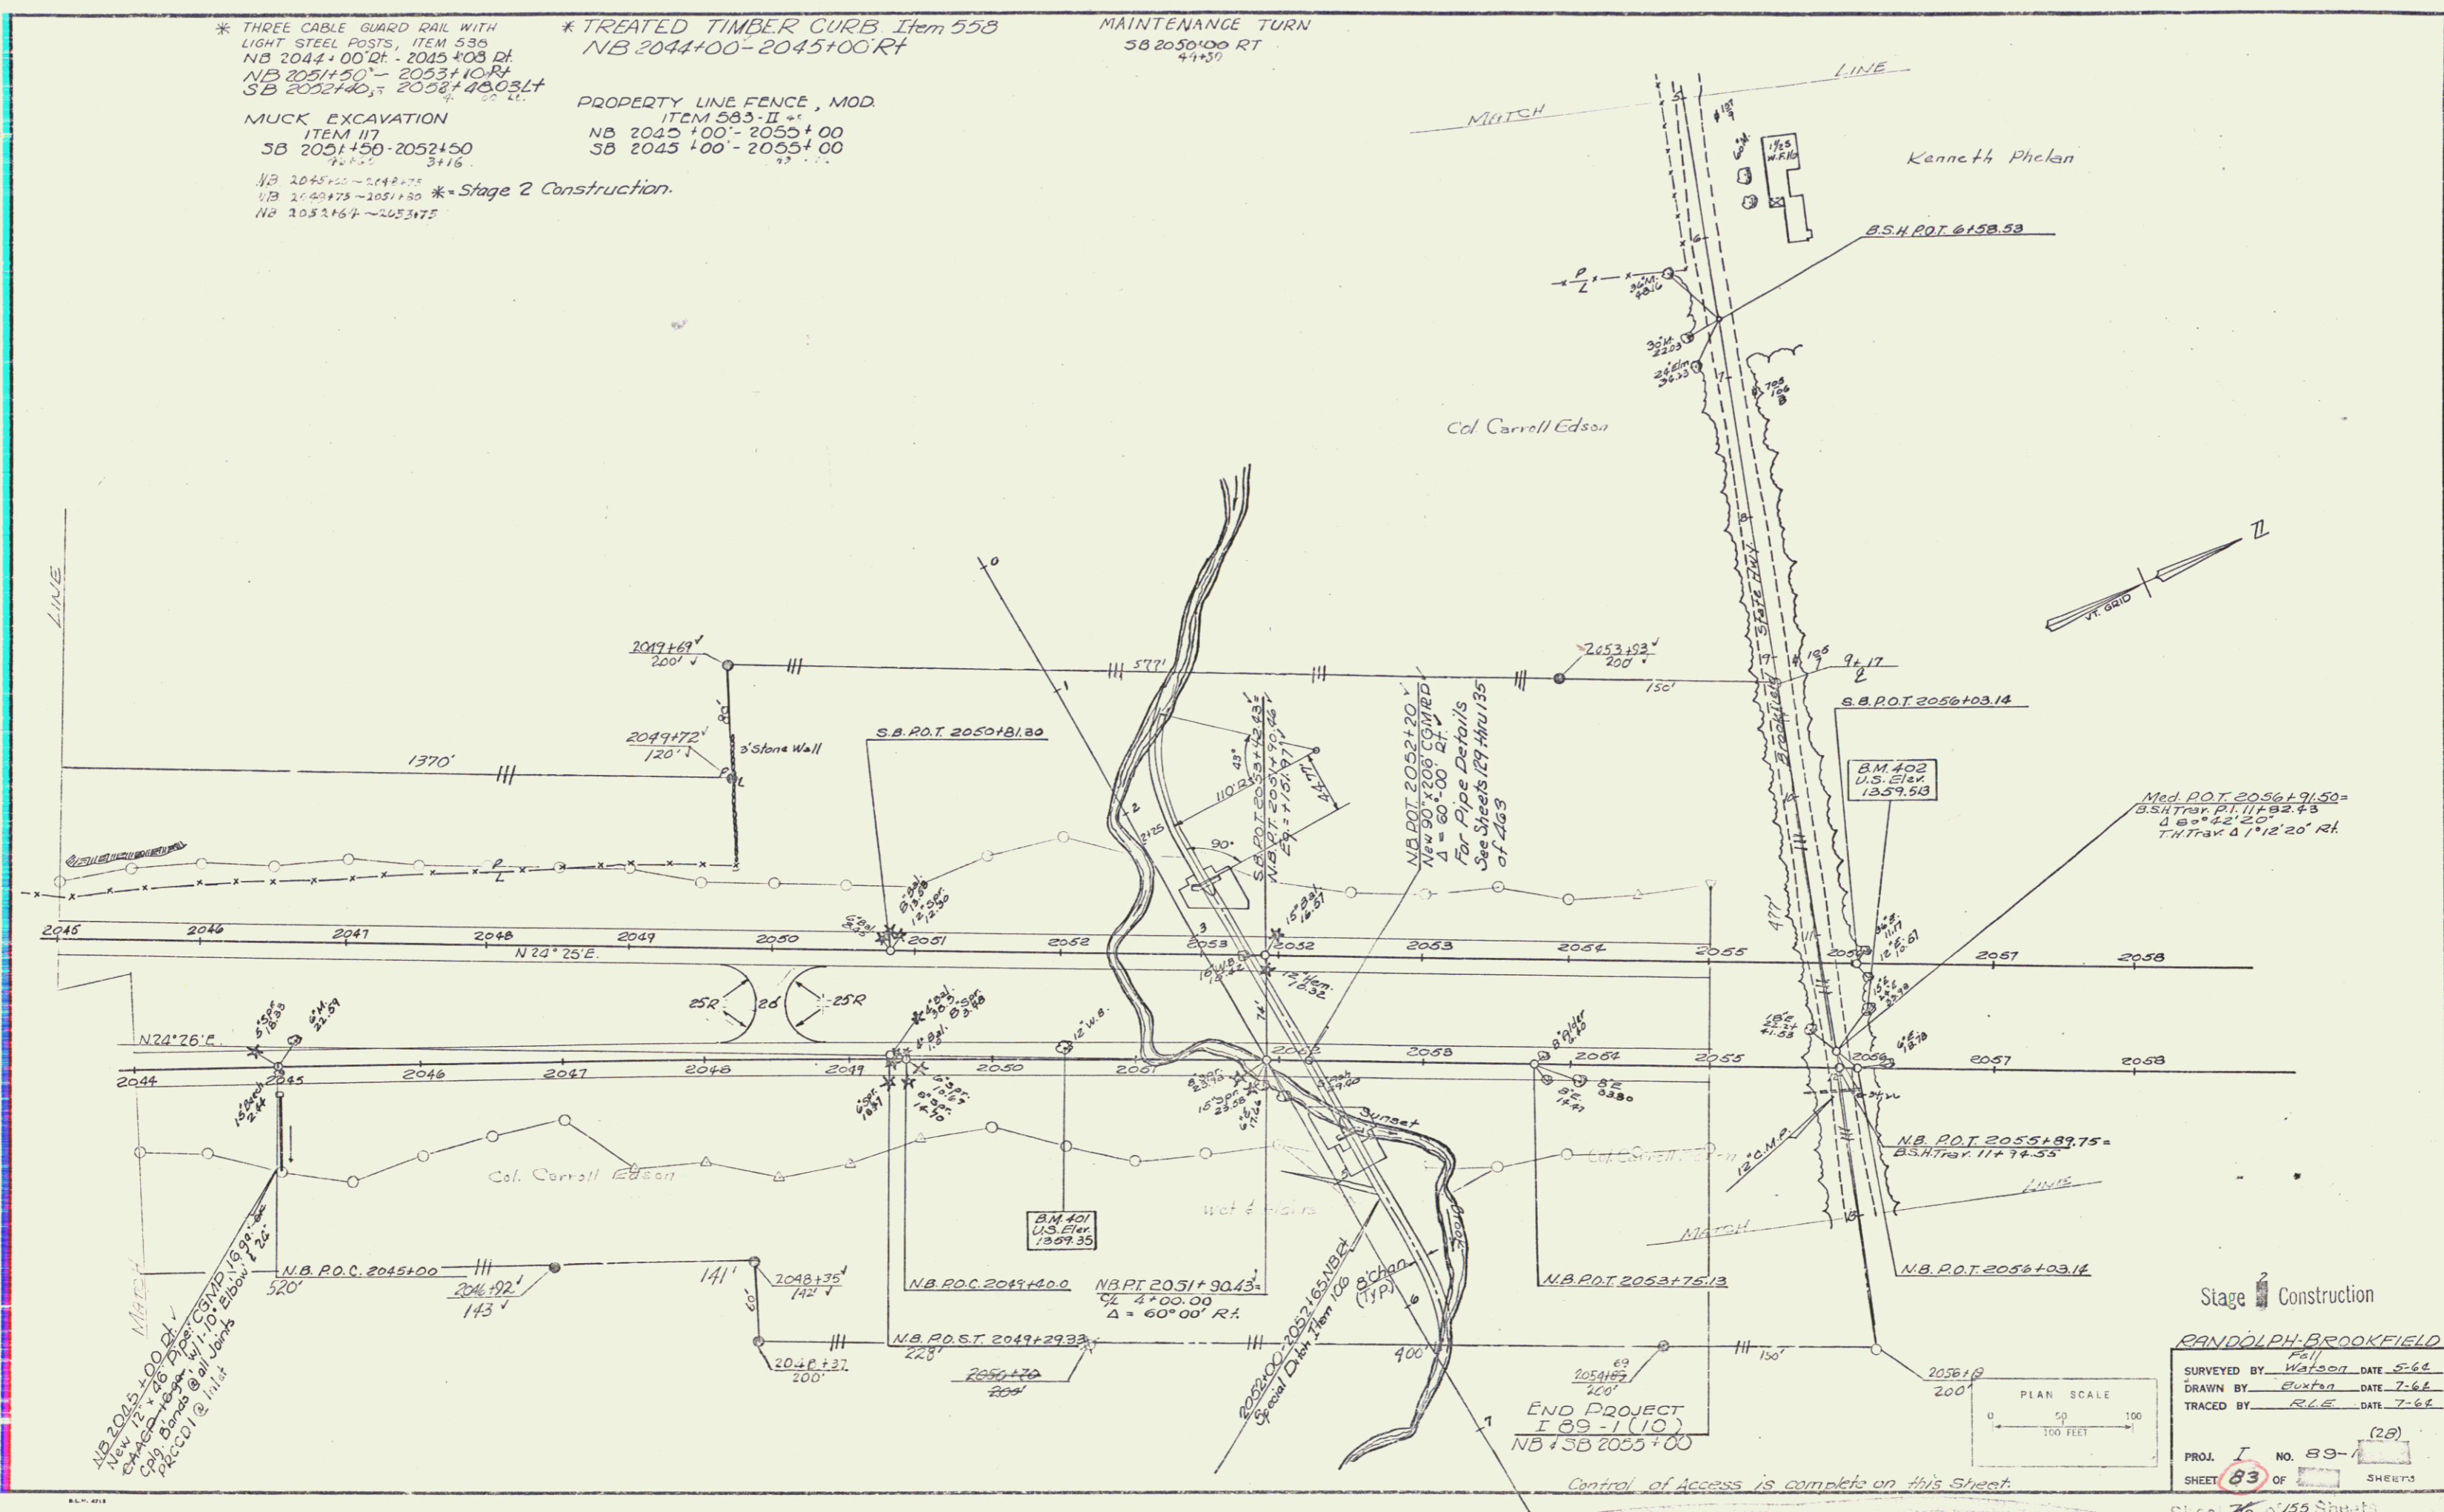

NB 2045+00 RT
New 12' x 12' Box
Cable Guard Rail
Cable
Placed @ 10' Int.
@ 10' Int.

END PROJECT
E 89-1(10)
NB + SB 2055+00

Control of Access is complete on this Sheet.

Stage 2 Construction

RANDOLPH BROOKFIELD
RAIL

SURVEYED BY Watson DATE 5-66
DRAWN BY Euxton DATE 7-66
TRACED BY RLE DATE 7-66

PROJ. NO. 89-1(10)
SHEET 83 OF 155 SHEETS

Scale 76 of 155 Sheets