


TWO CABLE GUARD RAIL ITEM 541  
 8+37 - 9+03 LT  
 9+33 - 9+47 RT  
 10+44 - 12+08 LT RT  
 10+54 - 12+08 RT LT  
 13+50 - 17+58 LT  
 13+64 - 17+58 RT

CONSTRUCT DRIVE  
 17+81 RT  
 19+50 LT

Δ 12° 40' RT  
 D 6'  
 T 95.193  
 L 106.0  
 E 271.1  
 S 85  
 Bank 1/2" per Ft.

Stage 1 Construction

RANDOLPH-BROOKFIELD  
 TOWN ROADS 26 & 24

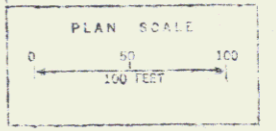

SURVEYED BY: *Lorrelles* DATE: *10/68*  
 DRAWN BY: *Evans* DATE: *11/68*  
 TRACED BY: *Evans* DATE: *11/68*

PROJ. T. NO. 59-1(10)  
 SHEET 38 OF 163

T.H. 24 & T.H. 26 to be built in their entirety during Stage 1 Construction.