


Construct Drive (R.O.W. Bid Item)
SA #6 29+92 Rt.

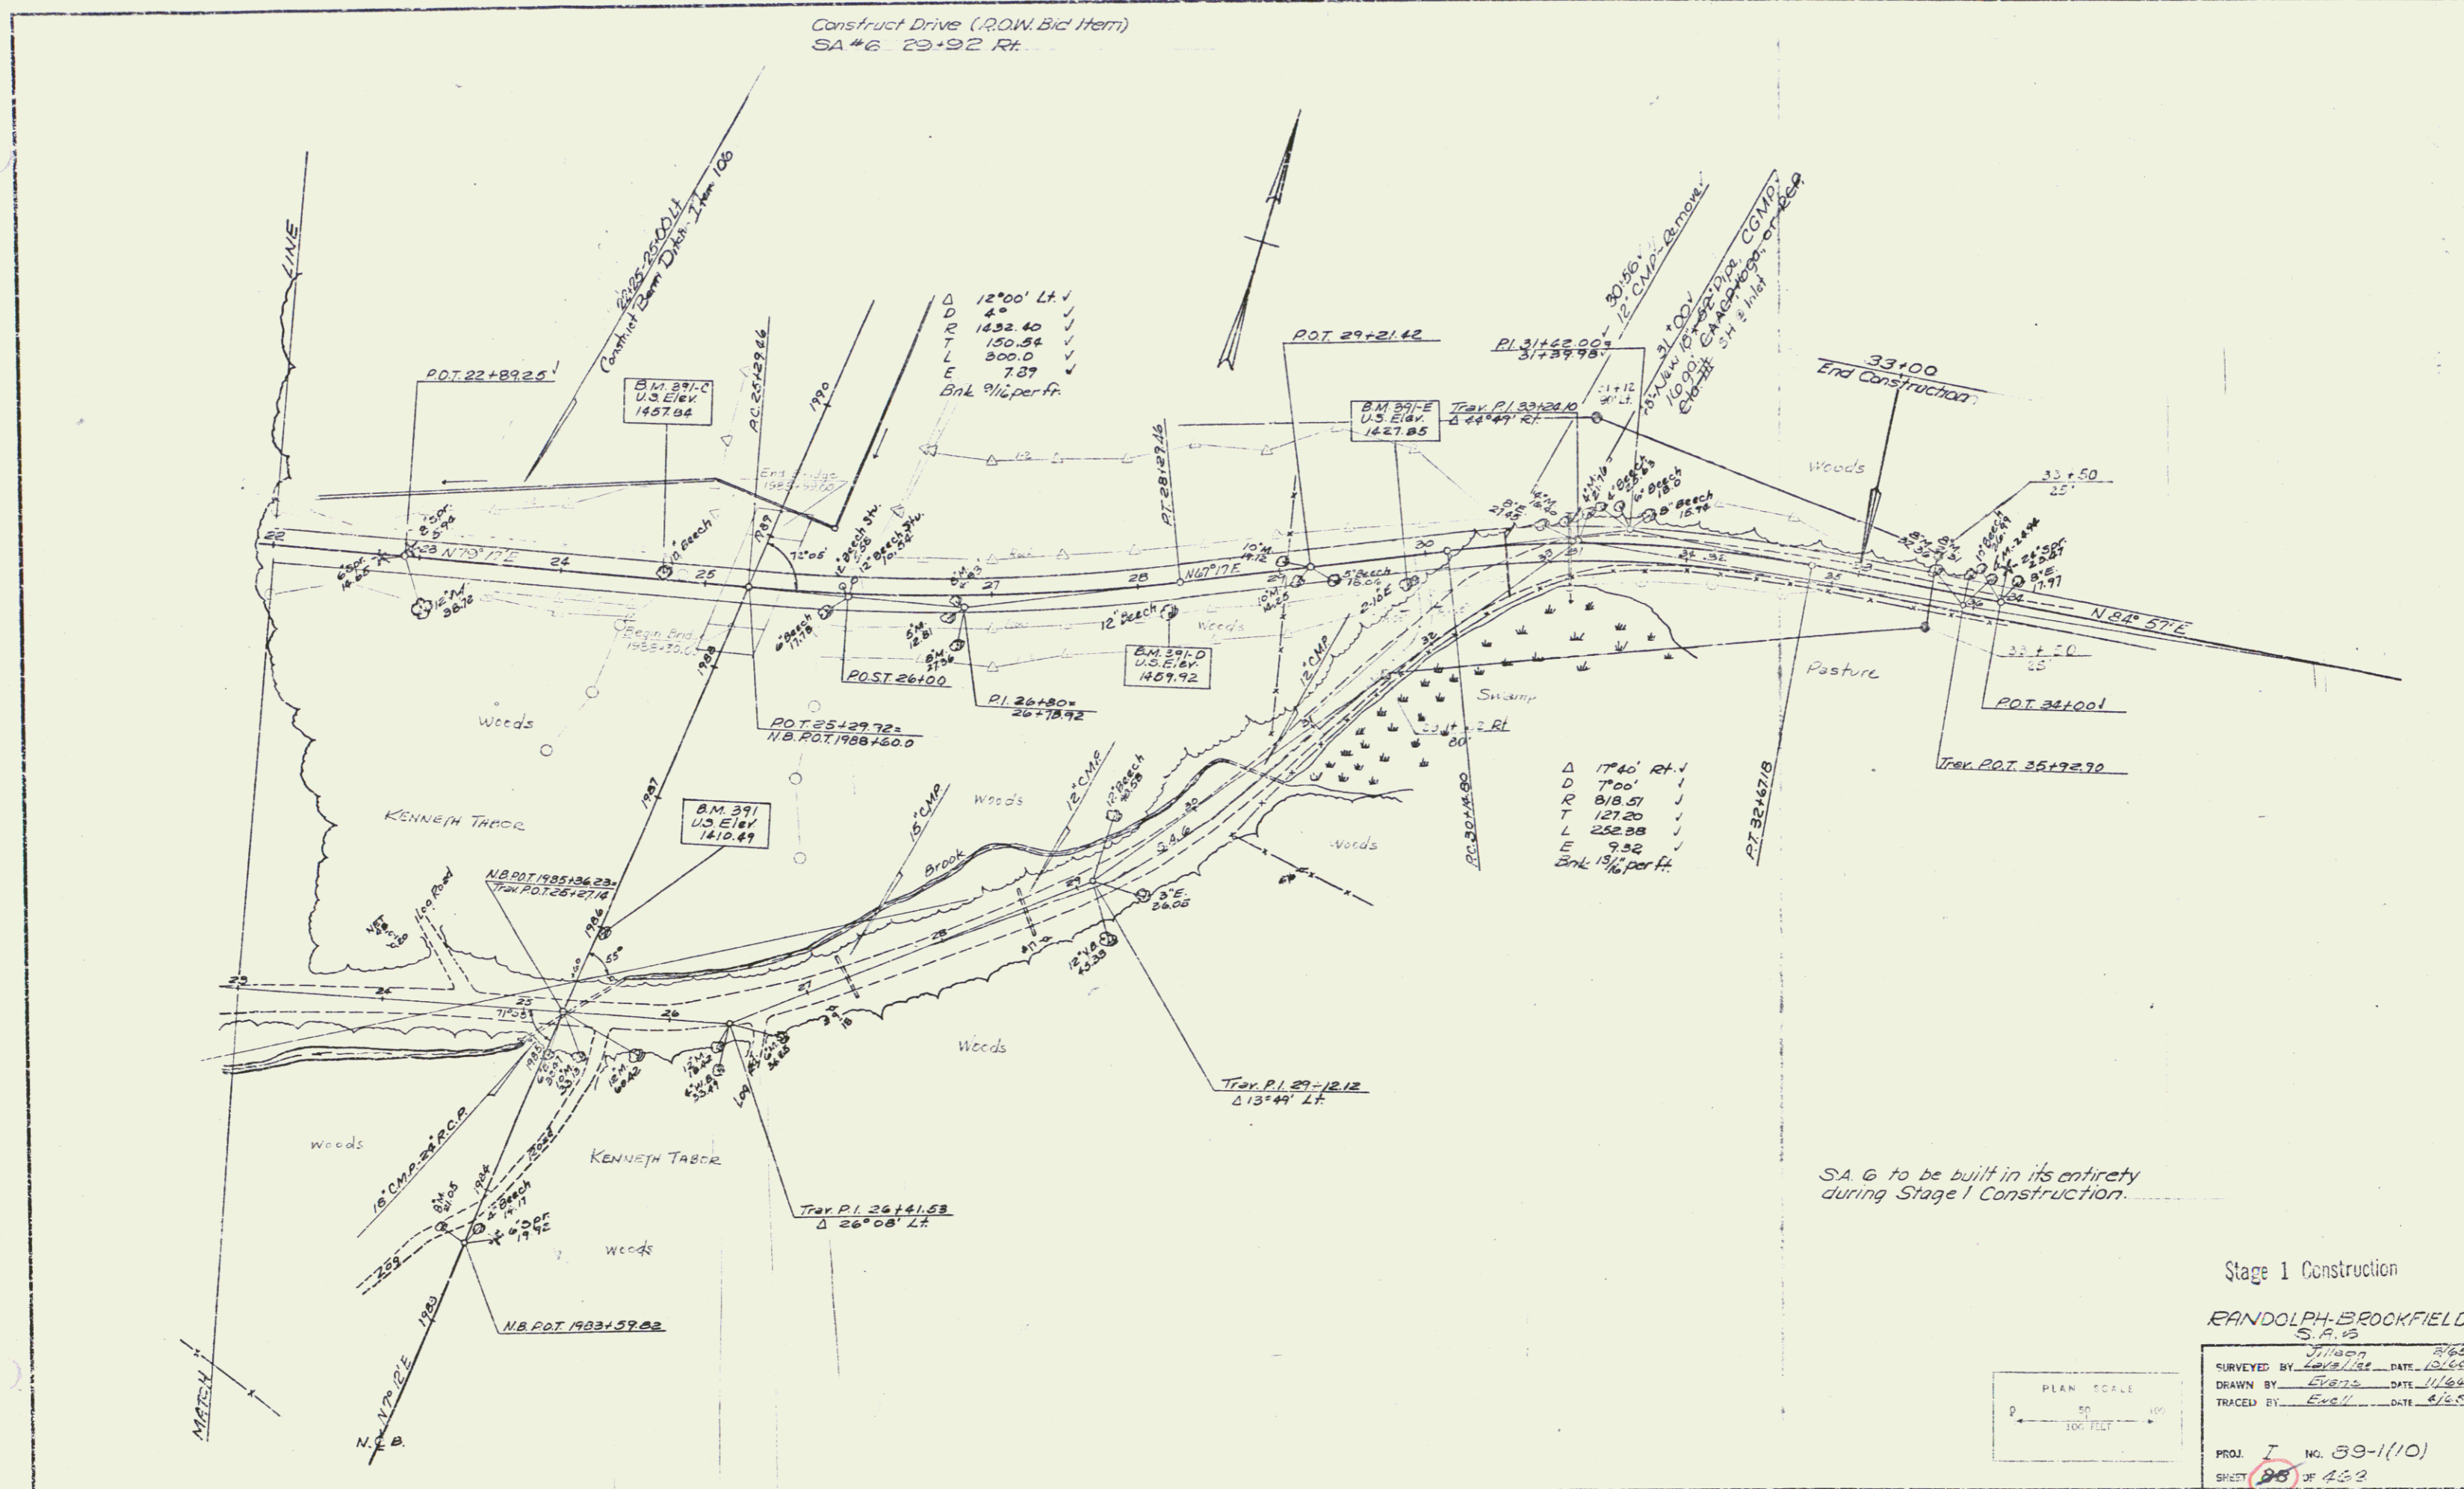


SA 6 to be built in its entirety during Stage 1 Construction.

Stage 1 Construction

RANDOLPH BROOKFIELD
S.A. 6

SURVEYED BY: *J. Wilson* DATE: *8/65*
DRAWN BY: *Evans* DATE: *11/64*
TRACED BY: *Evans* DATE: *8/65*

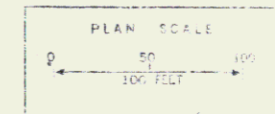

PROJ. *I* NO. *39-1(10)*
SHEET *26* OF *433*