


NOTES STAGE 2 ITEMS

July Meeting
Item 5.3
2070+00-2072+50 Median
2071+50-2074+00 Median
2077+50-2078+50 Median

PROPERTY LINE FENCE	
WITH STAKE 5075	
ITEM 5B3+2 W/D	
ST	100'
WEST SIDE	
2070+00	2075+00 1 ST
SOUTH SIDE	
2071+00	2074+00 1 ST

SB 2076+00-2077+00
 SB 2078+50-2080+00
 SB 2081+50-2085+00
 NB 2078+00-2081+00

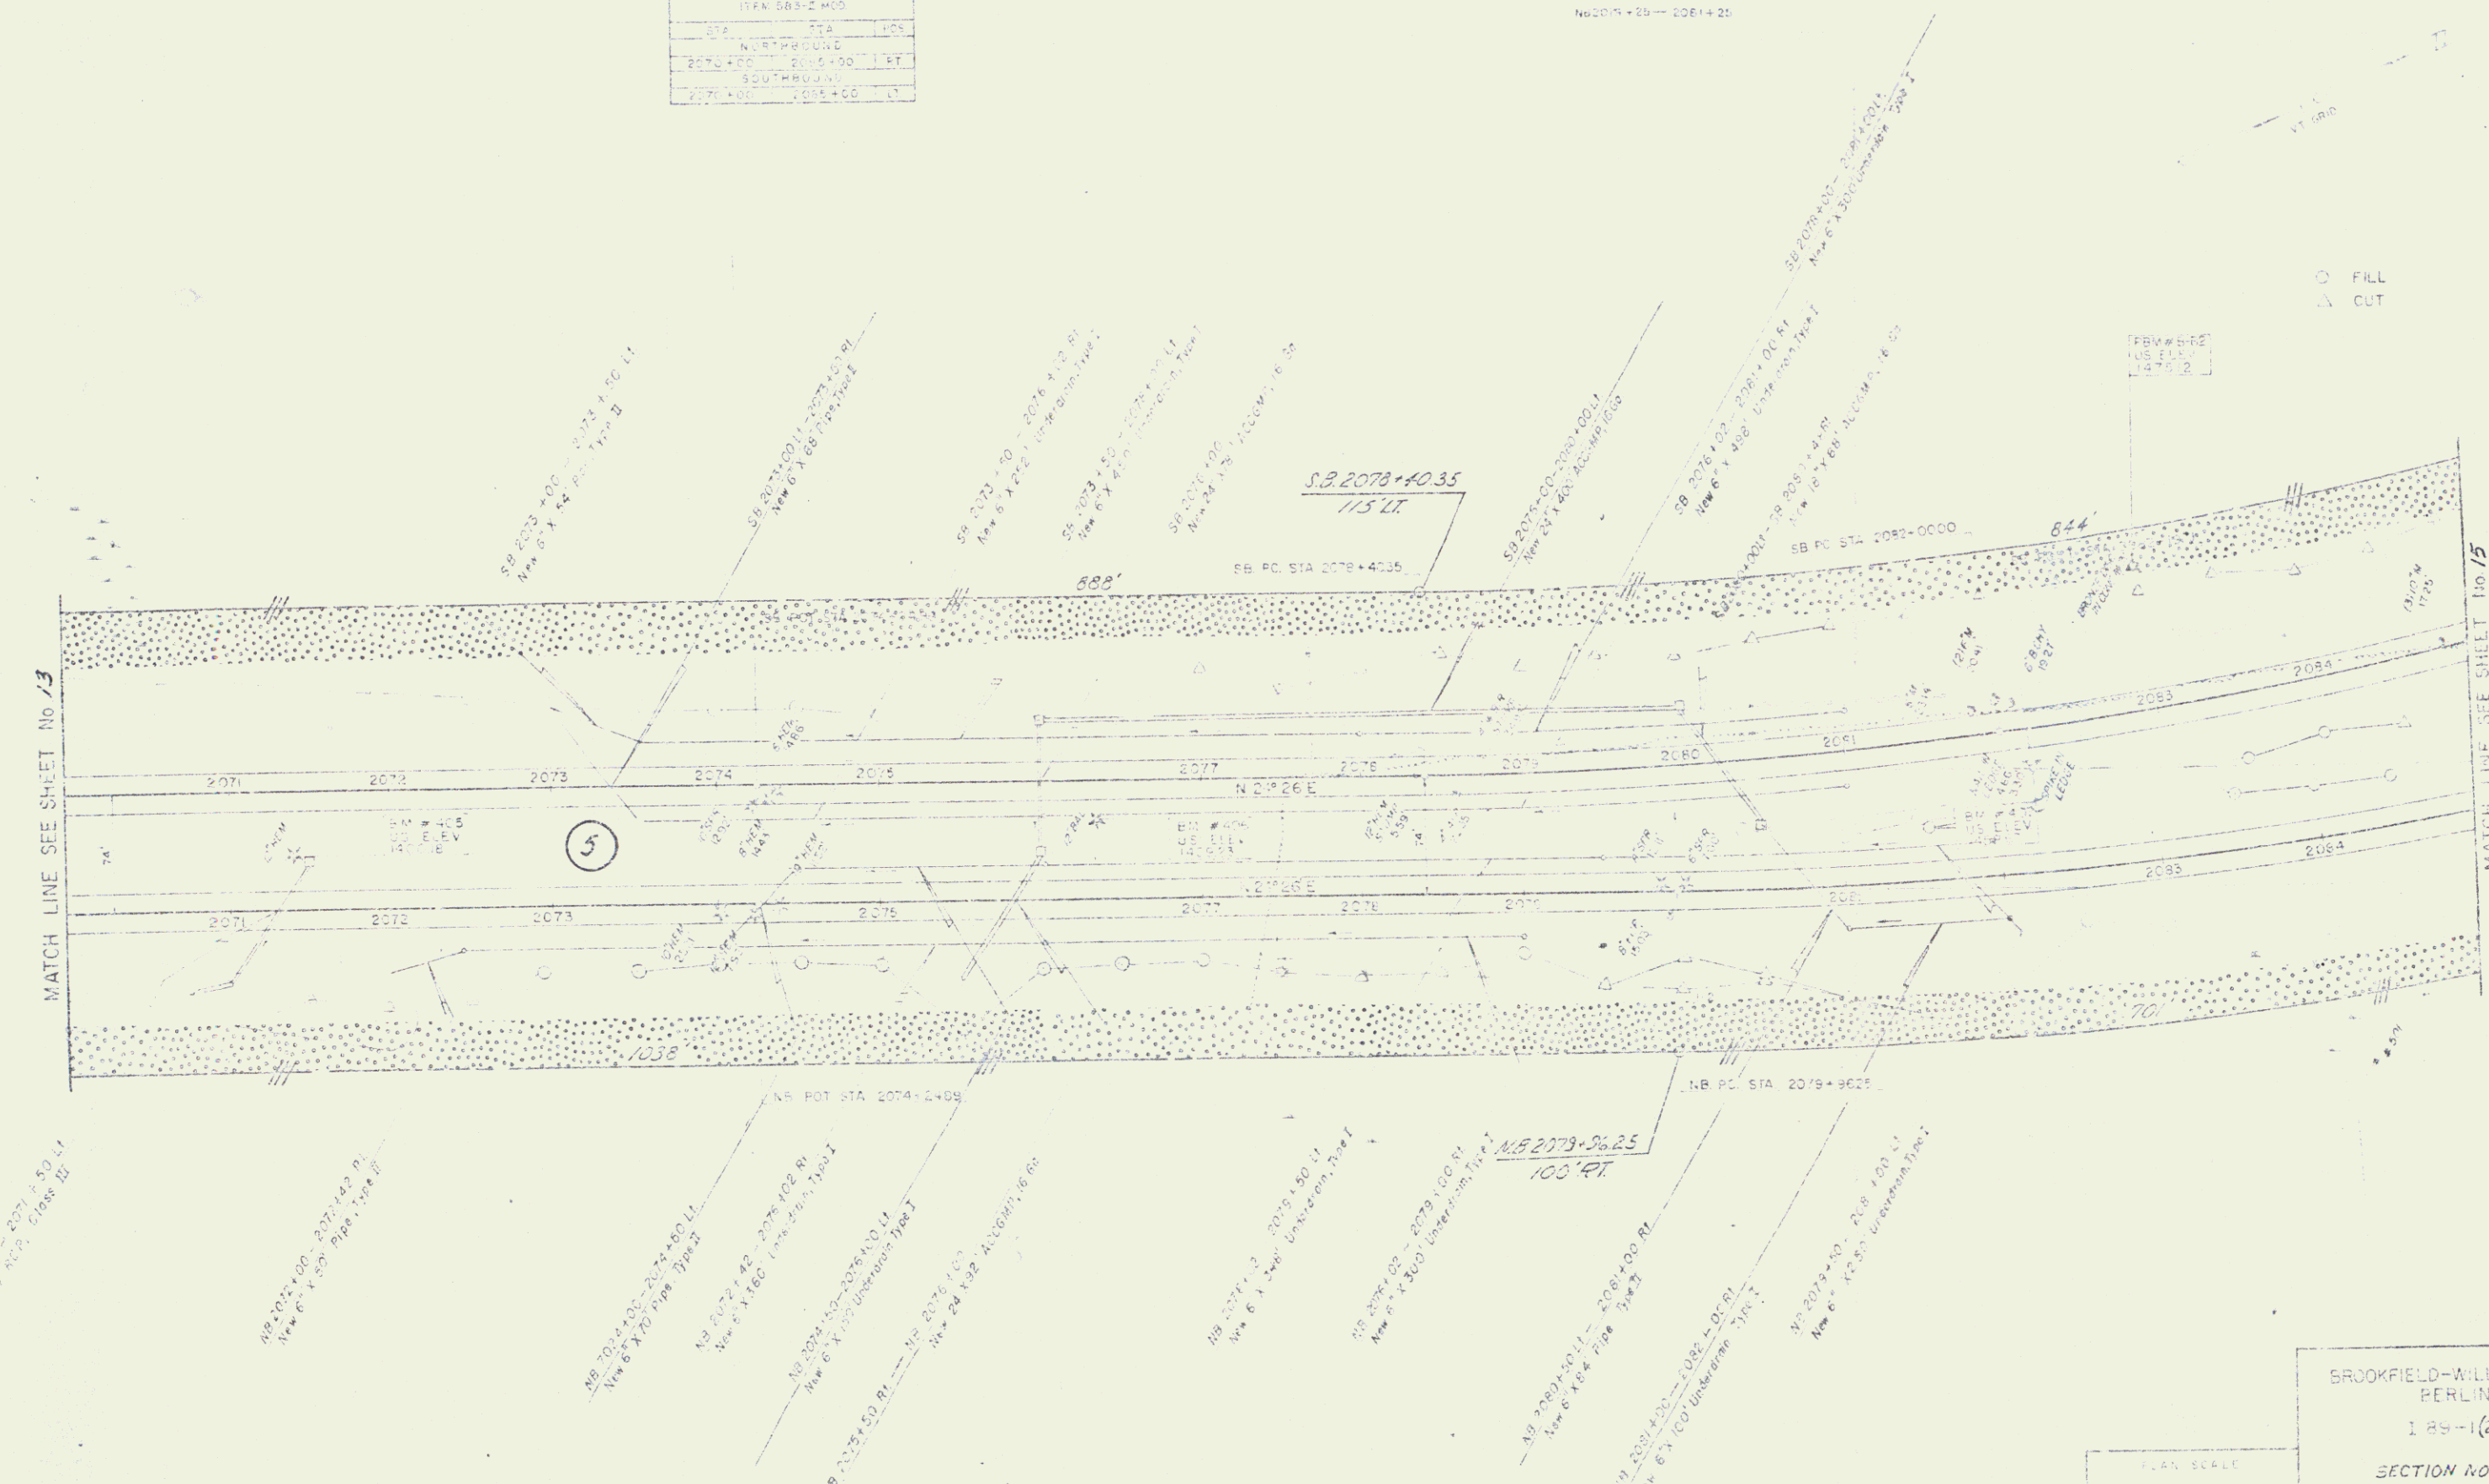

MATCH LINE SEE SHEET No. 13

MATCH LINE SEE SHEET No. 15

PORTER, GIBSON & COMPANY
CONSULTING ENGINEERS

CONTROL OF ACCESS IS COMPLETE ON THIS SHEET



BROOKFIELD-WILLIAMSTOWN
 PERLIN
 189-1(20)
 SECTION NO. II
 SHEET 14 OF 90