


STA	ST	TYPE
2085+00	2085+00	RT
2085+00	2085+00	RT
Drawn by: [Name] Scale: 1" = 40'

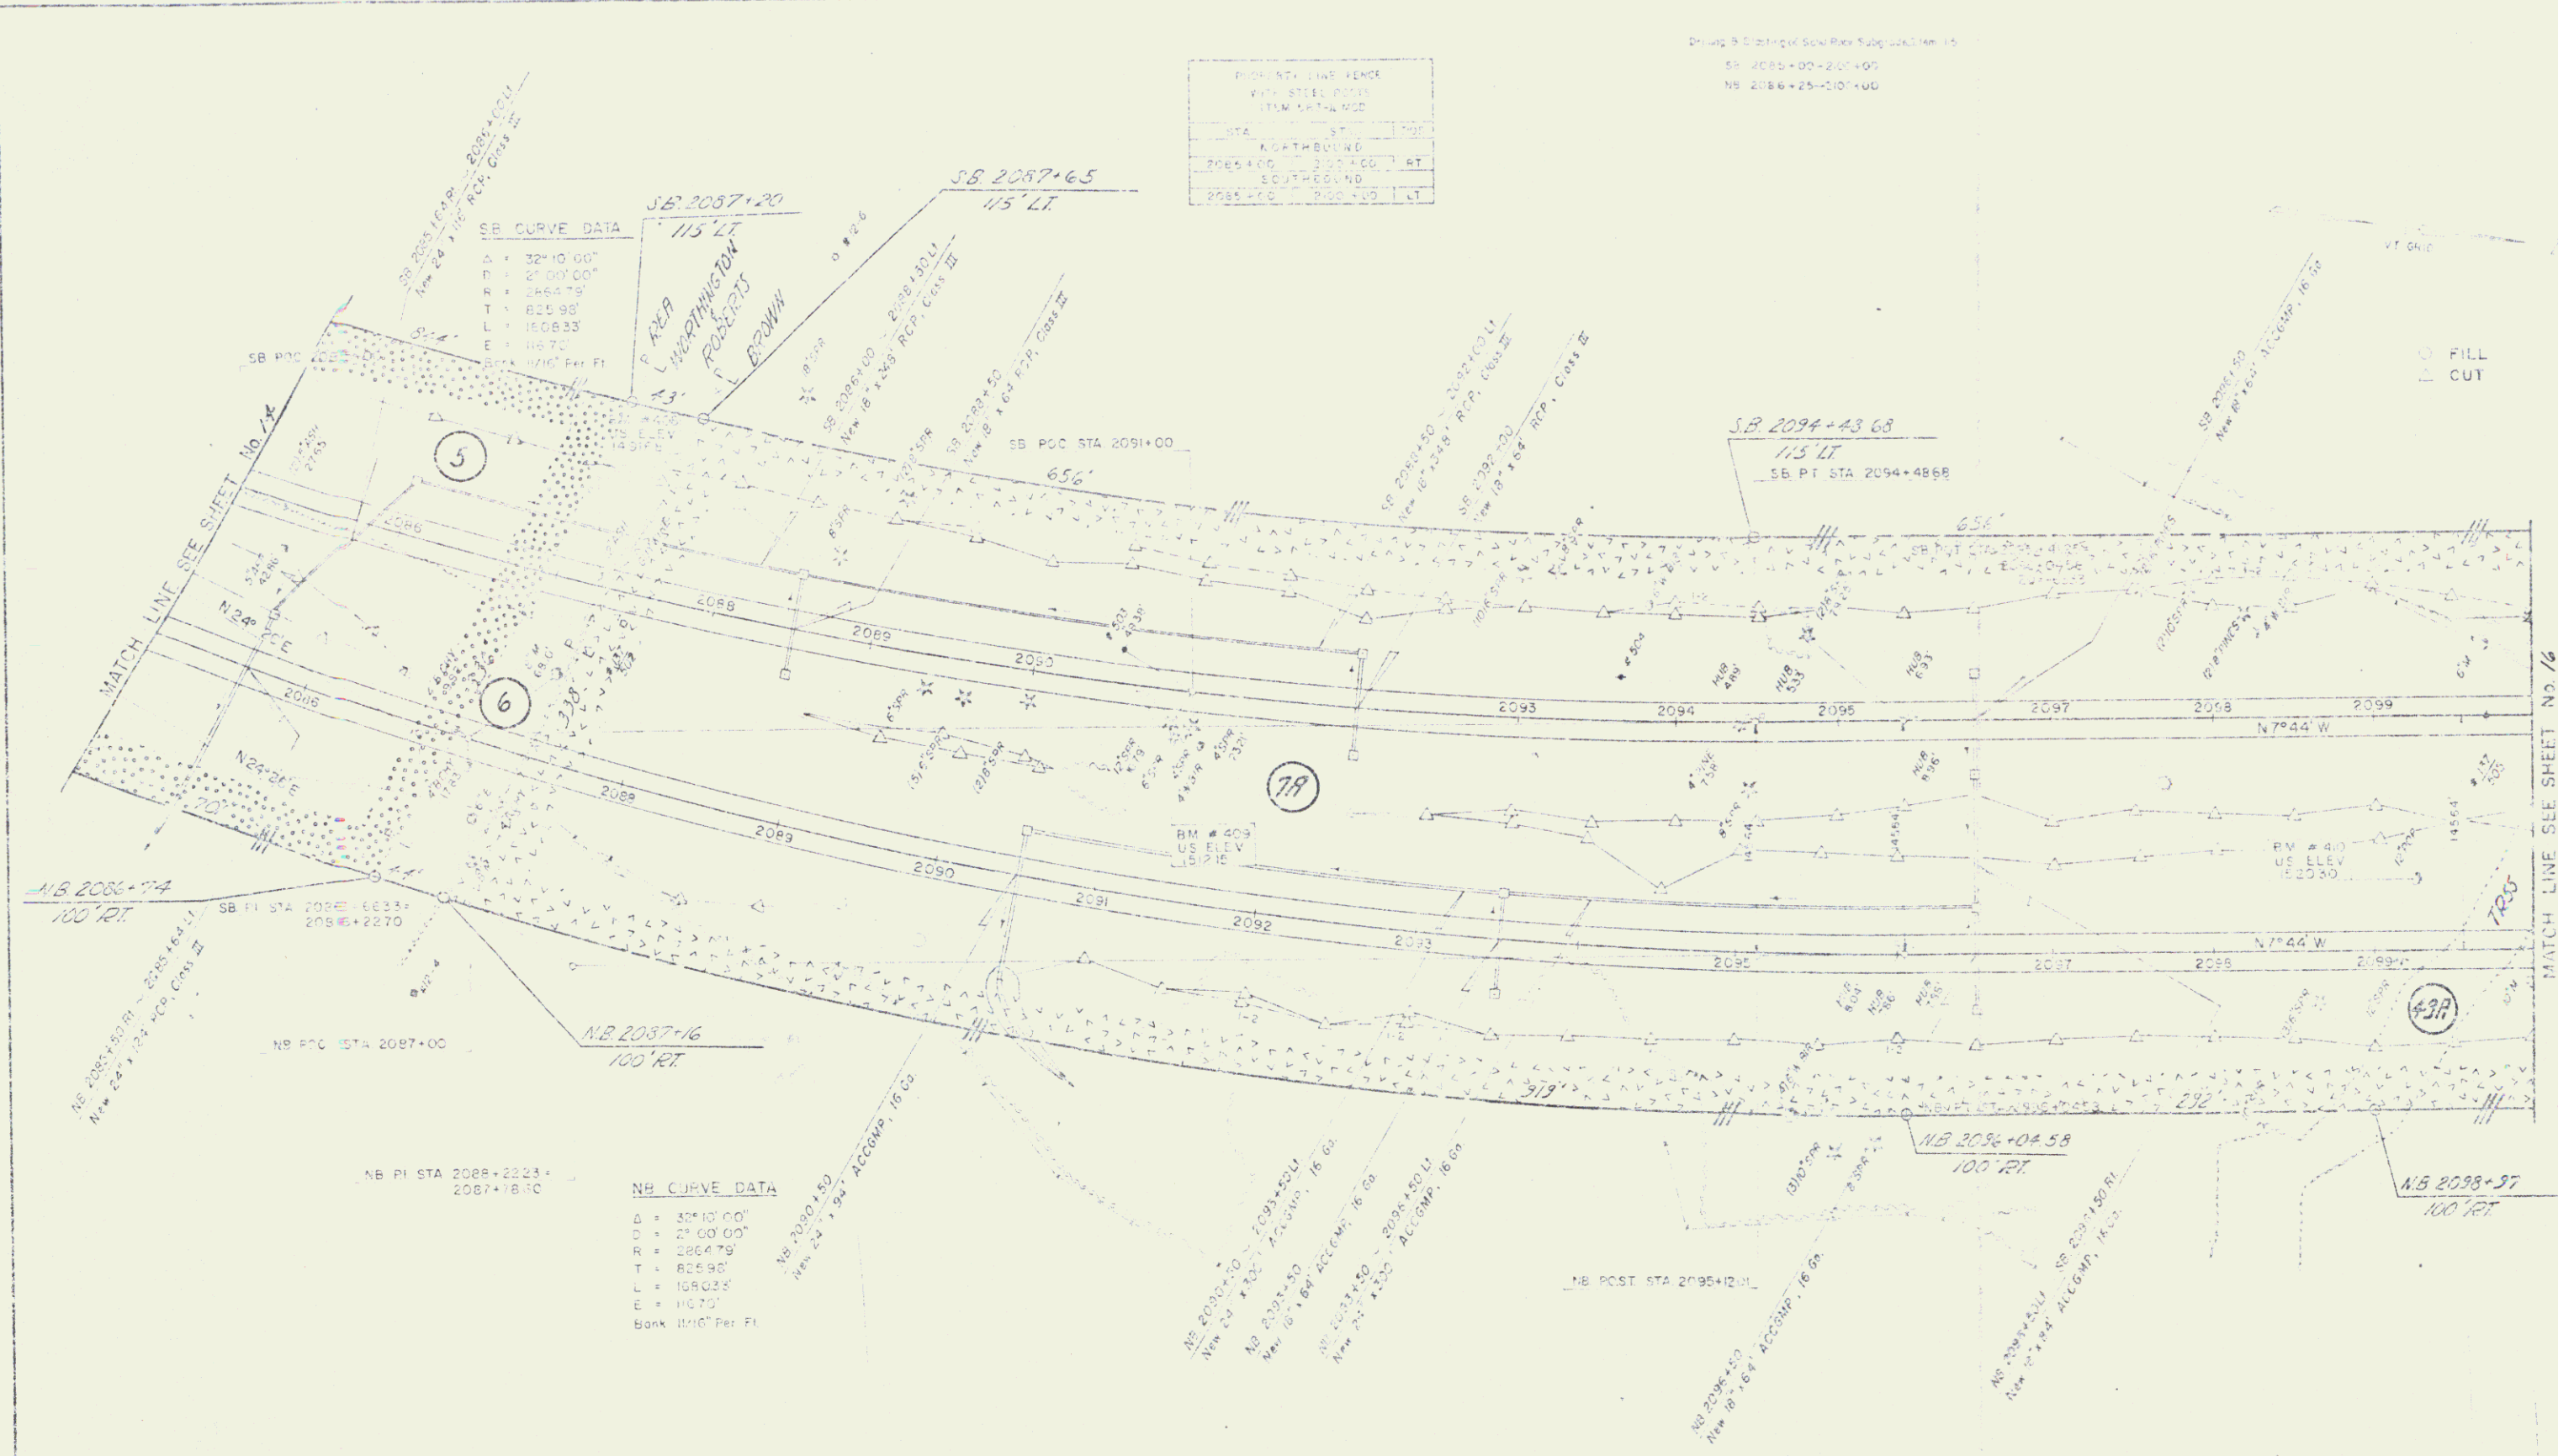

BROOKFIELD-WILLIAMSTOWN
BERLIN
I 69 -1 (20)
SECTION NO. 1
SHEET 15 OF 32