

■ DENOTES STAGE 2 ITEMS

■ Three Cable Guard Rail
w/LS Posts
Item 358
39-48
NB 2129+02 - 2142+00 RT.
NB 2139+87.7 - 2142+00 LT.
SB 2129+00 - 2142+00 RT.
SB 2139+87.7 - 2142+00 LT.


PROPERTY LINE FENCE WITH STEEL POSTS ITEM 583-3 MOD.		
STA.	STA.	POS.
NORTHBOUND		
2129+00	2142+00	RT.
SOUTHBOUND		
2129+00	2142+00	LT.

Construct U-Turn Median Opening
NB 2138+50 - 12' LT.
SB 2138+50 - 12' RT.

Drilling & Blasting of Solid Rock Subgrade, Item 115
SB 222+00 - 2138+50
NB 222+00 - 2138+50
75



○ FILL
△ CUT

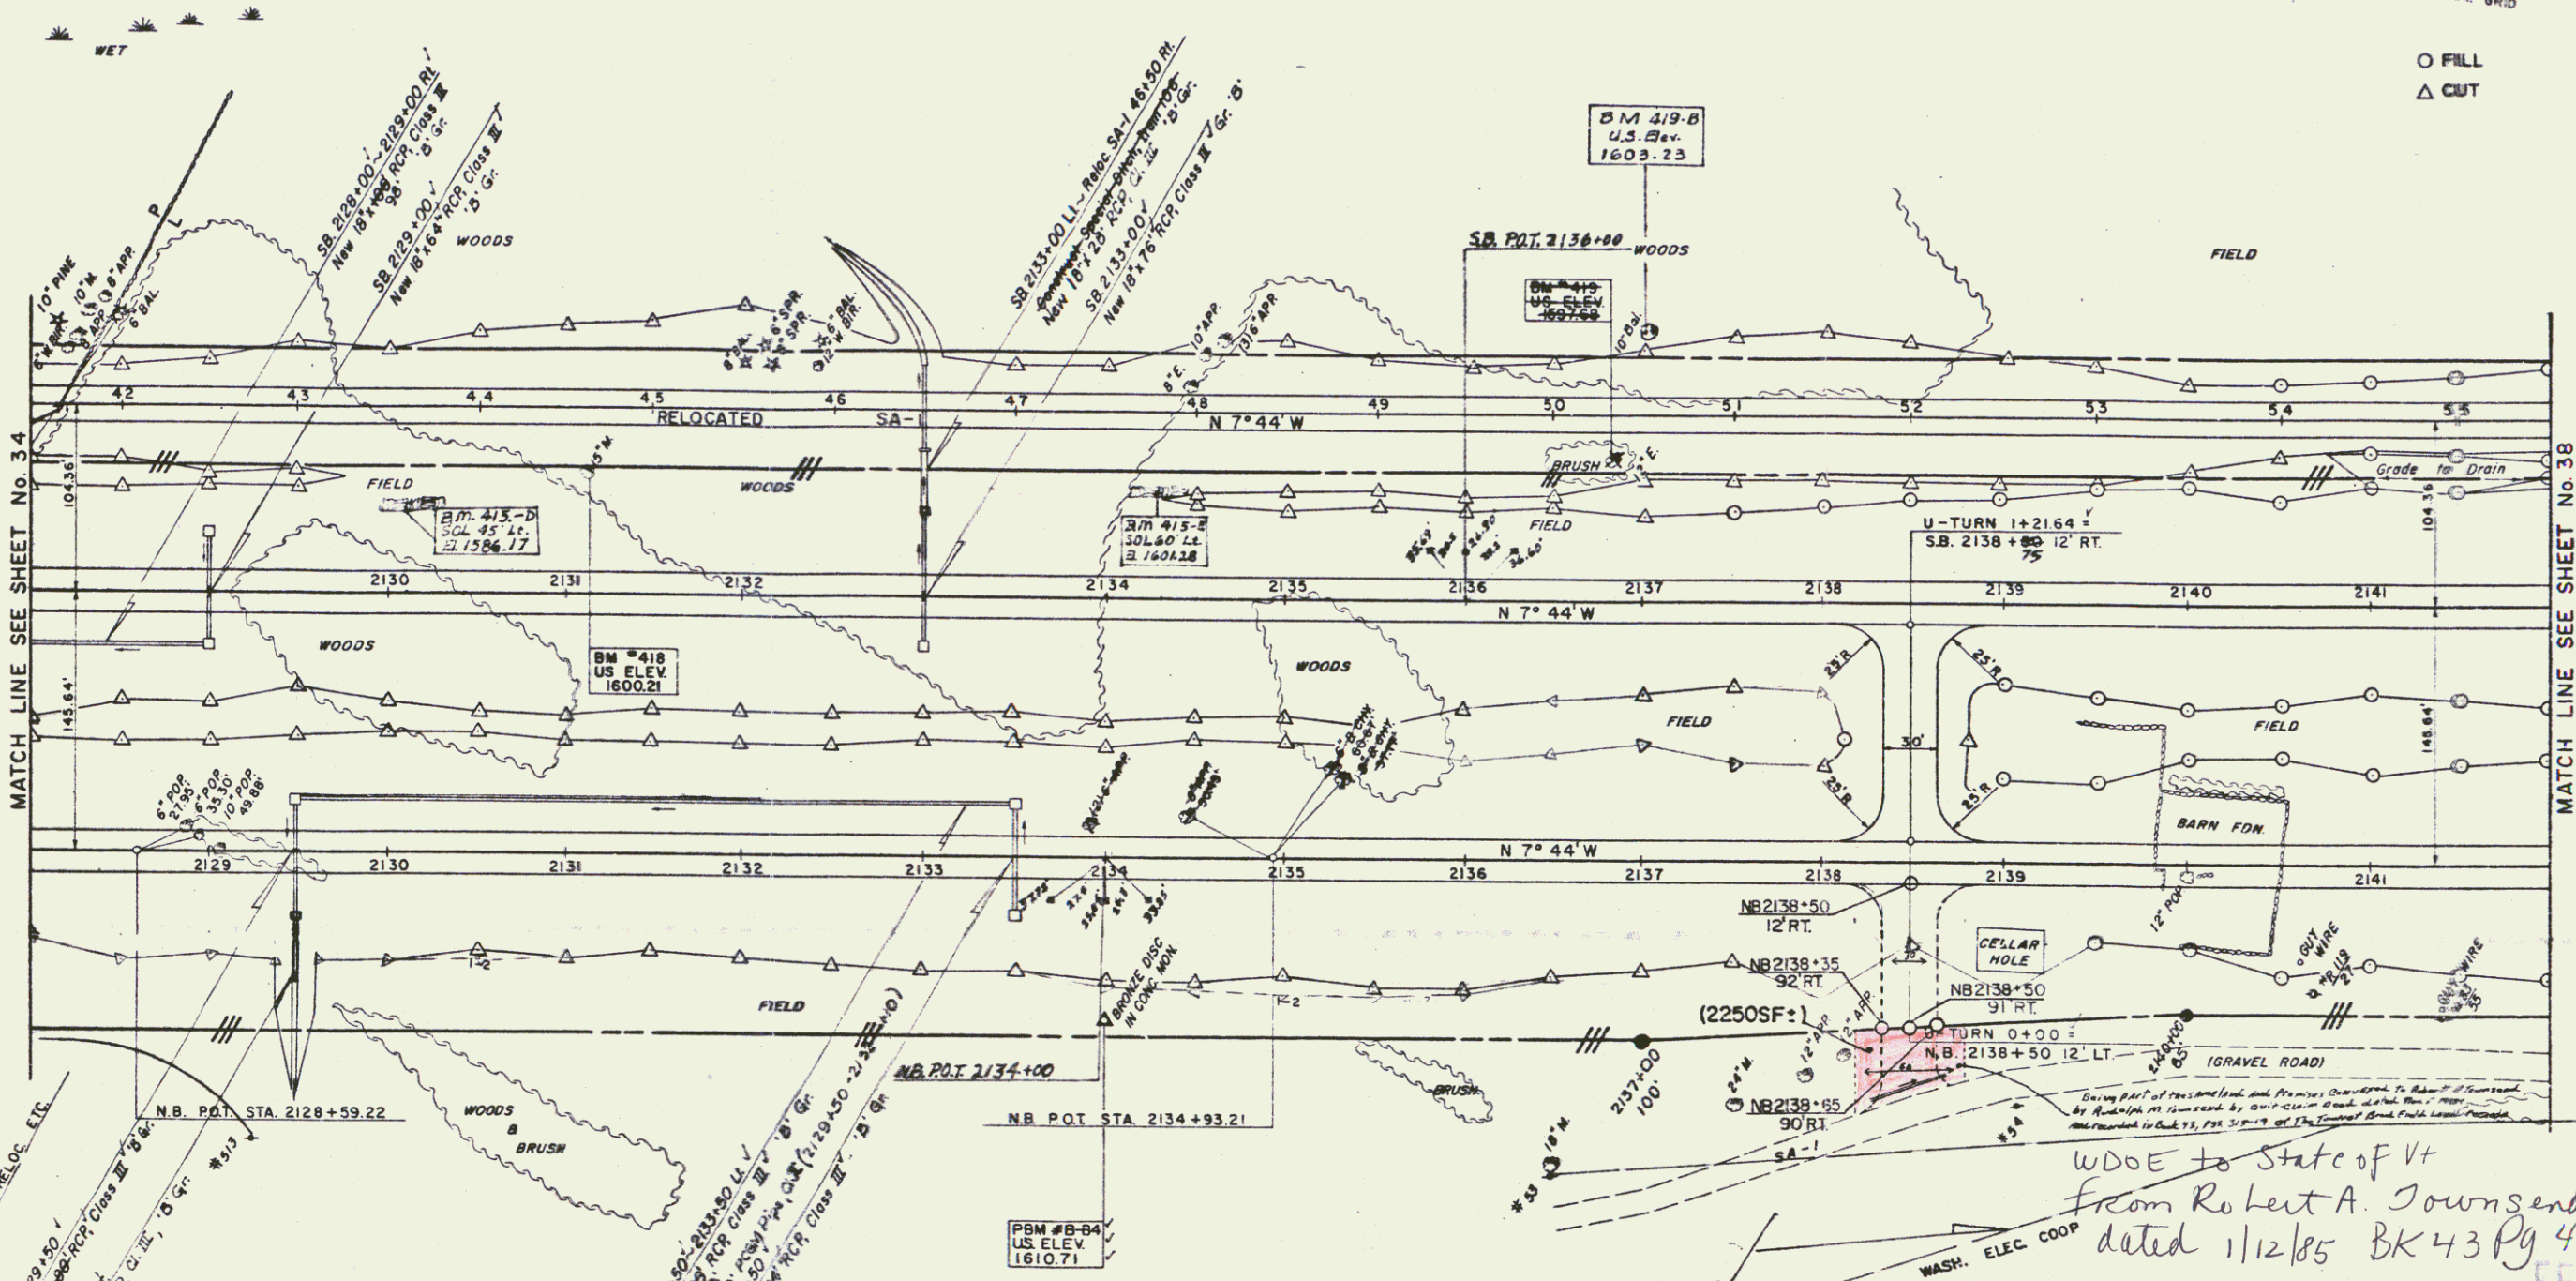

MATCH LINE SEE SHEET No. 34

MATCH LINE SEE SHEET No. 38

PORTER, O'BRIEN & ARMSTRONG
CONSULTING ENGINEERS NEWARK, N.J.

FOR PLAN AND PROFILE OF
RELOCATED SA-1
SEE SHEETS 40-45 OF 406.


CONTROL OF ACCESS IS COMPLETE ON THIS SHEET

WDOE to State of Vt
From Robert A. Townsend
dated 11/2/85 BK 43 Pg 421,422
FEB 05 1986

RIGHT-OF-WAY DIVISION
TOWN FILE

PERPETUAL
Town of Brookfield T 89
(To Be Returned To .O.W. PLAN SCALE 1/4")
MM 3940

STAGE 2 CONSTRUCTION
BROOKFIELD-WILLIAMSTOWN
BERLIN
I 89-1 (11) (29)
CONTRACT No. 1
SHEET 36 OF 406
77 263

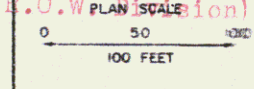

19-B

18