


DELETED STAGE 2 ITEMS
 Slope: Full For Slope
 Protection: Light Type
 Date: 5/14
 SB 2200+50-2221+50 LT

Plan: 50' x 10'
 1" = 100'
 NH 2225+65 TO 241 F

STA	ST1	POS
2218+00	2232+05	RT
2218+00	2232+05	LT

Direct Summary of Soil Tests (See 224-14)
 2218+00 - 2222+00
 2218+00 - 2224+00

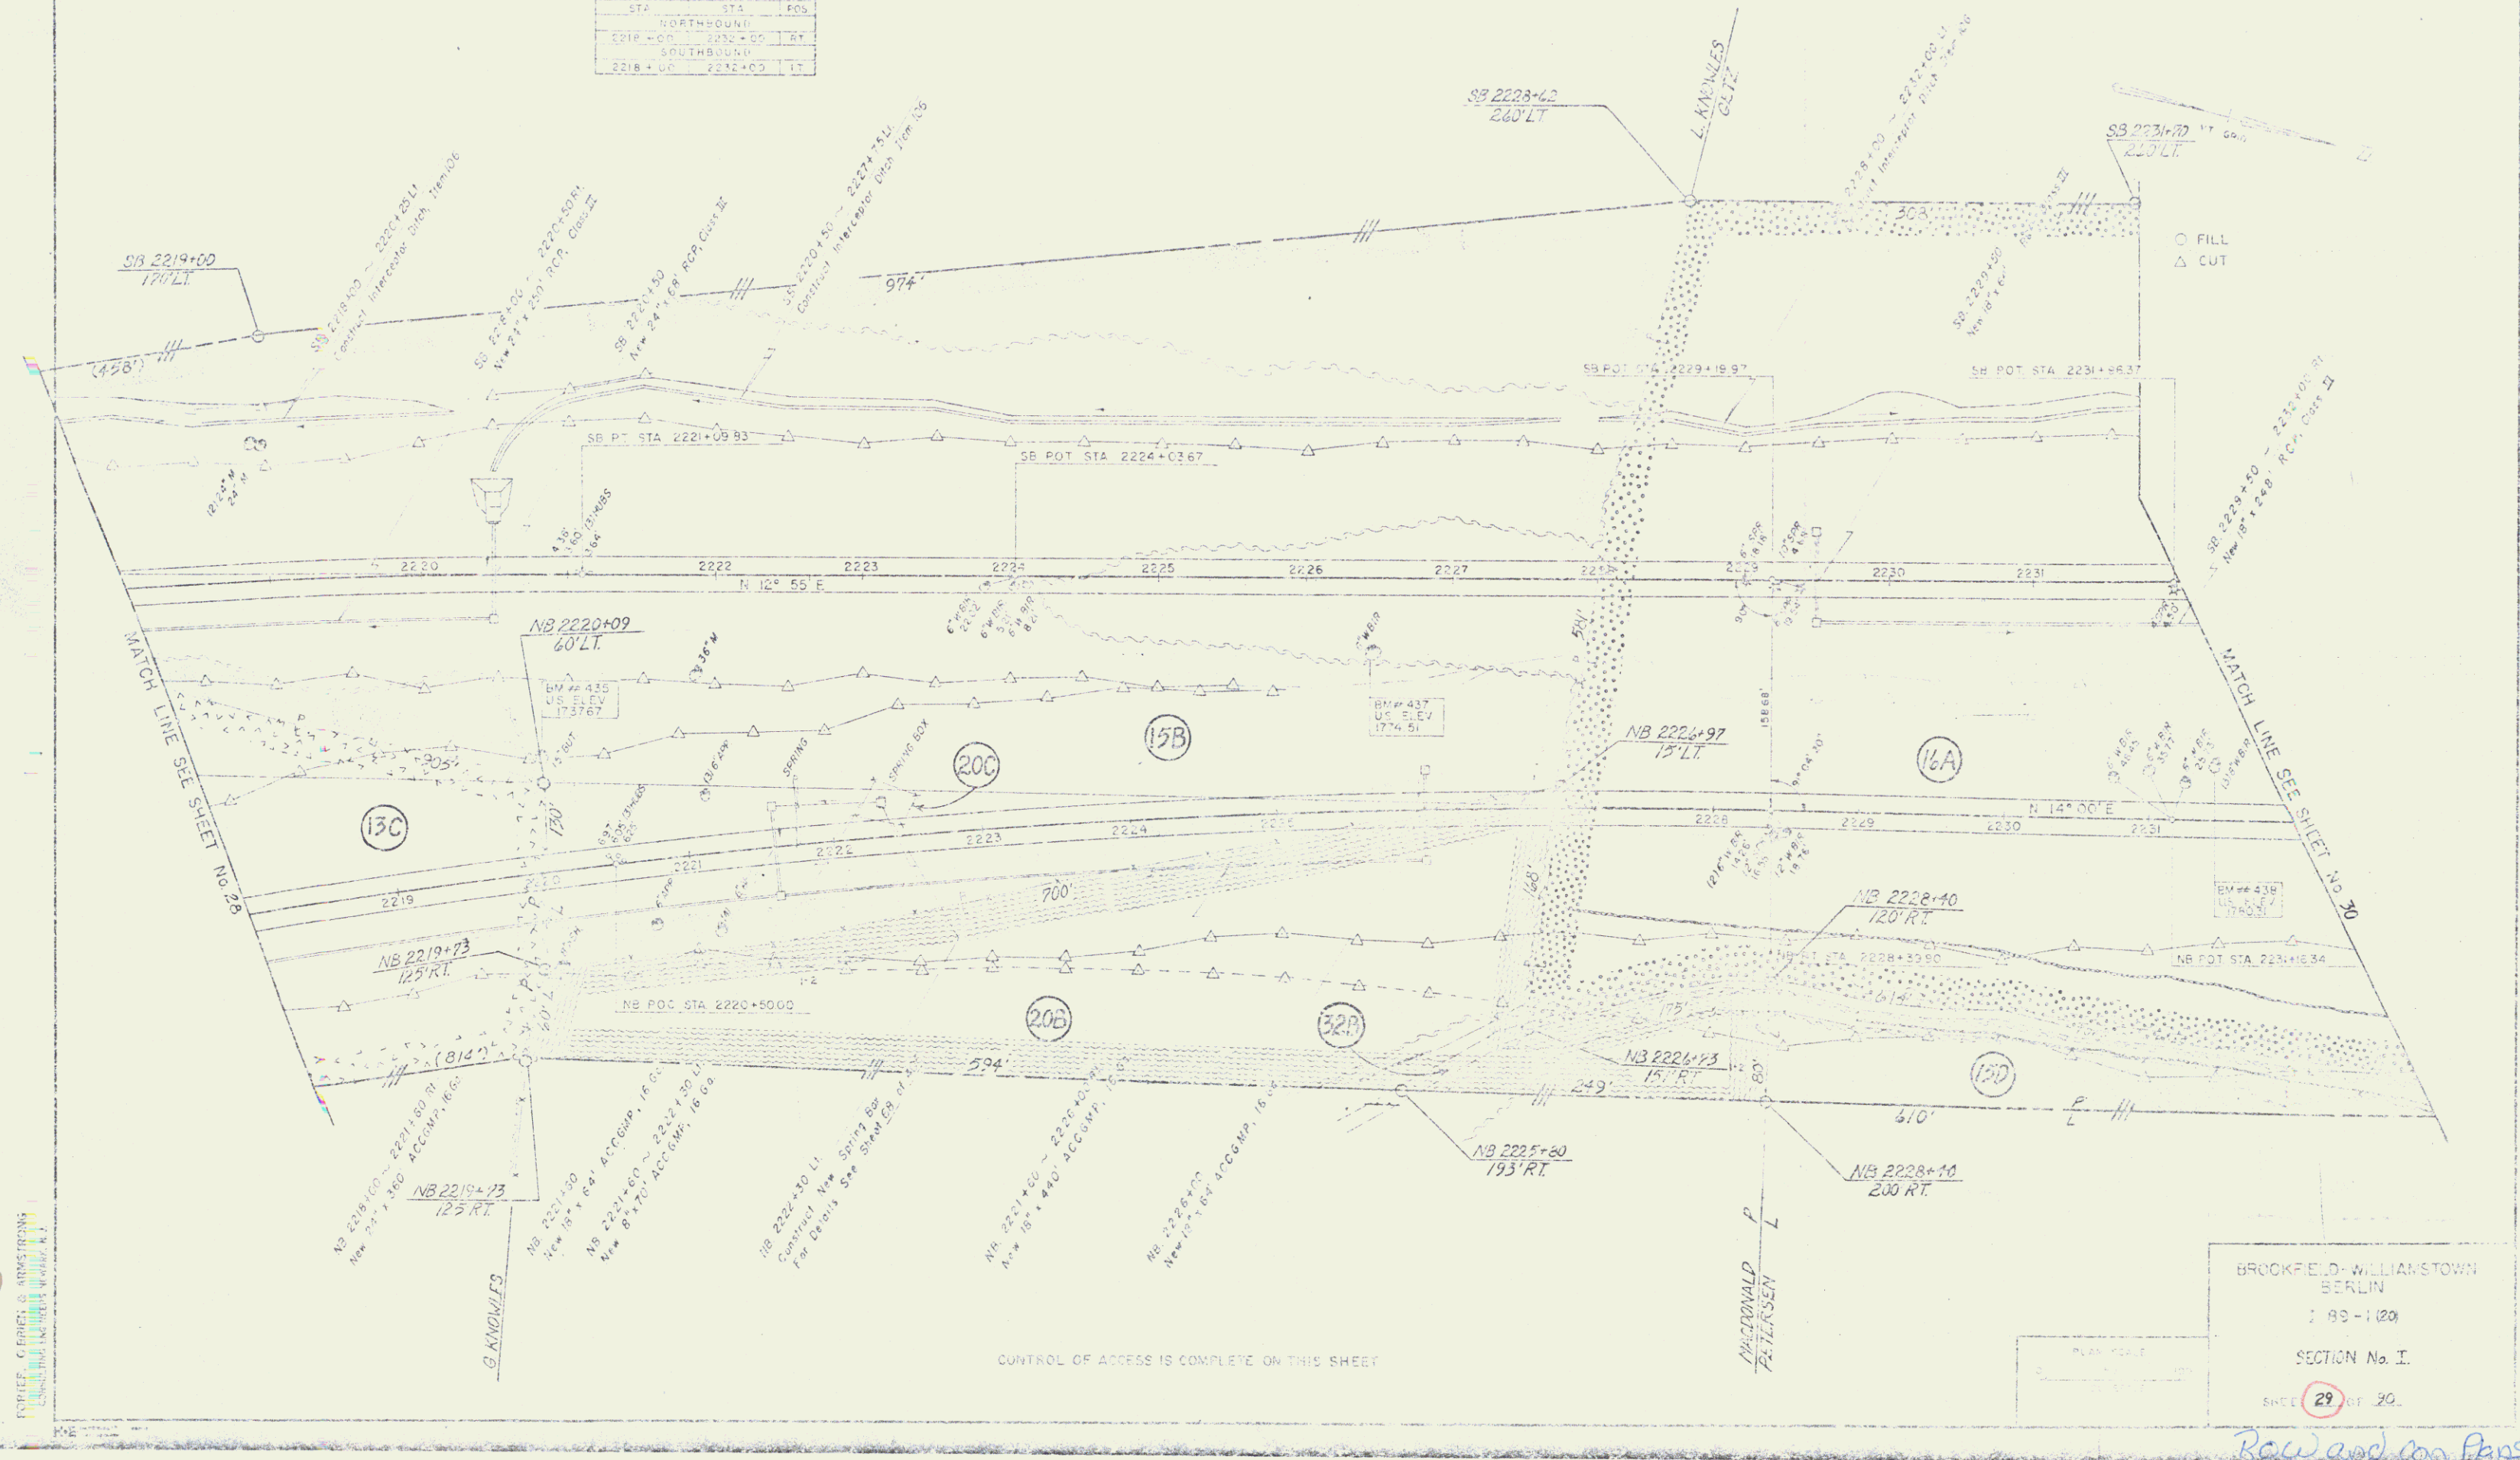

CONTROL OF ACCESS IS COMPLETE ON THIS SHEET

BROCKFIELD-WILLIAMSTOWN
 BERLIN
 195-100
 SECTION No. I
 SHEET 29 OF 30

Raw and on Plans
 29