


# DENOTES STAGE 2 ITEMS  
 Stone Pin For Slope  
 Protection (Light Type)  
 Item 612  
 SB 2233+50-2234+00 LT

Plan: Road Rail  
 Item 542  
 No. 2234+75 RR 4OLF

PROPERTY LINE FENCE WITH STEEL POSTS ITEM 587-2 R.F.E.		
Sta.	Dist.	Notes
2234+00	100	NORTHBOUND
2234+00	100	SOUTHBOUND
2237+00	100	LT

Dist. to center of Road from center of line of  
 SB 2233+50-2234+00  
 SB 2234+00-2235+00  
 SB 2235+00-2236+00  
 SB 2236+00-2237+00

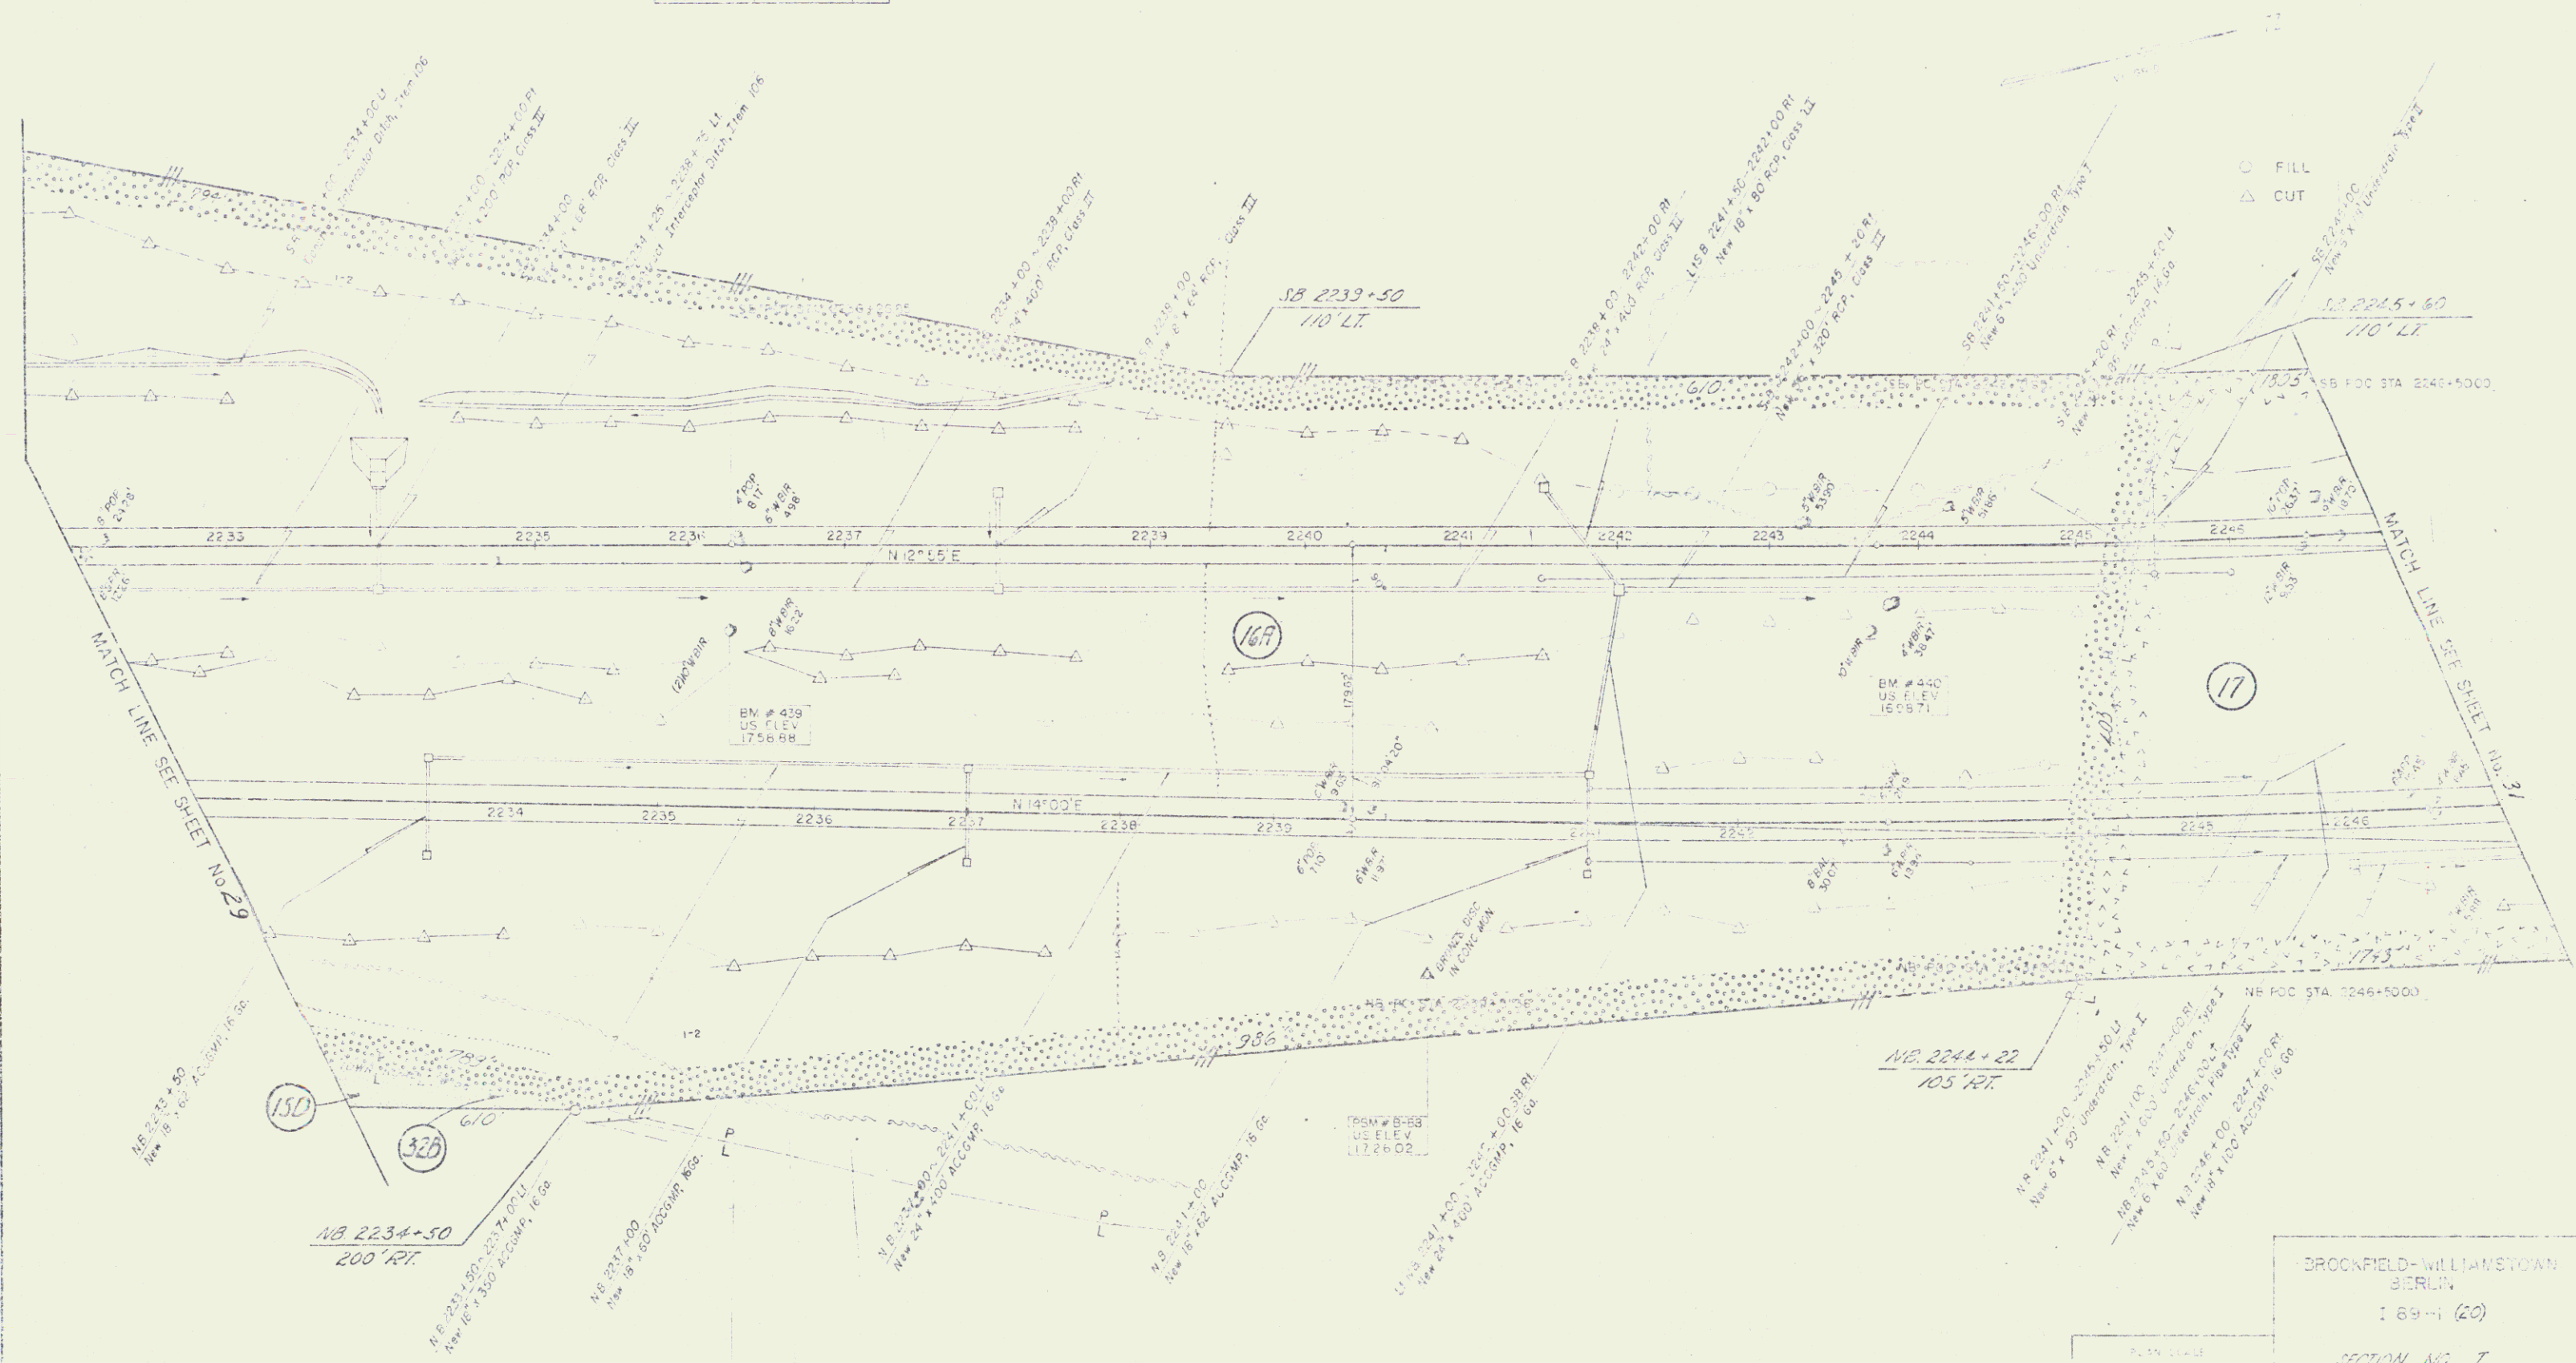

CONTROL OF ACCESS IS COMPLETE ON THIS SHEET

BROCKFIELD-WILLIAMSTOWN  
 BERLIN  
 1 69-1 (20)  
 SECTION NO. I  
 SHEET 30 OF 30

*Bein. Plan. Plans*