

DENVIES STAGE 2 ITEMS

1. Stone 1" for Scale  
 Horizontal (1" = 100')  
 Vertical (1" = 10')

2. Tapes (Leica) used  
 W/100' & 50'

3. Standard steel beam level used  
 SIKKA 54214  
 NB 2265+30 - 2267+50 (I)

4. Distances between  
 points  
 NB 2271+00 - 2268+00 LT  
 NB 2271+00 - 2270+00 LT  
 SB 2268+00 - 2269+00 RT  
 SB 2270+00 - 2271+00 LT  
 SB 2271+00 - 2272+00 LT

STA	STA	PC
2265+00	2272+00	LT

NORTHMOGARD  
 2265+00 - 2272+00  
 2265+00 - 2272+00 LT




MATCH LINE SEE SHEET No. 31

MATCH LINE SEE SHEET No. 35

POSTER, GIBBON & ASSOCIATES  
INCORPORATED  
1000 PARKWAY DRIVE  
SPRINGFIELD, N.J.

CONTROL OF ACCESS IS COMPLETE ON THIS SHEET

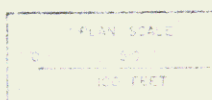

BROOKFIELD-WILLIAMSTOWN  
 BERLIN  
 1 83-1 (20)  
 SECTION NO. I  
 SHEET 32 OF 30

Row & Ben Plans