


* DENOTES STAGE 2 ITEMS

* Three Cable Guard Rail
w/Steel Posts
Item 582
SB 2311+50-2320+00 LT

* Date Mailing
12/11/13
* NB 2314+00-2316+00 RT
* SB 2314+00-2316+00 LT
* SB 2314+00-2316+00 RT
* SB 2314+00-2316+00 LT
* SB 2314+00-2316+00 RT
* SB 2314+00-2316+00 LT
* SB 2314+00-2316+00 RT
* SB 2314+00-2316+00 LT
* SB 2314+00-2316+00 RT

Drilling Log existing of Road Rock Subgrade, Item 115
NB 2315+00-2316+00
SB 2305+00-2320+00

PROPERTY LINE FENCE WITH STEEL POSTS ITEM 583-2 MOD.			
STA	STA	PGS	
2305+00	2316+00	RT	
SOUTHBOUND			
RAMP "C" 2318	RAMP "C" 5+95	RT	

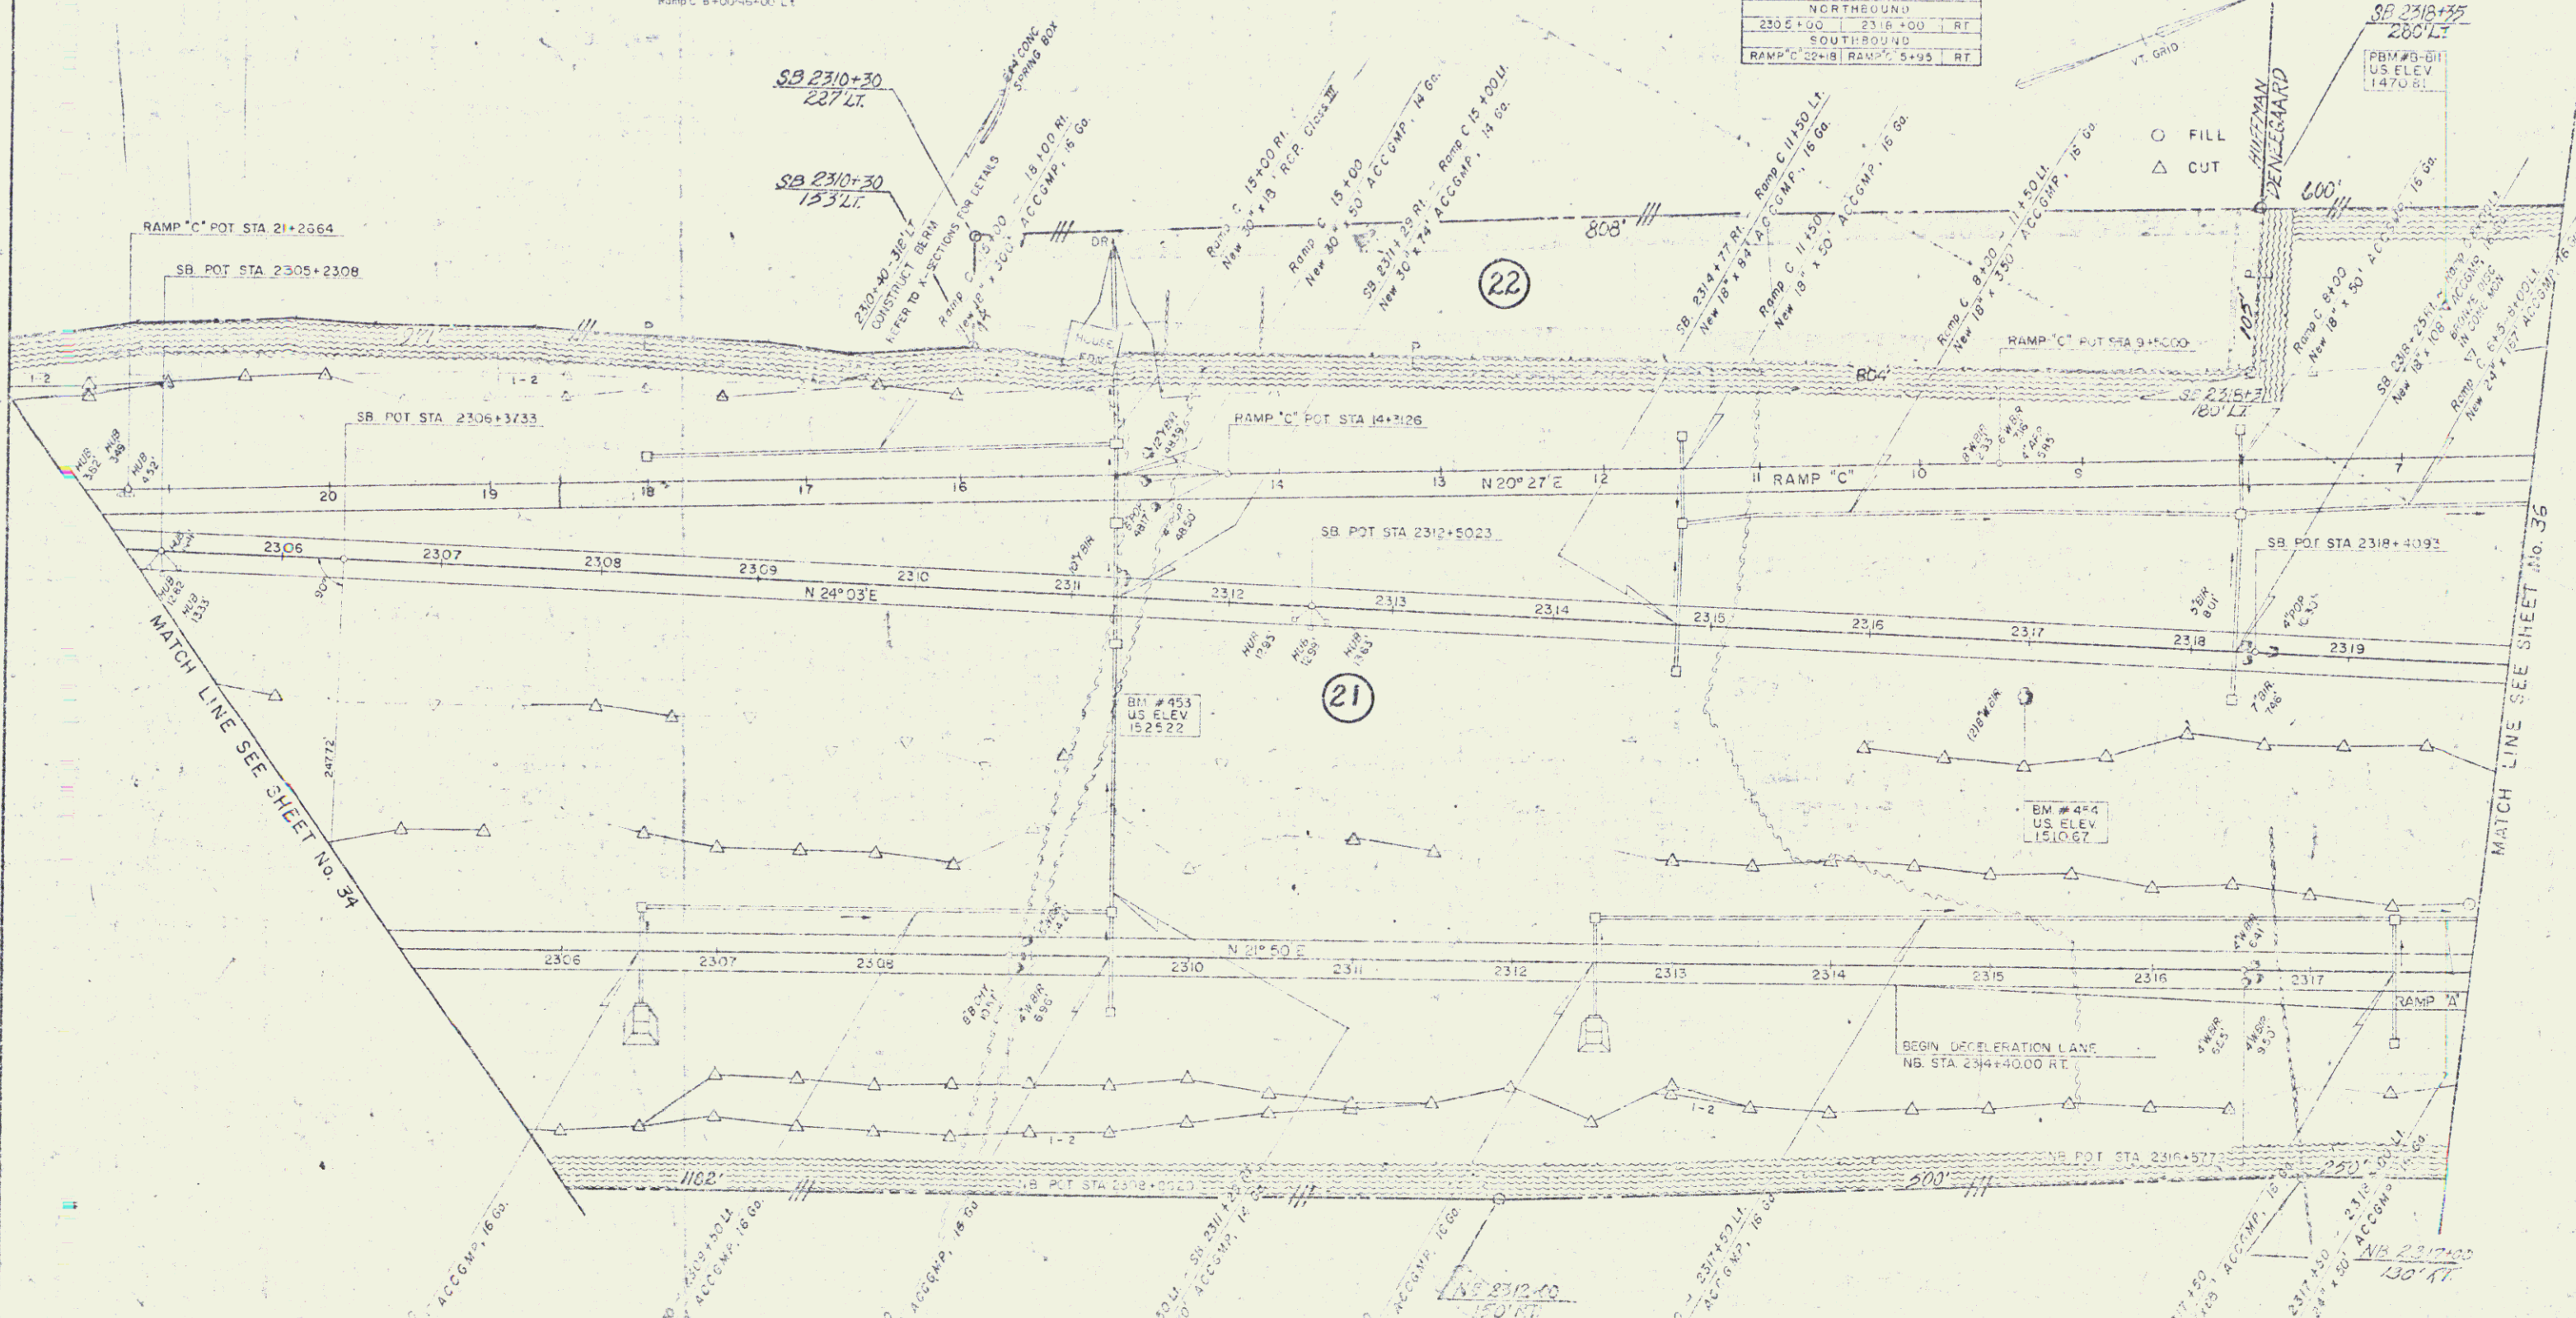

W. O'NEIL & ARMSTRONG
1000 FARM ROAD, WESTBORO, MA 01581

BROOKFIELD-WILLIAMSTOWN
BERLIN
180-184
SECTION NO. 2
35 90